

REPORT

Temple Gate MSCP Life Care Plan

Prepared for

Bristol City Council

April 2018



Burderop Park
Swindon, SN4 0QD
GB
+44 1793 812 479
+44 1793 812 089



Contents

Section	Page
Acronyms and Abbreviations.....	v
Executive Summary.....	1-1
1.1 Scope.....	1-1
1.2 Condition Survey and Structural Investigation	1-1
1.3 Structural Appraisal	1-1
1.4 List of Actions.....	1-2
Introduction.....	2-1
2.1 Background	2-1
2.2 Scope.....	2-1
2.3 Requirements of the ICE Guidelines	2-2
Description of the Structure	3-1
3.1 Orientation.....	3-1
3.2 Components and arrangement.....	3-1
Initial Appraisal.....	4-1
4.1 Drawings	4-1
4.2 Asbestos Report 2013 (8/2/2013)	4-1
4.3 Asbestos Re-Inspection Survey Report (6/7/2017)	4-1
4.4 Gaps in the information.....	4-2
4.5 Information generated in this commission.....	4-2
4.5.1 Drawings	4-2
4.5.2 Test data	4-2
4.5.3 Digital images.....	4-3
Condition Survey.....	5-1
5.1 Approach.....	5-1
5.2 Structural frame.....	5-1
5.2.1 Columns and beams.....	5-1
5.2.2 Walls	5-1
5.2.3 Ground bearing slabs.....	5-3
5.2.4 Suspended slabs.....	5-3
5.3 Stairwells.....	5-3
5.3.1 Concrete stair units.....	5-3
5.3.2 Facades	5-3
5.3.3 Stair tower roofs	5-4
5.4 Foundations	5-6
5.5 Edge protection.....	5-6
5.6 Drainage.....	5-7
5.7 Lift motor room.....	5-7
5.8 Entry / Exit layout / visibility for new POF system.....	5-7
5.9 Retaining secure parking	5-8
5.9.1 Vehicle gate	5-8
5.9.2 Pedestrian access.....	5-8
5.10 Removal of existing shutters to each deck	5-9
5.11 Aesthetic upgrade of external elevations.....	5-9
5.12 Limitations of current layout	5-9
Structural Investigation	6-1
6.1 Approach.....	6-1

Section	Page
6.2	Record of defects 6-2
6.2.1	Visual and Hammer Tap Survey 6-2
6.3	Reinforcement and cover 6-3
6.3.1	Cover Meter Survey 6-3
6.3.2	Concrete Breakouts 6-3
6.4	Carbonation, chlorides and strength 6-4
6.4.1	Carbonation Depth 6-4
6.4.2	Chloride Ion content of the decks 6-5
6.4.3	Core Sampling 6-5
6.5	Discussion of main findings..... 6-6
6.5.1	Cover and protection to reinforcement 6-6
6.5.2	Chlorides and deck reinforcement 6-6
Structural Appraisal 7-1	
7.1	Details of Appraisal 7-1
7.2	Basis of the Original Design 7-1
7.3	Investigation Work..... 7-1
7.4	Analysis 7-2
7.4.1	Application of load to elements..... 7-3
7.4.2	Capacity of elements 7-3
7.4.3	Longitudinal beams over end turning areas 7-4
7.4.4	Columns between deck floors 7-4
7.5	Progressive Collapse 7-5
7.6	Conclusion and Recommendations 7-5
Life-care Recommendations 8-1	
8.1	The Plan 8-1
8.2	Routine Inspections 8-1
8.3	Condition Surveys 8-1
8.4	Structural Appraisals..... 8-1
8.5	Record Keeping 8-1
8.6	Maintenance Schedule 8-3
8.6.1	Reinforcement Corrosion 8-3
8.6.2	Masonry 8-3
8.6.3	Edge protection 8-3
8.6.4	Stairwell facades 8-3
8.6.5	Summary of Actions..... 8-3
8.7	Maintenance options..... 8-5
Appendix(ixes)	
Appendix A - Drawings	
Appendix B – Test certificates	

Acronyms and Abbreviations

RC	Reinforced concrete
ICE	The Institution of Civil Engineers
LCP	Life Care Plan
BCC	Bristol City Council
BRE	Building Research Establishment
ASTM	American Society for Testing and Materials
UKAS	United Kingdom Accreditation Service
ASR	Alkali Silica Reaction
AAR	Alkali Aggregate Reaction
ACM	Asbestos Containing Materials

Executive Summary

1.1 Scope

This report details the inspection and assessment of the structure and fabric of Temple Gate MSCP in the centre of Bristol, in accordance with the Institution of Civil Engineers report 'Recommendations for the inspection, maintenance and management of car park structures, 2002'. The works were undertaken cognisant of BCC's aspiration of modernising the car park and implementing a pay on foot (POF) system.

The elements of this work included the following:

- An Initial Appraisal involving a review of archive material to assess in-situ construction details and previous inspection reports;
- Condition Survey and Structural Investigation which included site and laboratory testing of the concrete elements characterise properties and condition;
- Structural Appraisal - an evaluation of the structure via desk study and calculations;
- Recommendations for prioritised remedial actions and maintenance works; and
- Recommended inspections, assessments and maintenance regimes.

This report provides recommendations for the immediate actions (Table 1.1), and sets out further analysis that is required to optimise the future management of, and expenditure on this structure.

The regimes for daily surveillance, routine inspections, special inspections and appraisals, including maintenance and repair guidelines, are set out in Table 8.1 of this report.

1.2 Condition Survey and Structural Investigation

The main high and medium priority defects and actions noted were:

- Missing (failed) blockwork along the perimeter elevation, requiring further investigation of the remaining cavity walls and repair of the sections with missing blockwork.
- Inadequate vehicle and pedestrian barriers, requiring replacement to meet modern code requirements.
- Stair/lift tower glazing systems extensively deteriorated and in need of substantial refurbishment and repair.
- Spalling to the concrete deck and soffit, resulting primarily from chloride-induced reinforcement corrosion, and requiring repair and future enhanced protection.

It is noted that the layout of the structure places restrictions on the dimensions available for parking and circulation, which could significantly impact POF operation, and further consideration is required prior to significant works and investment.

1.3 Structural Appraisal

Based on limited analysis, it is concluded that there are some areas where the capacity of the frame and decks are not proven to be as large as would be expected. Without further analysis and or investigation works it is not yet clear if the structure is inadequate for the anticipated full design load, or whether insufficient investigation has been undertaken to identify all the reinforcing bars in the beams, columns and slabs. Further investigation into the columns and slabs is recommended.

1.4 List of Actions

A complete list of recommendations is included in Section 8.6.5. High priority works, as identified by BCC in March 2018 are given in Table 1.1. These are based on a pragmatic ‘maintain and repair’ approach, with a view to attaining a further 10-year service life, described as Option B in Section 8.7.

TABLE 1.1
Summary of Actions for Maintenance Option B

Item	Priority	Maintenance action	Cost (£)
1	High	Investigations to determine the stability and condition of the South elevation infill blockwork masonry walls [no allowance for repairs]. Access cost included.	£7,000
2	High	Repair of the southwest elevation infill blockwork masonry walls. Access cost included.	£33,000
3	High	Install additional handrailing to stairwells	£5,000
4	High	Refurbishment of Staircase A glazing system (entrance elevation)	£19,000
5	High	Refurbishment of Staircase B glazing system (rear elevation)	£13,000
6	High	Perimeter barriers	£189,364
7	High	Internal Barriers	£67,574
8	High	Refurbishment of Staircase A concrete cladding (entrance elevation)	£12,000
9	High	Refurbishment of Staircase B concrete cladding (rear elevation)	£7,000
10	High	Deck concrete repairs	£13,392
11	High	Soffit & upstand concrete repairs	£9,730
12	High	Elevation concrete repairs	£2,575
13	Medium	Replacement of roofing material to staircases and lift core roofs	£4,000
Total			382,635

Notes: BCC denotes the action urgency is to be set by BCC. For 10-year operation, all High priority actions should be implemented.

2.1 Background

CH2M HILL/Jacobs was appointed by Bristol City Council (BCC) to undertake a study to provide the necessary baseline information and determine the maintenance and inspection requirements of the structure and fabric for the Temple Gate MSCP, to allow the development of a Life Care Plan (LCP).

In 2017, there were plans to introduce a pay on foot (POF) system. By March 2018 BCC had decided to introduce 'pay and display' type parking instead of POF. The existing contract parking is to be relocated to the upper decks. The 'pay & display' car park at ground level will remain as such.

A survey of the current condition of the infrastructure was required to help preserve and enhance safety, functionality and future revenue, and identify and address any related health and safety concerns. Of particular concern to BCC is identification of failures of the structure, including spalling, pot holes and any other risks to customers / the general public, and managing the risk of closure due to structural defects. BCC also wishes to introduce additional CCTV, paint the stairwells and have proprietary coatings for the decks, lift lobbies and stairs. The overall purpose of this commission is to assess current condition and identify, specify, and supervise works to be undertaken by others in order to meet BCC's aspirations.

2.2 Scope

The scope of the study was in accordance with the guidance detailed in the Institution of Civil Engineers (ICE) publication titled "Recommendations for the inspection, maintenance and management of car park structures", first published in 2002. This is summarised in Section 2.3.

Based on the Initial Appraisal, Condition Survey, Structural Investigation and Structural Appraisal, recommended actions in terms of remedial works, further inspection and assessment have been established to enable the management of the structure in accordance within the ICE Guidelines.

These works were initiated with on-site visual inspection for the Condition Survey and intrusive testing and sampling for the Structural Investigation.

This document presents the necessary information to form a LCP for Temple Gate MSCP.

The scope includes the inspection and proposals for the following items:

- Concrete Condition (Ceilings, ramps, decks, pillars, stairwells, walls)
- Drainage
- Curtain wall glazing (Southern stairwell)
- Crash Barriers
- Entry / Exit layout / visibility (suitability for new POF system)
- Deck Surfaces
- Relocation of secure gate / installation of new gate for top deck
- Removal of existing shutters to each deck
- Hand rails within stairwells
- Lift motor room structure
- Aesthetic upgrade of external elevations

Excluded are:

- Electrics
- Toilets
- Topographic, surface & soffit levels survey

2.3 Requirements of the ICE Guidelines

The requirements detailed in the ICE Guidelines clearly sets out the responsibilities of the asset owner/operator in terms of maintaining their structure in a safe and serviceable condition.

The Guidelines set out how this can be achieved in a process called Life-care planning. One of the key aspects of this process is ensuring that the safety and serviceability of the structure is verifiable and that evidence of this action is contained in a specific file relating to that facility.

The Guidelines state that the development of a Life-care Plan is based upon a review of the existing records of previous maintenance and repair works, inspection reports and structural appraisals. It is stated that the plan should identify the need for immediate actions and plan for scheduled actions such as further surveillance, inspection or repair, as necessary to implement the overall plan. In this manner, the risks posed by aging structures can be properly managed and major disruption through un-planned emergency repair works is avoided.

The document also recommends that the Owner/Operator of the asset should appoint an experienced Chartered Engineer to advise on structural safety, inspection and maintenance of each existing structure.

The ICE Guidelines introduces specific terms and actions which are used in this report. These are as follows:

Initial Appraisal

The Initial Appraisal is centred upon checking existing records for completeness and detailing specific needs in terms of further inspection and maintenance by a desk study of records prior to the Condition Survey.

Condition Survey

The Condition Survey is a detailed visual examination of the structure to identify structural form, general material condition and to identify areas worthy of further examination.

Structural Investigation

The findings of the Condition Survey are used to plan the Structural Investigation, which is aimed at deriving the material condition at specific structurally vulnerable positions and/or to record parameters such as cover, carbonation depth, chloride contamination, material strength and reinforcement corrosion activity.

Structural Appraisal

A Structural Appraisal considers the integrity of the asset in terms of its residual load capacity, particularly at vulnerable positions which may exist as a result of inadequate design, inappropriate repair or material deterioration. This appraisal should address the main structure as well as the adequacy of edge barriers.

Maintenance and Repair

The need for Maintenance and Repair will stem from the previous surveys, inspections and appraisals and should be planned and executed in a timely manner, ensuring a solution that is both affordable to the client and correct for the extent of deterioration encountered.

Typical recommendations for the content of the LCP is detailed below although this may need amendment depending on the individual circumstances, and upon the recommendations of the Engineer,

- Daily Surveillance, usually by operations staff
- Routine Inspections, typically every 6 months
- Periodic Initial Appraisal and Condition Survey of key components, including cladding and edge protection, prompting Special Inspections as required at intervals of less than 8 years
- Structural Appraisal at intervals of not more than 16 years¹

Maintenance and repair works are carried out as circumstances dictate as and when instructed by the Owner/Operator, including routine and protective/preventive works and the recording thereof.

¹ IICE, 2002 footnote 'd' given below Table 5.1 on Page 14 states that 'Shorter intervals than the maximum values given are likely to be appropriate. The Engineer should advise the Owner/Operator taking into account the condition of the car park structure and the defects known to be present'. Given the age and current condition of Temple Gate MSCP 5 years and 10 years are deemed appropriate for the condition surveys and structural appraisals respectively.

Description of the Structure

3.1 Orientation

Temple Gate MSCP lies with its long axis running in a North West to South East orientation. For the purposes of this report the elevations are distinguished as follows:

- Northeast elevation – facing the Holiday Inn, and Temple Meads Station beyond.
- Southeast elevation – facing the rear of the Peugeot garage (and parallel to the River Avon).
- Southwest elevation – facing Chatterton Square, and Somerset Street beyond.
- Northwest elevation – facing the Derelict petrol station, and Redcliffe Way beyond.

Plans and elevations are provided in Appendix A.

3.2 Components and arrangement

Temple Gate Multi Storey Car Park is a 7-storey car park believed to date from the late 1960's or early 1970's; the date of construction is not known. It currently has a secure entrance / exit gate at the southeast elevation, as, above ground level, it is used for contract parking only. The southwest 'half' of the ground floor is 'pay & display' public car park, with a ground-bearing, horizontal concrete floor. Above this level, Temple Gate is of in-situ integral reinforced concrete construction, with some infill cavity walling along the long elevations. The floor slabs are inclined and form the ramps between levels, with a split level arrangement, with a horizontal strip at the northwest and southeast ends forming the turning areas. Therefore the northeast half of the 'ground floor' is actually the ramp rising up to Level 1.

There are 2 stair towers and a lift shaft adjacent to the main stair tower. These comprise reinforced concrete frames with glazed and concrete facades. The stairwell doors were being re-furbished in early 2018.

For the most part, the soffits, columns and interior walls are painted and the decks are bare, with the exception of the exposed top deck. A vehicle and pedestrian restraint system is provided throughout the car park.

Security gratings have been installed to the open sections of the elevations at Ground and First floor levels.

The Initial Appraisal comprises a desk study of the existing available records. All documents relating to the Temple Gate MSCP were collated by BCC and subsequently reviewed by CH2M HILL/Jacobs and are summarised in the following sections (in date order).

4.1 Drawings

The following drawings were supplied by BCC for information:

Hydrock Drawing C/232/015 TempleGate Car Park, Templemeads, Bristol: Elevations, 9/12/97

Hydrock Drawing C/232/007 TempleGate Multi storey, Temple Meads, Bristol: Ground Floor Plan, 9/12/97

Hydrock Drawing C/232/008 TempleGate Car Park, Templemeads, Bristol: Level One, 9/12/97

Hydrock Drawing C/232/009 TempleGate Car Park, Templemeads, Bristol: Level Two, 9/12/97

Hydrock Drawing C/232/010 TempleGate Car Park, Templemeads, Bristol: Level Three, 9/12/97

Hydrock Drawing C/232/011 TempleGate Car Park, Templemeads, Bristol: Level Four, 9/12/97

Hydrock Drawing C/232/012 TempleGate Car Park, Templemeads, Bristol: Level Five, Draft, 9/12/97

Hydrock Drawing C/232/013 TempleGate Car Park, Templemeads, Bristol: Level Six, Draft, 9/12/97

Hydrock Drawing C/232/014 TempleGate Car Park, Templemeads, Bristol: Level Seven, 9/12/97

The Hydrock drawings are not original design or as-built drawings.

4.2 Asbestos Report 2013 (8/2/2013)

A management survey was undertaken at the car park to identify asbestos containing materials (ACM) by MSS Consulting Ltd in February 2013. A Management Survey is defined in HSG 264 'Asbestos: The Survey Guide' as a 'Standard Survey' to locate and assess any suspect ACMs for the purpose of managing asbestos within the building.

The electrical switchgear and the fire hydrant box were not inspected along with the lift shaft.

Asbestos was identified in the survey. Debris on the floor and wall in the Temple Gate ground floor storage cage contained asbestos. A dry riser gasket on the ground floor stair well was also found to contain asbestos.

4.3 Asbestos Re-Inspection Survey Report (6/7/2017)

In July 2017 a further asbestos survey was undertaken by MSS Consulting Ltd. A re-inspection of all previously identified asbestos inclusions to assess the current condition and undertake a Material Risk and Priority Assessment in accordance with HSG264 and HSG 227.

The lift shaft was not inspected. Asbestos was identified in the survey. Debris on the floor and wall in the storage cage contained asbestos. Asbestos was found in the electrical distribution adjacent to the storage area in a cable race. A dry riser gasket on the ground floor stair well was also found to contain asbestos.

As most lift brakes produced up until about 2004 contained asbestos the asbestos survey / report for the car park shall be reviewed and an assessment made of whether there is the potential for asbestos or ACM (asbestos containing material) forming part of the lift motor room or equipment.

4.4 Gaps in the information

The original as built drawings and structural design calculations were not available for review. No information was available from construction of the car park until 2013 when an asbestos survey was undertaken. It is not clear what work and studies were undertaken during the period.

4.5 Information generated in this commission

4.5.1 Drawings

Plans and elevations of the car park have been developed by CH2M based on the 1997 Hydrock drawings. Locations of defects in the reinforced concrete components have been marked on these, are provided in Appendix A, and include the following:

- 673846-TG- 101 Temple Gate Ground Floor Staircase Defects
- 673846-TG- 102 Temple Gate Ground Floor Defects
- 673846-TG- 103 Temple Gate Level 1 Staircase Defects
- 673846-TG- 104 Temple Gate Level 1 Defects
- 673846-TG- 105 Temple Gate Level 2 Staircase Defects
- 673846-TG- 106 Temple Gate Level 2 Defects
- 673846-TG- 107 Temple Gate Level 3 Staircase Defects
- 673846-TG—108 Temple Gate Level 3 Defects
- 673846-TG- 109 Temple Gate Level 4 Staircase Defects
- 673846-TG- 110 Temple Gate Level 4 Defects
- 673846-TG- 111 Temple Gate Level 5 Staircase Defects
- 673846-TG- 112 Temple Gate Level 5 Defects
- 673846-TG- 113 Temple Gate Level 6 Staircase Defects
- 673846-TG- 114 Temple Gate Level 6 Defects
- 673846-TG- 115 Temple Gate Level 7 Staircase Defects
- 673846-TG- 116 Temple Gate Level 7 Defects
- 673846-TG- 117 Temple Gate South and East Elevations
- 673846-TG-118 Temple Gate North (East & West) and West Elevations

4.5.2 Test data

Information from the site investigation includes chloride test data, reinforcement scans (using radar), carbonation depth and compressive strength measurements. These are included in Appendix B.

4.5.3 Digital images

There are also a series of digital images and digital video files which illustrate condition resulting from the inspections undertaken by CH2M. These are not included but are available to BCC on request.

SECTION 5

Condition Survey

5.1 Approach

The condition survey involved a visual inspection using the plans and elevations of the car park to assist in recording defects. All works were undertaken by a team of at least two inspectors. The following sections provide a summary of the features and conditions found in 2017/8, and are presented by structural component or part or by the functional activity required.

5.2 Structural frame

5.2.1 Columns and beams

There are four lines of columns in the northwest/southeast orientation, spaced at approximately 4.85m centres. These support a total of 12no. beams (spanning transversely, northeast/ southwest) at each level. The beam/column connection at the turning areas at the far ends of each level are slightly more complex due to the off-set levels and arrangement of the longitudinal and transverse beams.

The columns and beams are painted white (see Figure 5-1). The coating is typically in good condition. There are a small number of defect in the beams and columns that relate to, or appear to relate to corrosion of embedded reinforcement. However, there is no evidence of distortion or significant structural damage.



Figure 5-1. Structural arrangement

Typical slab, column, beam, soffit and wall arrangement

5.2.2 Walls

There are lightweight concrete blockwork infill walls to the northeast and southwest elevations. These are likely to have been intended to add to the structural rigidity (i.e. shear resistance) of the structure. The walls are full height (floor to ceiling), and span between the columns and the car park slabs. They are of cavity construction, and were probably intended to be held together with cavity ties.

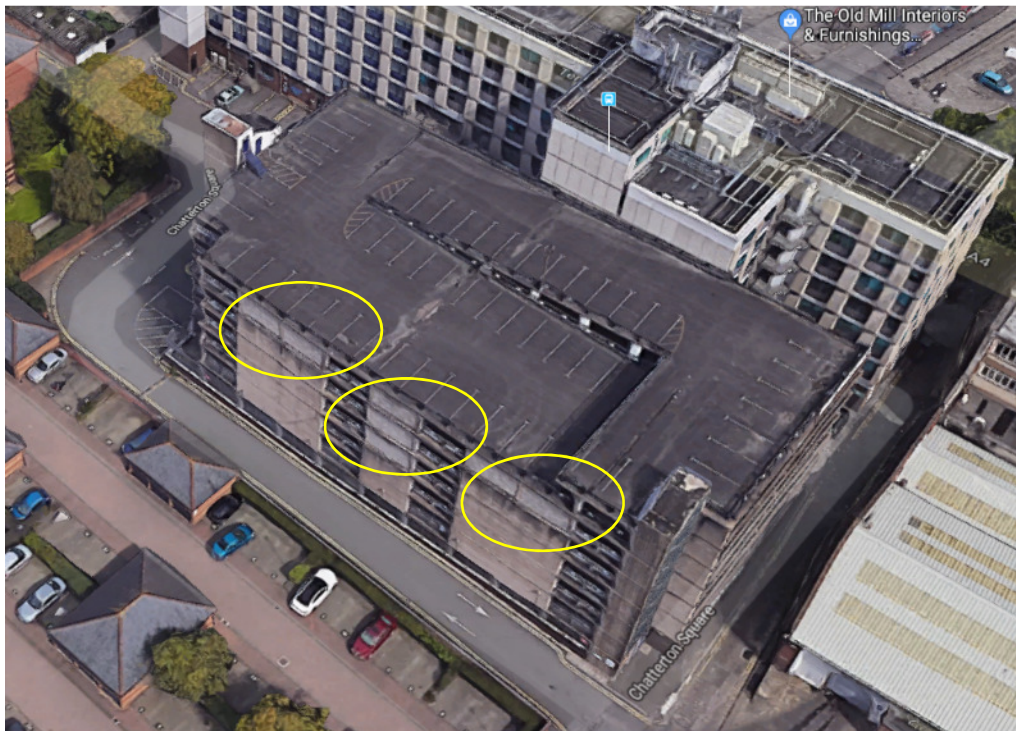


Figure 5-2 Infill walls
Southwest Elevation Infill Walls (Missing Outer Leafs Ringed)

To several sections of the infill wall at the upper levels, parts of the outer leafs are missing (see Figure 5-2) and the inner leafs are clearly damp stained. We suspect that corrosion of the cavity ties (where present) may be taking place, which if correct, would likely continue to the remainder of the elevations and hence a risk that requires further investigation.

There is also concern that falling masonry might occur at any time. In light of this, we recommend urgent inspection, using a scaffolding tower, to properly examine the walls for defect and stability. It will also aid the preparation of the specification for remedial works required.

If the walls are found to require replacement, this could present an opportunity to re-clad the elevation with a maintenance-free cladding system such as those shown in Figure 5-3. These would of course incorporate suitable framework to provide the shear resistance required, but with an improved and relatively maintenance-free external appearance.



Figure 5-3 Cladding
Examples of maintenance-free cladding systems on the market to replace the deteriorating infill walls to the South Elevation

Elsewhere at high level, heavy soiling and staining is evident, caused by the lack of a suitable drip detail, which is allowing surface water run-off, and to some extent atmospheric pollution, to run down the face of the walls.

The lower aprons of the elevations are clad with cavity masonry incorporating brickwork outer leafs. Local but minor damage to the brickwork is evident, in addition to deterioration of the pointing in areas.

5.2.3 Ground bearing slabs

Part of the ground floor split level is a ground bearing slab. Spalling to the concrete surface was found during the inspection, which appeared to result from corrosion of reinforcement bars. Whilst there is no significant risk of structurally significant deterioration, these defects pose a trip hazard which can be expected to become progressively worse and more abundant without treatment.

5.2.4 Suspended slabs

Most of the slabs in the car park are supported by the beams, and the slab depth (175mm) can be viewed from within the car park at each split-level. The short spans between beams are approximately 4.85m. There are two longer spans across the aisles and parking bays, each of over 11m span, and a short span at the southwest elevation spanning parking bays only) of under 5m.

The appearance of the top surfaces at each floor are as-expected for a multi-storey car park of this age, with a significant amount of texture remaining from the original concrete construction, plus abundant evidence of road grime, oil and tyre markings. The white lining (delineating turning circles and parking bays) are typically worn.

The condition of the concrete is generally good, but there is some cracking and spalling in the top surface, mostly at Ground level, Level 1 and to a lesser extent Level 2. Only 8% of the total surface area of defects to the deck upper surface occur above Level 2. These defects appear to relate to corrosion of embedded reinforcement.

There are also similar corrosion-related defects to the bottom surface of the slabs (i.e. the soffits). These are often associated with cold joints in the concrete, which appear to be a preferred pathway for moisture to penetrate the slabs.

5.3 Stairwells

5.3.1 Concrete stair units

The stairs are of pre-cast concrete design, resting on the car park framework at each floor level. They incorporate yellow non-slip nosings, screw fixed to the goings (steps).

Where the landings abut the staircase walls, they are sealed and the landings generally painted. Along the stringers (sides) of the staircases, they do not abut the perimeter walls, allowing cleaning surface water and the like to cascade over and onto the staircase glazing and walls, causing premature deterioration of the steel frames and beams that support the glazing systems. It would be prudent to review this design and perhaps allow for edge protection to the exposed stringers to limit future soiling and corrosion.

In addition to the above, it would be beneficial, from a cosmetic point of view, to paint the stairwells (walls and soffits).

Painted steel balustrades are bolted to the staircases. These appear to be in average condition and would benefit from cleaning as a minimum and re-coating in some locations. The handrailing is discontinuous on the 'outer' perimeter of the stairwell at the internal blockwork wall. Absent sections could to be readily added.

5.3.2 Facades

The two staircases to this car park are mostly clad with patent glazing. There are also what appear to be pre-cast concrete cladding units.

The patent glazing system is considered to be original and comprises of:

- Aluminium transoms and mullions
- Georgian wired glazing with rubber gaskets to the framework
- Steel supporting framework, partially embedded in the concrete framework

Overall, the glazing system is tired and damaged in part and at the end of their expected serviceable lives. Our review of each is noted below:

- A. Staircase A (Main entrance, incorporating the lift shaft). We noted approximately 22 nr. broken or cracked glazing panes, and two loose gaskets. Overall there is surface corrosion to most of the supporting steel framework and overall the cosmetic appearance is very poor.

- B. Staircase B (to the rear southwest corner). The lower (Ground Floor) entrance is hoarded with plywood and cordoned off from first floor level and so it is not in use for ground level access. We noted approximately 10 cracked or damaged glazing panes, most of which appear to be ballistic holes in the glazing. There are a few loose gaskets. The ground level aluminium doorset is damaged and missing ironmongery and therefore not fit for use. Once again, there is surface corrosion to most of the supporting steel framework and overall the cosmetic appearance is very poor.

In light of the above, the glazing systems are in need of substantial refurbishment and repair. Given the extent of the work required, and the general poor cosmetic appearance of the system installed, consideration should be given to replacing all of the façade glazing systems. New systems are likely to have a payback period of five to 10 years, given the life of the existing systems and the need to continually maintain.

The concrete elevations appear to be in reasonable condition. The condition of the cladding fixings should be investigated however, before determining the extent of any refurbishment. Local spalling of the exposed concrete surface (and associated corrosion of reinforcement bars) is evident in part, but we would expect the cladding to be repairable, prior to cosmetic improvement, perhaps including steam cleaning and subsequent application of an anti-carbonation coating.

5.3.3 Stair tower roofs

The main stairwell and lift are located on the northwest facing elevation. The stairwell roof consists of upper and lower horizontal roof sections linked by an inclined section, bounded on three sides by a low upstand, and is shown in Figure 5-4. The roof and low upstands are covered with what appears to be sheets of a dark grey mineral felt roofing product. The fourth (lift well) side is bounded by a higher wall with mineral felt sheet extending approximately a quarter the way up the wall. The remainder of the wall is bare concrete. There is some moss and mud accumulation on the roof surfaces, and approximately 80% of the lower roof area is obscured by detritus and standing water.

The roof covering appears to have degraded over time, with what appear to be splits, and blistering in the covering, which has also lost much of the original grit at the surface.

There is an outlet at the southeast corner of the lower flat roof section, providing drainage to a hopper and downpipe.

A metal strip lighting conductor “tape” is present at the perimeter upstand walls. It is detached in places. It may have been used to assist members of the public to climb onto the roof, resulting in this damage. There is also galvanised steel anti-climb strip attached to the upstand facing the car park deck. These elements would need to be removed and re-attached if the weatherproofing were to be replaced. All lightning protection systems should comply with BS 6651 and be designed, installed and tested by specialist lightning protection engineers.

The roof to the lift motor room is a simple flat roof (shown in Figure 5-5) with low (approximately 100mm) perimeter upstands, with a penetration at the southeast corner feeding a hopper and downpipe from the lift core roof which discharges onto the upper flat roof section of the adjacent stairwell roof.

The surfacing appeared to be a continuous mastic asphalt covering to the main roof and vertical and horizontal components of the perimeter upstands. The asphalt appeared to have been overcoated with a light grey liquid applied coating. Condition appeared good, with no obvious damage or delamination to the surface.

The roof is partly obscured with silt, had standing water over 80% of the area, and the upstands were heavily coated with algae.



Figure 5-4 Main stairwell roof

Deterioration of roofing material, standing water and detachment of lightning strip from file GOPR0427



Figure 5-5 Lift motor room roof

Roofing material in good condition, standing water and lightning strip from file GOPR0428

The stairwell at the south corner of the car park comprises an upper and lower flat roof sections with an intermediate inclined roof section (Figure 5-6). There are no perimeter upstands. There is a lighting tape attached to the perimeter, and a galvanised steel anti-climb strip at the top of the lowest section of wall facing the car park.

The roof was formed of concrete which was coated with what appears to be a thin (<5mm thick) bituminous system, possibly some form of bituminous felt. This surfacing has degraded heavily, has disintegrated or been removed, or is otherwise extensively damaged on the horizontal roof sections, and to a lesser degree the inclined surface. The whole roof needs to be re-surfaced, which requires removal and re-attaching the lighting protection tape and anti-climb strip.



Figure 5-6 Southwest corner stairwell roof

Roofing material in degraded condition, and lightning strip from file GOPR0429

5.4 Foundations

The foundations are not visible without excavation, which is outside of the remit of the survey completed to date, and therefore have not been inspected. However, there is no evidence of settlement, movement or tilting of the structure.

5.5 Edge protection

The vehicle containment is provided by galvanised steel un-tensioned corrugated beam sections. These are variously attached (bolted) directly to the reinforced concrete or attached to steel “U” channel post sections, bolted to upstands in the floor slab. Pedestrian containment is provided by galvanised steel sections located above the corrugated beam. This includes a flat section at mid-height and top “L” section, again bolted either directly to the columns (where present), or to the “U” channel post sections (where not).

There is no vehicle restraint on the ground floor short southeast elevation; this appears to be provided by a solid half-height brick wall.

The condition of the edge protection is generally good, with only localised corrosion of the main elements. The condition of the baseplates and holding-down bolts for the posts is more variable, as might be expected for a car park of this age. There is some evidence of corrosion on the plates and bolts. Neither the length of the bolts nor the engagement depth is known, nor the condition of the bolts below the baseplate.

The existing edge protection does not meet current standards for the following reasons:

- the rigid post supports (steel C-sections) are incapable of accommodating the current vehicle impact loadings,
- the barriers are easily climbable, and of insufficient height, and
- the spacing between the elements permit the passing of a 100mm diameter ball, and as such the barrier fails to prevent children from accidentally endangering themselves.

The edge protection could be replaced with a new vehicle and pedestrian barrier either by removing the existing barriers and installing a new modern code-compliant edge protection along the same alignments, or by installing a new edge protection system in front of the existing system, fixing to the deck instead of the columns. Removing the existing and installing a new ‘rigid’ system would be more expensive than a new ‘flexible’ system due to the reduced post spacing and the need to remove the current barrier system.

Installation of new ‘flexible’ system in front of the existing will encroach on the bin depths (depth of parking spaces) and of the aisles, typically by 300mm per installation. Therefore the aisle widths could be reduced by up to 600mm, and the aisles are already below the recommended width for two-way circulation.

5.6 Drainage

The drainage in the car park relies on the sloping deck sections transporting surface water downslope to shallow cut-off channels formed in the deck surface. The deck has a local deepening to accommodate the surface indentation forming the channel. Each channel appears to effectively intercept water tracking down the full width of the ramps, and are sloped toward the external perimeter, allowing water to drain through a grating and into a series of metal down-pipes to ground level. The pipework is intact, but leaking slightly in some locations. The pipework is painted, but the coating has degraded and could be re-coated to improve the appearance.

5.7 Lift motor room

The lift motor room is accessible via a locked door from the top deck of the car park (Image 5-7). The room is weather tight and appeared in good condition, with no evidence of water ingress through the roof or walls. The floor covering appeared to be cracked but not delaminating.



Figure 5-7 Lift motor room
Room in good condition with no obvious sources of water ingress

5.8 Entry / Exit layout / visibility for new POF system

The ground level access was inspected and a proposal prepared for re-modelling the layout for POF. This was included in the Draft Issue of this report. After review with BCC Parking Services in March 2018 this section has now been removed as POF is no longer a preferred option. Should ‘pay and display’ be implemented it is understood that BCC will consider removal of the existing gate and entry/exit system at ground level.

5.9 Retaining secure parking

The following sections were prepared in response to the requirement to relocate existing contract parking spaces to higher levels in the car park. This is equally relevant for POF and ‘pay and display’ should either option be adopted. Options that provide the same level of security as users currently enjoy have been considered. However, this clearly requires additional expenditure, and is not necessary if no physical barrier is required. It is noted that BCC plan to introduce additional CCTV as part of any new parking arrangements.

5.9.1 Vehicle gate

The current sliding gate which secures the contractor parking could be removed and re-installed at a new location. The preferred location would be part way along a ramped deck higher in the car park.

The gate would need to be placed at or beneath a beam to allow the fixings to be installed away from the deck slab which is only 175mm thick. Structural calculations should be undertaken to check the additional load cases on the frame; the relatively light loading is not expected to be a problem. The existing “Reserved Parking” on the beam at ground floor entrance may need to be painted over (dependent on the future location of ‘Holiday Inn’ parking allocation).

Moving the current system has the advantages of recycling the main parts of the gate and control/access system. There will be no major change in hardware for the current users of the system (and importantly the contract parkers). However, the gate will still be a pinch point in the car park due to its current design which restricts the width of the driving aisle to approximately 5m. This width is further reduced by the need for islands, on both sides of the barrier, for the keypad and card reader. The current layout forces exiting cars into the other lane preventing cars from comfortably entering and exiting at the same time.

It is possible that re-use of some or all of the equipment would be practical in a 10-year plan, if a suitable contractor was engaged and willing to take on the commitment to re-commission a previously operated gate access system. It is possible that after re-location the system would require a greater level of maintenance. Therefore it would be more prudent to install completely new equipment for a 20-year plan.

One option investigated was using bi-fold gates on the horizontal deck area around staircase A. This would create a pinch point with cars queuing to enter and exit, and we have excluded this as a realistic option.

Using a telescopic sliding gate could optimise access by increasing the available trafficable width (i.e. the full width of the aisle). Telescopic gates can slide on runners from the beam or tracks in the deck. Number plate recognition could also be added to the system allowing easier access and egress for users.

5.9.2 Pedestrian access

Consideration has been given to installing a secure entrance system for contract parking at higher levels in the car park. This requires both stair towers and the lift to be made secure, unless the secure perimeter is taken as being the fire door to a particular level, and the door is made secure. The simplest option would be to install electro-magnetic door locks to the relevant fire door sets, and new access controls either side of the doorway. This removes the need to install additional access restrictions on the stairs and lift, but permits all car park users access to the full height of each stair tower. It would be possible to re-locate the existing secure entrance door on the ground floor to a higher level, but it is not suitable as a fire door.

Consideration must be given to removing the barrier at the base of stairwell B so that this becomes a viable exit from Level 1 and above.

5.10 Removal of existing shutters to each deck

There are roller shutters on the north side of the car park at level 2 and level 4. Currently these roller shutters are welded in the open position. It is feasible to remove the roller shutters only or the concrete partition wall across the parking space as well (following structural calculations).

Removing only the roller shutters will require minimal works. Making good will require cutting back fixings and painting the soffit. Removing the partition wall will require more work to make good. such as planing the deck (to smooth out the surface) and painting the soffit. Some concrete repairs may be required.

5.11 Aesthetic upgrade of external elevations

Any upgrade to the elevations should be considered in conjunction with the agreed actions for the glazed facades, the concrete parts of the stair and lift towers, the missing perimeter blockwork and the actions to be taken at the perimeter parapets. As such, any external upgrade theme is likely to involve cleaning, coating and/or addition of cladding.

5.12 Limitations of current layout

We have reviewed the current layout of the carp park against the recommendations set out in “Design recommendations for multi-storey and underground car parks (Fourth Edition)” by The Institute of Structural Engineers. The driving aisle is approximately 6.6m wide where the recommendation for 2-way aisle is 6.95m. The narrowest points of circulation in the car park are between the main columns at the horizontal sections at the short ends of the car park, where vehicles turn 180 degrees between the two adjoining ramps where the width reduces to less than 6m. This is the recommended width for one way traffic, and observation of the current usage indicates that drivers do not pass each other at this point. The situation will only become more complicated with higher turnover of the car park i.e. when operating as POF.

At the moment there is some overhang of cars in to the driving aisle reducing the trafficable width of the driving aisle and the available space for maneuvering (parking and turning around). This is because the bay depths are not long enough for some modern cars particularly when not parked tight against the vehicle barrier. As noted in Section 5.5, any increase in the space occupied by the vehicle and pedestrian barrier will exacerbate the problem.

The current width of the bays is less than 2.3m which is the recommended width for a long stay car park. For a mixed use car park (which is anticipated in a POF), the recommended width of the bay is 2.4m. This is not possible on the south west side of the car park due to the column spacing, without halving the number of spaces. Elsewhere the reduction in spaces could be less.

There is the option that the layout of the car park can be changed to be more accommodating to those using it as a POF facility. Changes to the layout of spaces and aisles could improve circulation and usability, but would reduce the number of parking spaces significantly. This could help make the car more attractive and potentially command a premium rate.

In the light of the above, further consideration is recommended prior to agreeing the recommended maintenance and improvement works.

6.1 Approach

We understand that there are no contemporary construction drawings, structural drawings, previous records of structural appraisal, or records of maintenance and repair activity for this structure. On this basis, a structural investigation was designed and undertaken, recording parameters such as chloride ion content, cover depth, carbonation depth and compressive strength.

The structural investigation was aimed at deriving the material condition and properties so that load assessments could be undertaken, at specific structurally vulnerable positions. It was also aimed at assessing the overall condition, type and extent of deterioration, and risk of future deterioration, which are important factors in assessing the potential demand for repair and maintenance.

It was not possible to undertake a full assessment of all elements of the car park at all levels; columns, beams and slabs have been sampled and tested at specific locations only.

This section of the report documents the findings of the site investigation and associated laboratory testing.

CH2M HILL/Jacobs appointed a specialist contractor, EDS to undertake the sampling and testing work. Intrusive sampling was carried out at 24 locations and included:

- measurement of minimum cover depth to reinforcement;
- carbonation depth,
- incremental dust drilling for laboratory testing for chloride content, and
- 'break outs' to locally remove concrete cover to expose a reinforcing bar for calibration of instruments and visual confirmation of corrosion condition.

In addition, three, 50mm diameter core samples were also cut and removed from beam soffit, column and deck positions. These samples were conveyed to a specialist laboratory to determine compressive strength and density.

These sample and test locations are shown in Table 6.1 below:

TABLE 6.1
Sample and Test Locations

Location reference	Level	Element	Testing undertaken
BO1	Ground	Column	Cover, Carbonation, Breakout
BO2	Ground	Column	Cover, Breakout
BO3	Ground	Column	Cover, Breakout
BO4	3	Column	Cover, Breakout
BO5	3	Deck	Cover, Breakout
BO6	3	Beam	Cover, Breakout
BO7	3	Column	Cover, Breakout
BO8	3	Beam	Cover, Carbonation, Breakout
BO9	3	Column	Cover, Carbonation, Breakout
TA1	3	Deck	Chloride
TA2	3	Deck	Chloride

TABLE 6.1
Sample and Test Locations

Location reference	Level	Element	Testing undertaken
TA3	3	Deck	Chloride
TA4	2	Deck	Chloride
TA5	4	Deck	Chloride
TA6	4	Deck	Chloride
TA7	4	Deck	Chloride
TA8	2	Deck	Chloride
TA9	2	Deck	Chloride
TA10	Ground	Deck	Chloride
TA11	Ground	Deck	Chloride
TA12	Ground	Deck	Chloride

Table Notes
 Cover = Covermeter depth; Breakout = Break out; Breakout = Depth of Carbonation;
 Chloride = Chloride drilling (3 depth increments)

All drilled sample holes, core holes and break-out areas were reinstated using a BS EN 1504-3 Class R4 repair material.

6.2 Record of defects

6.2.1 Visual and Hammer Tap Survey

All visible areas were checked for defects and accessible areas where defects were found were checked for debonding of the cover concrete from the reinforcing bars using a light chipping hammer and noting the audible response. A 'drummy' note indicated hollowness whilst a 'ringing' signified a sound bond to the bars.

A summary of concrete defects identified is presented in the Tables 6.2 and 6.3.

TABLE 6.2
Concrete delamination or spalling defects

Element	No of defects	Total estimated area (sqm)
Slab	117	15.32
Slab soffit	108	8.18
Upstands	37	1.01
Column	3	0.09
Elevations	60	2.14

TABLE 6.3
Concrete defects by level

Element / Level	No of defects by level						
	Ground	1	2	3	4	5	6
Slab	23	47	19	6	2	12	5
Slab soffit	29	9	17	25	28		
Upstands		3	15	6	5	1	
Column					3		
Elevation	7	6	24	2	19		3
Total	59	65	75	39	57	13	8

6.3 Reinforcement and cover

6.3.1 Cover Meter Survey

The depth of concrete cover to the steel reinforcement embedded in the structure was measured using an electromagnetic cover meter instrument, which operates in general accordance with the requirements given in British Standard BS 1881: Part 204.

A Hilti X Scan PS 1000 scanner was also used to locate and measure the cover to the steel reinforcement. The minimum recorded cover depth, irrespective of orientation, was recorded within each 600mm x 600mm grid area and at each break out. A summary of the cover depths detected is shown in Table 6.4.

6.3.2 Concrete Breakouts

Concrete breakouts were undertaken within test areas BO1-9, using an electrical- powered percussion drill and breaker with chisel points in order to visually confirm the bar type, actual cover depth and the corrosion condition.

The depth of cover was assessed at sixteen test areas: 8No. on the deck, 6No. on the columns and 2No. on beam soffits. The results are shown in Tables 6.5.

TABLE 6.4
Minimum Cover detected by covermeter survey

Test area reference/element	Minimum Cover detected by covermeter survey
Scan 1/Deck (Level 3)	150
Scan 2/Deck (Level 4)	55
Scan 3/Deck (Level 4)	150
Scan 4/Deck (Level 4)	25
Scan 5/Deck (Level 5)	65
Scan 6/Deck (Level 5)	35
Scan 7/Deck (Level 5)	35

TABLE 6.5
Results of break outs

Test area reference/element	Bar orientation	Actual cover at break-out (mm)	Bar type/diameter (mm)/condition
BO1/Column (Ground)	Horizontal	40	Textured/10/ no corrosion
	Vertical	50	Square twist/32/no corrosion
BO2/Column (Ground)	Horizontal	45	Square twist/ 10/ no corrosion
	Vertical	55	Square twist/ 32/ no corrosion
BO3/Column (Ground)	Horizontal	55	Plain round/10/ no corrosion
	Vertical	65	Square twist/ 32 / no corrosion
BO4/Column (Level 3)	Horizontal	35	Plain round/10/no corrosion
	Vertical	??	Square twist/ 25 / no corrosion
BO5/Deck (Level 3)	Transverse??	60	Square twist/ 16 / no corrosion
	Longitudinal??	76	Square twist/ 16 / no corrosion
BO6/Beam (Level 3)	Link	50	Plain round/10 minor surface corrosion
	Main span	60	Square twist/25 minor surface corrosion
BO7/Column (Level 3)	Horizontal	50	Plain round/10/ no corrosion
	Vertical	60	Square twist/ 25 / no corrosion
BO8/Beam (Level 3)	Link	55	Plain round/10/ no corrosion
	Main span	65	Square twist/ 25 / no corrosion
BO7/Column (Level 3)	Vertical??	45	Square twist/ 25 / no corrosion

6.4 Carbonation, chlorides and strength

6.4.1 Carbonation Depth

The alkalinity of concrete is reduced by atmospheric carbon dioxide and this is an ongoing process which penetrates from the surface of the concrete towards the embedded steel. Where this carbonated layer reaches the reinforcement, the risk of corrosion increases.

The reduction in alkalinity of the concrete is measured using a spray-applied phenolphthalein indicator solution to a freshly broken concrete surface in general accordance with Building Research Establishment Information Paper (BRE IP) 6/81 and Digest 405.

The depth of carbonation is indicated by a distinct colour change between clear (carbonated) and pink (un-carbonated) concrete. The depth of carbonation can then be measured from the concrete surface. The carbonation depth test results are recorded in Table 6.6.

TABLE 6.6
Results of Carbonation Depth Survey

Test area reference/element	Measured carbonation depth	Concrete cover depth at breakout	Cover depth >carbonation depth (Yes/No)
BO1/Column	5	40	Yes
BO8/Beam	15	55	Yes
BO9/Column	15	45	Yes

6.4.2 Chloride Ion content of the decks

At selected deck locations, drilled dust samples were collected using a rotary-percussive drill and large diameter masonry bit in accordance with recommendations detailed within BRE-IP 21/86.

The concrete dust was collected in approximate depth increments as follows: 5-20mm, 20-35mm and 35-50mm. The outermost 5mm was assumed to be weathered and therefore non-representative and discarded.

The dust samples were then submitted to a UKAS accredited laboratory, Quartz Scientific Ltd, for chemical analysis for determination of chloride ion content in accordance with the procedures detailed within BS 1881: Part 124. The cement content was not evaluated during this survey but an assumed cement content value of 14% was used.

The laboratory test certificates are presented in Appendix B. The data was assessed using the criteria given in BRE Digest 444: Part 2 for a 40 year old structure (assumed damp with $\text{pH} > 10$), and against the threshold value above which the levels of chloride ion are considered to induce corrosion (i.e. 0.4% by weight of cement for chloride). Given its age it is feasible that cast-in chlorides are present, however, this not believed to be the case.

The data shows significant elevations over the expected chloride content in the outer 50mm of the deck slabs. Chlorides could have originated from the use of de-icing salts spread across the car park or tracked in by vehicles during winter periods.

There are high levels of chloride contamination in the outer 50mm of the ground level (including both the ground-bearing floor slab and the suspended deck from the existing entrance up to Level 1). Given the incidence of 23No defects in the Ground Floor and 47No on Level 1, it is highly likely that chloride-induced reinforcement corrosion is occurring in multiple areas.

Variable levels of chloride were found in Level 2, varying from Moderate to Extremely high. This was in combination with 19No. defects in the deck. At level 3 and 4, the chloride content in the deck increments are lower, and vary from Low to High, but are still at levels that are associated with chloride-induced reinforcement corrosion. However, only 6 defects were recorded in the deck of level 3, and only 2 on level 4.

6.4.3 Core Sampling

Three concrete core samples of 50mm nominal diameter were extracted using a wet, diamond-tipped coring rig, which incorporates a water flush for bit cooling and sediment removal. The core samples were extracted in general accordance with the methods described in BS EN 12504-1:2009.

The core samples were dispatched to a UKAS accredited laboratory, Sandberg LLP for determination of compressive strength and density. Each core sample was prepared, examined, measured and tested in accordance with the methods described in BS EN 12504-1:2009 and BS EN 12390-7:2009 to give the corrected in-situ strength and density (water displacement method).

The core compressive strengths ranged from 64.0 N/mm² to 68.2 N/mm², as shown in Table 6.7.

TABLE 6.7
Results of Compressive Strength Tests

Element	Mean Diameter (mm)	Saturated Density (Kg/m ³)	Corrected in-situ Strength (N/mm ²)
Beam	44	2450	64.0
Deck	44	2430	60.1
Column	44	2450	68.2

A copy of the test certificate is provided in Appendix C.

6.5 Discussion of main findings

6.5.1 Cover and protection to reinforcement

The columns and beams in the car park are characterised by dense, strong, well compacted concrete equating to significant amounts of high quality concrete cover. There is very little evidence of active corrosion of the reinforcement exposed in these elements. The depth of cover far exceeds the carbonation depth (5-15mm), suggesting there is little risk of carbonation-induced reinforcement corrosion to the main elements of the structural frame. However, there is some localised damage which may have resulted from particularly low cover, or from localised ingress of chlorides (see 6.5.2).

The minimum cover depths from slab ranged from 35mm to 150mm, with a mean value of 46mm (excluding two readings of 150mm).

6.5.2 Chlorides and deck reinforcement

Large areas of the Ground floor, Level 1, and Level 2, deck are expected to be actively corroding or likely to initiate macro-cell corrosion activity in the future. Repair of damaged areas is necessary to retain strength in the deck slabs, but concrete repair is unlikely to provide a long-term solution without additional corrosion-control techniques and repair in combination with a new water resistant surfacing.

The extent of corrosion activity is likely to be lower, and more restricted in area on levels 3 and 4, as demonstrated by the much smaller number of defects currently manifested in the deck. However, the chloride sample data indicates a significant ongoing risk of chloride-induced corrosion which is best mitigated by action in the short term, by introducing a new water resistant surfacing.

Sporadic and localised chloride contamination is expected on Level 5 and 6, where there are also a relatively small number of deck defects.

Structural Appraisal

7.1 Details of Appraisal

The purpose of the structural appraisal is to assess the current condition, safety, structural adequacy of the existing primary and secondary structural components against current requirements and to forecast future trends and needs for inspection and repair.

7.2 Basis of the Original Design

It is considered likely that based on the age of the car park the original design would have been to: CP 114: The Structural Use of Reinforced Concrete in Buildings, or possibly CP 110: Code of Practice for the Structural use of concrete, as shown in Table 7.1.

TABLE 7.1
Development of design codes

Table 1.1 Development of Codes of Practice since 1934

Code	Steel stress (working load)	Load factor	Deflection	Cracking	Comments
1965 CP116 CP114	$0.55f_y$ (230N/mm ²)	1.8	Warning+ expanded span/depth	Warning	Concrete —statistical control for quality
1972 CP110	$0.58f_y$ (267N/mm ²)* (without redistribution)	1.6*–1.8	Span/effective depth ratios	Bar spacing rules	Ditto

Table 7.1 Development of codes

7.3 Investigation Work

Due to an absence of structural design or construction information it was necessary to undertake localised intrusive investigation work to ascertain as-built reinforcement arrangements. Key structural elements were identified and localised breakout work and GPR surveys undertaken. Table 7.2 summarises the reinforcement encountered in the locations investigated. These reinforcement arrangements were used as part of the structural appraisal.

TABLE 7.2
Summary of existing reinforcement content for key structural elements

Element Description	Size (mm)	Reinforcement Intent
Typical Deck	175mm thick slab	25mm square
Transverse Beams	392x325	Four 25mm square twist bars Links 10mm round bars
Longitudinal Beams	696x487	Nine 25mm square twist bars Links 10mm round bars

TABLE 7.2
Summary of existing reinforcement content for key structural elements

Element Description	Size (mm)	Reinforcement Intent
Central Column	690x380	Eight 25mm square twist bars Links 10mm round bars
North Edge Columns	384x310	Four 25mm square twist bars Links 10mm round bars
Column	535x304	Four 25mm square twist bars Links 10mm round bars
South Edge Column	386x321	Four 25mm square twist bars Links 10mm round bars

7.4 Analysis

The car park was analysed as a plane frame with each member representing 16' (4.877m) width of floor. Assessment criteria are as follows:

- Concrete strength 60N/mm²
- Steel yield strength 425N/mm², main bars are all 25mm square twisted, equivalent to 28.2mm diameter
- Concrete density 25kN/m³
- Car park loading 2.5kN/m² assumed (BS EN 1991-1-1:2002 Table NA.6)
- Floor members modelled as T beams (inches): breadth 192 depth 22 t flange 7 t web 15 (floor 7" thick)
- Column member sizes variously 15" x 12", 21" x 12" or 15" x 27"

At the car park ends, the two semi decks are aligned vertically (Figure 7-1) while at mid length the decks are out of phase by half a storey height (Figure 7-2). The vertical height is 2.718m per storey.

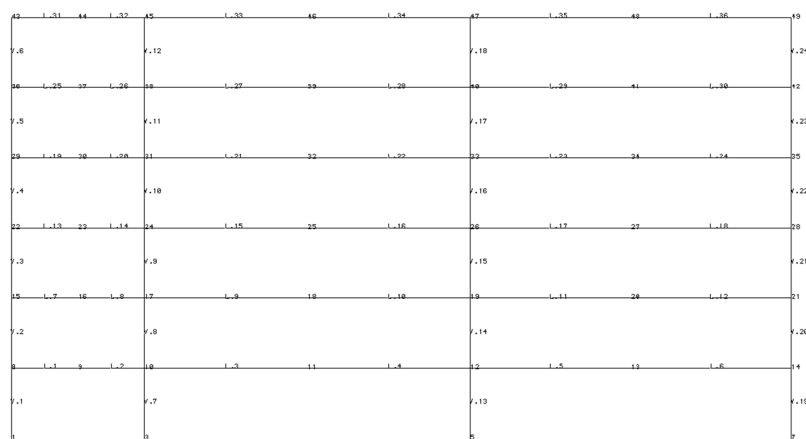


Figure 7-1

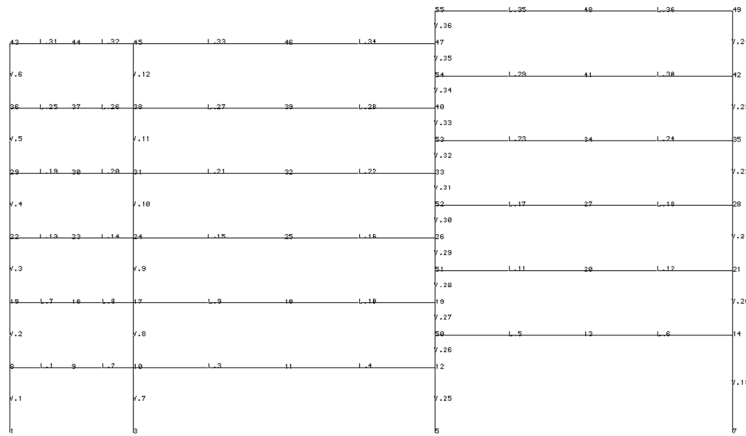


Figure 7-2

Permanent loads and live loads are applied to every part of structure, using two computer models in Leap5 classic. The individual member loads are obtained and factored by spreadsheet for ULS.

The worst case scenarios were obtained and applied to the elements.

7.4.1 Application of load to elements

In accordance with BS 8110 Figure 3.12 and Table 3.18, the slab is divided into column strips and middle strips. Since the drop width 15" is less than one third of the transverse span (192"), the effects of drop are ignored.

7.4.2 Capacity of elements

The beams have four bars in the top and bottom faces all 25mm square (equivalent 28.2mm diameter).

The deck slabs have bars in the tensions faces also 25mm square at 9" or 10" pitch. In some peripheral areas where the span is less, the steel was found to be 16mm square (equivalent to 18mm diameter). Cover to main reinforcement is taken as 50mm. Links in the beams are 10mm round bars ($f_y=250\text{N/mm}^2$) at estimated 12" pitch.

The results of capacity and applied loads are shown in Table 7.3.

TABLE 7.3
Capacity and applied loads

	Capacity	Applied load	Utilisation factor
Sagging of column strip	376.6kNm	286.6	0.76
Sagging of middle strip	$86\text{kNm/m} \times 2.438 = 209.7\text{kNm}$	234.5kNm	1.12
Hogging of column strip	-1157.7kNm	-543.4kNm	0.46
Hogging of middle strip	-209.7kNm	-181.1	0.86
Shear of column strip	211.8kN before enhancement	254.4kN	1.20 before enhancement*
Shear of column strip 3d from an end	211.8kN	196.2kN	0.93

Note: * analysis including enhancement has an acceptable utilisation factor

7.4.3 Longitudinal beams over end turning areas

The end turning bay is modelled separately where two transverse beams are supported within the span of a longitudinal beam. The latter has increased dimensions of 27" wide and 19½" downstand below the deck slab soffit compared to the beams in the remainder of the car park.

The plan area is modelled as a grillage plane as shown in the diagram below. The red lines represent the transverse beams. The green line shows the deeper beam. The model shows four bays at the west end of the car park, representing about 36% of the area of one floor. The entire surface area has a uniform live load of 2.5kN/m².

The beam results are as follows:

TABLE 7.4
Beam Utilisation

	Capacity	Applied load	Utilisation factor
ULS sagging bending moment	787kNm	624kNm	0.79
Coexisting ULS shear force applied	317kNm	338kN	1.07 before enhancement*

Note: * analysis including enhancement has an acceptable utilisation factor

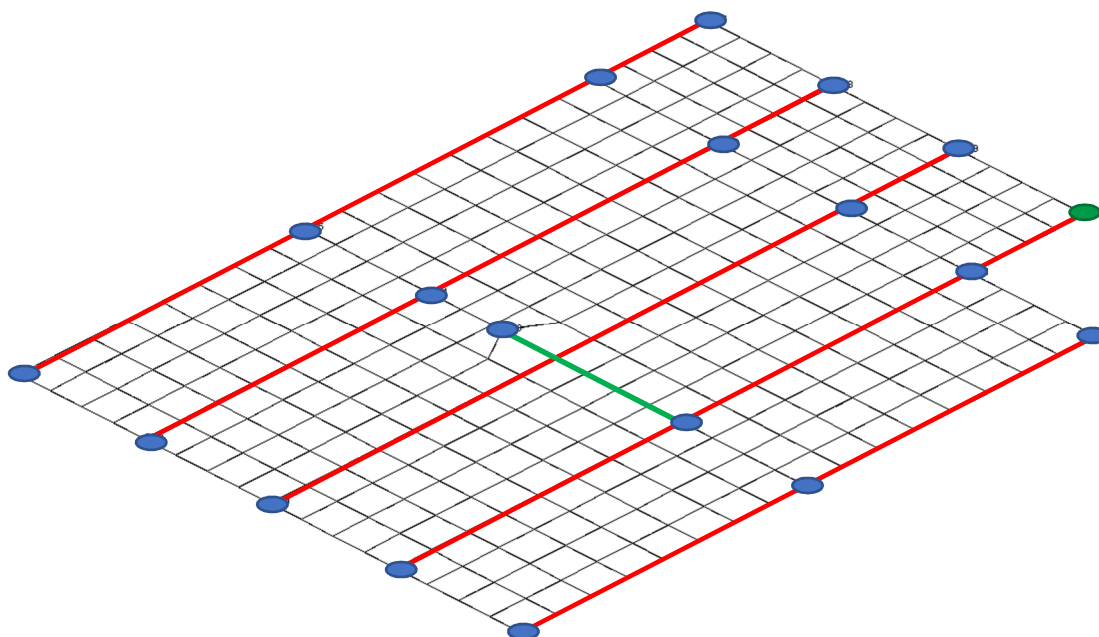


Figure 7-3

7.4.4 Columns between deck floors

The plane frame model was able to find the vertical loads and bending moments (in one plane) for three column sizes and maximum ULS stresses are as follows:

15" x 12" (grid A)	1723kN	stress 45.8N/mm ²
15" x 27" (grid B)	3974kN	stress 43.9N/mm ²
21" x 12" (grid C)	2831kN	stress 36.1N/mm ²
15" x 12" (grid D)	634kN	stress 8.8N/mm ²

7.5 Progressive Collapse

Current design standards and the Building Regulations require consideration of progressive collapse and design of key elements. Based on the age of the structure it may have been designed to CP114 and before the 1970 amendment to the Building Regulations brought in after the 1968 Ronan Point disaster, but prior to the issuing of CP110 in 1972 which contained the first detailed requirements for its prevention.

Collapse may occur as a result of a sustained fire beneath the slab, which exceeds the slab's fire resistance. Vehicle impact on a column could also result in collapse. The columns at the perimeter of the car park are of concern as are the internal columns in the turning areas at each end. Given the uncertainty as to the resistance of the structure to progressive collapse, consideration should be given to undertaking further structural analysis and if necessary protecting these columns.

7.6 Conclusion and Recommendations

From the above analysis, and based on the limited investigation undertaken to date, it is concluded that there are some areas where the capacity of the frame and decks are not proven to be as large as would be expected. The key consideration is therefore whether the structure is inadequate for the anticipated full design load, or whether we have simply not yet undertaken sufficient investigation to identify all the reinforcing bars in the beams, columns and slabs. Given that there is currently no evidence of structural distress in the structural components of the car park, and it has operated for at least 45-years, it is highly likely that the car park as currently operated is not overstressed. It is also likely that the limited investigation to date has not identified all reinforcing bars present. Changing the operation of the car park to POF does however result in a likely increase in loads, as there is likely to be a higher density of parking on some decks and overall, and a larger number of vehicle movements per day. This, in combination with gradual reduction in capacity associated with future reinforcement corrosion, means that the risk associated with the uncertainty in the load characteristics of the structure is likely to increase in the future. It would therefore be prudent to undertake a further phase of investigative works of the structural detailing at critical locations. These are:

- Centre spans of decks, and
- Columns vulnerable to vehicular impact, and
- Columns at different levels in the car park.

Life-care Recommendations

8.1 The Plan

The Initial Appraisal, Condition Survey, Structural Investigation and Structural Appraisal have been used as the baseline for the development of a LCP. In developing recommendations it has been assumed that the requirement is to upgrade the structure to near modern standards as far as is reasonably practicable and then maintain it in its current condition for the foreseeable future. The main elements of the recommendations for the content of the LCP, including the inspection and recommendations, are identified in Table 8.1.

8.2 Routine Inspections

Routine inspections should be undertaken on 6-monthly cycles and should include the following aspects: visual inspection of key elements (structural frame, masonry, drainage etc). These inspections should be based on a checklist including but not limited to the items given in Table 8.1 mentioned above.

8.3 Condition Surveys

Following the condition survey report herein, condition surveys should be carried out at a maximum interval of 5 years. The proposed dates for these are given in Table 8.1. Items to be considered in future condition surveys should be based on the findings of the intervening inspections and the survey works undertaken and described in this report. The results of each future condition survey should be used to re-calibrate the LCP.

8.4 Structural Appraisals

Based upon the findings of the limited structural appraisal herein, future structural appraisals should be undertaken at 10 year intervals. The proposed date for this activity is given in Table 8.1. Items to be considered at that time shall rely upon contemporary condition and special inspection information.

8.5 Record Keeping

All existing documents, such as those listed in Section 5 and all other relevant documents created in the future, should be recorded. These will form the basis of the historical records that need to be kept as part of the Life-care Plan. All other existing information, such as test reports, calculations, drawings and photographs, should also be added to this record.

To assist in the keeping and updating of the records, the following main categories should be listed:

1. Document title;
2. Document type;
3. Reference number;
4. Date produced;
5. Storage location;
6. Life care Plan action;
7. Other comments.

The record should be updated whenever work is carried on the car park. It is recommended that this responsibility for updating and keeping the records is given to a designated person.

SECTION 8

Table 8.1

Inspection and Investigations of Elements for Temple Gate MSCP (based on Table 5.1 of ICE 2002 Recommendations)

Action	Work by	Report to	Required	Scope
Daily surveillance	On-site staff	Property manager	Daily	Record and report any incidents, signs of damage/collisions or failures/breakdown of equipment. To include lighting, signage, security, drainage, columns, decks, walls, soffits, beam, etc.
Routine inspection	Inspector and/or Engineer	Property manager	Every 6 months with an Engineer conducting at least one inspection per annum	<p>Deck, soffits, Structural Elements: Check beams, columns and deck soffits for new calcite, rust staining, damage, cracking or spalling. Check and report any movement, damage or deterioration and loose material. Check for new sites of leakage to the soffit.</p> <p>Drainage Check for signs of damage or new seepage from connections, rodding eyes, etc.</p> <p>Handrails Check holding down bolts and report any missing and or any signs of deterioration. Check for evidence of impact.</p>
Condition Survey	Engineer	BCC	2023, 2028	Carry out future condition surveys based on findings from this report, plus any subsequent inspections.
Structural Appraisal	Engineer	BCC	2028	Items to be considered in further Structural Appraisal should be based on the findings of the previous Structural Appraisal plus also all subsequent inspection and survey works.
Special Inspection	Engineer	BCC	As required	As advised by Engineer e.g. safety inspections.
Maintenance & Repair	On-site Staff	Property Managers	Monthly	Keep drains unblocked and clear of debris likely to restrict flow. Remove any loose concrete in and over public areas. Monitor or repair trip hazards. Make good any minor damage and repair leaks to the drainage system.

8.6 Maintenance Schedule

The maintenance works recommended to be carried out over the next 5 year period (until the next condition survey), along with their priority and estimated cost, are summarised in Table 8.2. It should also be noted that additional maintenance actions may be required after this time, in particular additional concrete repairs. The high value repair and maintenance items are discussed in more detail below.

8.6.1 Reinforcement Corrosion

Chloride induced corrosion is the likely mechanism behind the corrosion and spalling noted on the deck tops and is consistent with de-icing salts being brought into the car park by vehicles, as well as possible historic operational use of de-icing salts in the winter.

Although there is currently only minor damage visible, it is certain that corrosion of reinforcement is ongoing and new locations of concrete spalling/ delaminations will continue to occur and this will need to be addressed to maintain the structural integrity, such as a rolling programme of concrete repairs, carried out every 5-10 years depending on the severity/extent and location of damage. A coating system to the deck would also give some benefit in preventing further chloride ingress and reducing the rate of ongoing corrosion. Repairs form a relatively minor proportion of the overall expenditure, at approximately £40,000.

However, given the potential vulnerability of the deck slabs, it is recommended that at a high quality trafficable water-resistant membrane be applied at Ground level, and Levels 1 and 2. Furthermore, consideration should be given to extending the same up to Level 5 inclusive. This represents significant investment of approximately £180,000 to £360,000.

8.6.2 Masonry

In general terms, the low level (apron) brickwork is in a reasonable condition but requires minor repairs and local repointing.

As described above, the missing sections of blockwork to the South elevation should be reinstated and consideration given to the installation of the protective cladding system as an alternative. For the present we have just allowed for the repair and treatment of the existing walls.

The cost of replacement cladding of the South elevation with a modern maintenance-free alternative, could be in the range of £95,000 - £115,000, subject to specification. This cost excludes VAT, scaffolding access, professional fees and any potential loss of car park income during the works.

8.6.3 Edge protection

The vehicle safety barriers do not comply with current regulations and standards and do not provide adequate protection from a vehicle impact. It is recommended that these barriers are replaced with a suitable system that meet current standards and regulation; this represents a significant proportion of overall costs identified, at approximately £230,000.

8.6.4 Stairwell facades

We have allowed for the overhaul of the existing cladding systems but you may find that the cost to replace, in terms of forward maintenance and whole life cycle costing may provide a payback period of up to 10 years if you replace the patent glazing systems.

We would expect the cost of replacement to the patent glazing to be approximately £90,000 for the entrance glazing and doorset and £45,000 for the rear staircase glazing and entrance door.

We have also allowed for local treatment of corroded steelwork and redecoration of all areas, including the stairs. Concrete cladding repairs are shown separately.

8.6.5 Summary of Actions

The following actions are compiled and ranked in terms of their priority:

TABLE 8.2
Summary of Maintenance Actions

Item	Priority	Maintenance action	Cost (£)
1	High	Investigations to determine the stability and condition of the South elevation infill blockwork masonry walls [no allowance for repairs]. Access cost included.	£7,000
2	High	Repair of the southwest elevation infill blockwork masonry walls. Access cost included.	£33,000
3	High	Install additional handrailing to stairwells	£5,000
4	High	Refurbishment of Staircase A glazing system (entrance elevation)	£19,000
5	High	Refurbishment of Staircase B glazing system (rear elevation)	£13,000
6	High	Perimeter barriers	£189,364
7	High	Internal Barriers	£67,574
8	High	Refurbishment of Staircase A concrete cladding (entrance elevation)	£12,000
9	High	Refurbishment of Staircase B concrete cladding (rear elevation)	£7,000
10	High	Deck concrete repairs	£13,392
11	High	Soffit & upstand concrete repairs	£9,730
12	High	Elevation concrete repairs	£2,575
13	Medium	Replacement of roofing material to staircases and lift core roofs	£4,000
14	BCC	Remodelling of entrance for PoF	£50,000
15	BCC	Removing existing shutters	£5,000
16	BCC	Removing and installing new secure vehicle gate for Contract Parking	£25,000
17	BCC	Installing new secure pedestrian gates in stairwells for Contract Parking	£10,000
18	Low	Internal redecoration of Staircase A	£6,500
19	Low	Internal redecoration of Staircase B	£5,000
20	Low	Cost of scaffolding access to Staircase A	£7,000
21	Low	Cost of scaffolding access to Staircase B	£5,000
22	Low	Cleaning of drainage channels	£500
23	Low	Re-painting of drainage pipes	£2,000
24	Low	Re-gasketing of drainage pipes	£1,000
25	BCC	Aesthetic upgrade of external elevations	-
26	BCC	Coating and white lining	£465,810
Total			£965,445

Notes: BCC denotes the action urgency is to be set by BCC. For 10-year operation, all High priority actions should be implemented, plus Items 11 and 16 to 19. For 20-year operation all items should be implemented.

8.7 Maintenance options

The maintenance actions in Table 8.2 were reviewed with BCC Parking Services in March 2018.

We understand that BCC have limited funds to undertake works and as such some prioritisation of the works in Table 8.2 is required going forward. The level of expenditure is also in some ways dependent on the future use and life of Temple Gate car park. Part of the uncertainty relates to the future use in relation to the proposed nearby Bristol Arena. Further clarity is expected later in 2018.

The options that BCC might apply are as follows:


Option A: undertaking essential maintenance only, with a view to managing deterioration and predicting end-of useful life within 10-years. This option includes substantial works to the vehicle and pedestrian barriers and the infill walls, and is based on Items 1 through 9 of Table 8.2.

Option B: applying the activities in Option 'A' but also undertaking an elevated level of maintenance, such as patch repairs to decks and soffits, with a view to being able (with further works over time) to more confidently extend life beyond 10-years. The works include line items 1 through 13 of Table 8.2.

Option C: apply most or all actions in Table 8.2 with a view to establishing a further 20-year service life. The main additional actions associated with this option are the application of new water-resistant trafficable coatings to the decks.


Clearly the maintenance activities and their related costs depend on the option selected. Option A is costed £353,000, whilst Option B is £383,000 where the activities are undertaken at all levels of the car park. We have prepared a spreadsheet '*Temple Gate LCP Optioneering*' which calculates the cost of undertaking the different works for each level within the car park. As condition and usage vary with level, it is possible for BCC to apply a non-uniform approach e.g. not undertaking repair works at high levels, or closing off the highest levels so that expensive barrier works do not need to be undertaken there. In this way, some significant cost savings could be realised.

Appendix A - Drawings

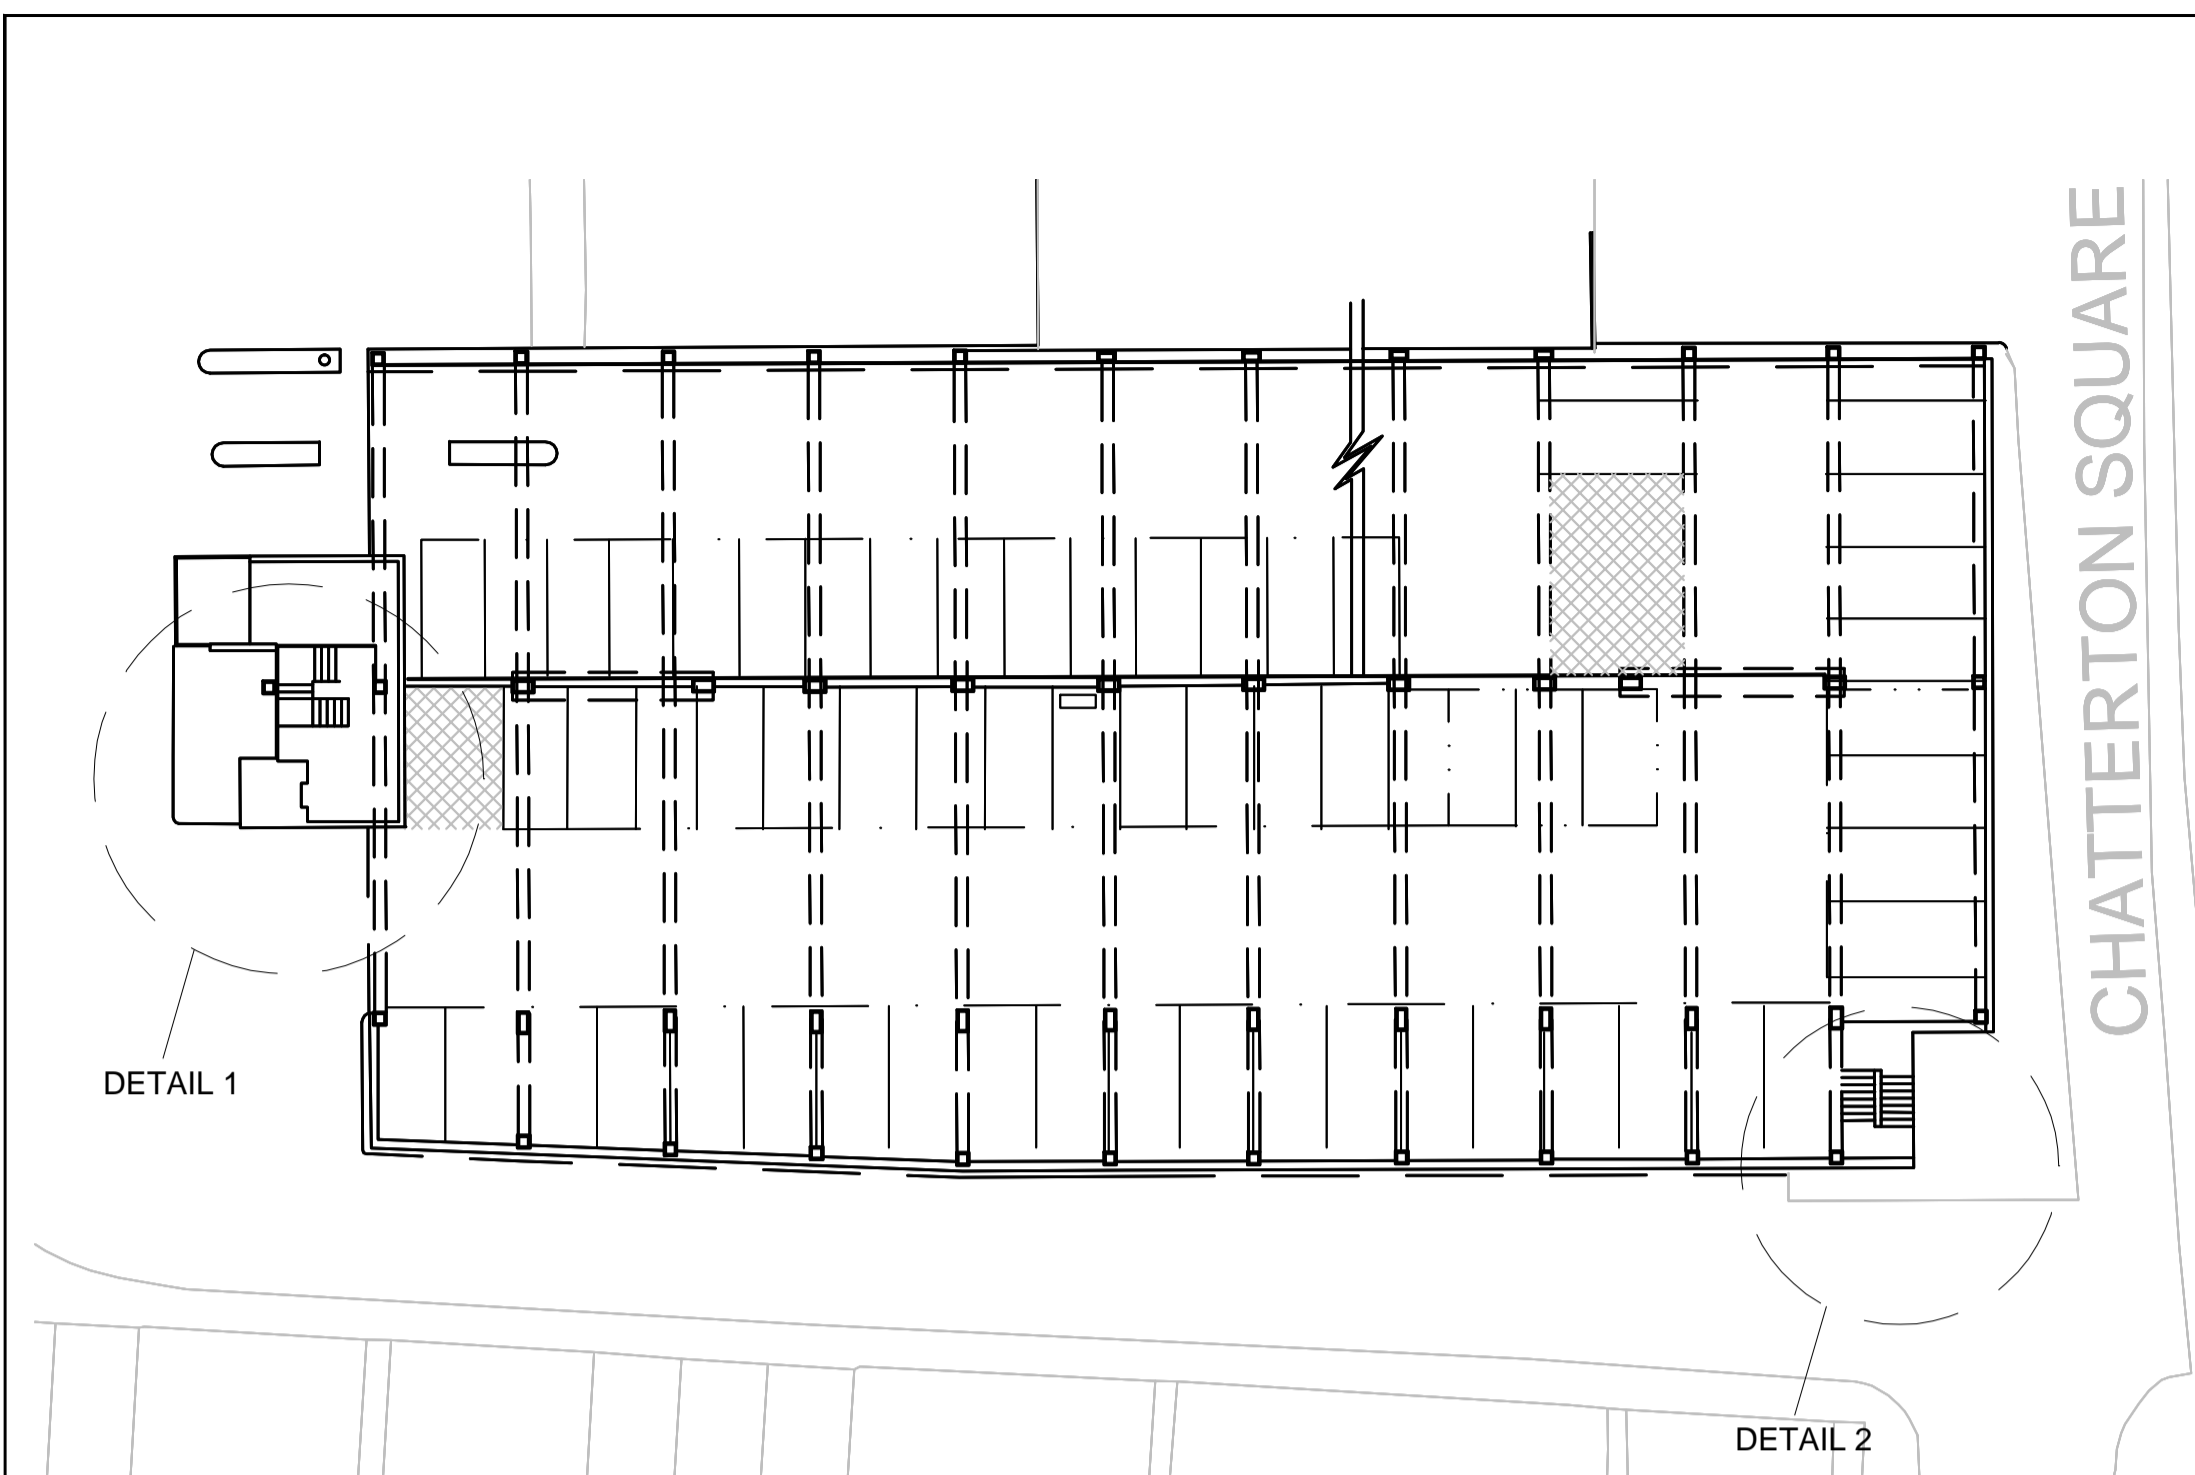


CHATTERTON SQUARE

GROUND FLOOR PLAN
NOT TO SCALE

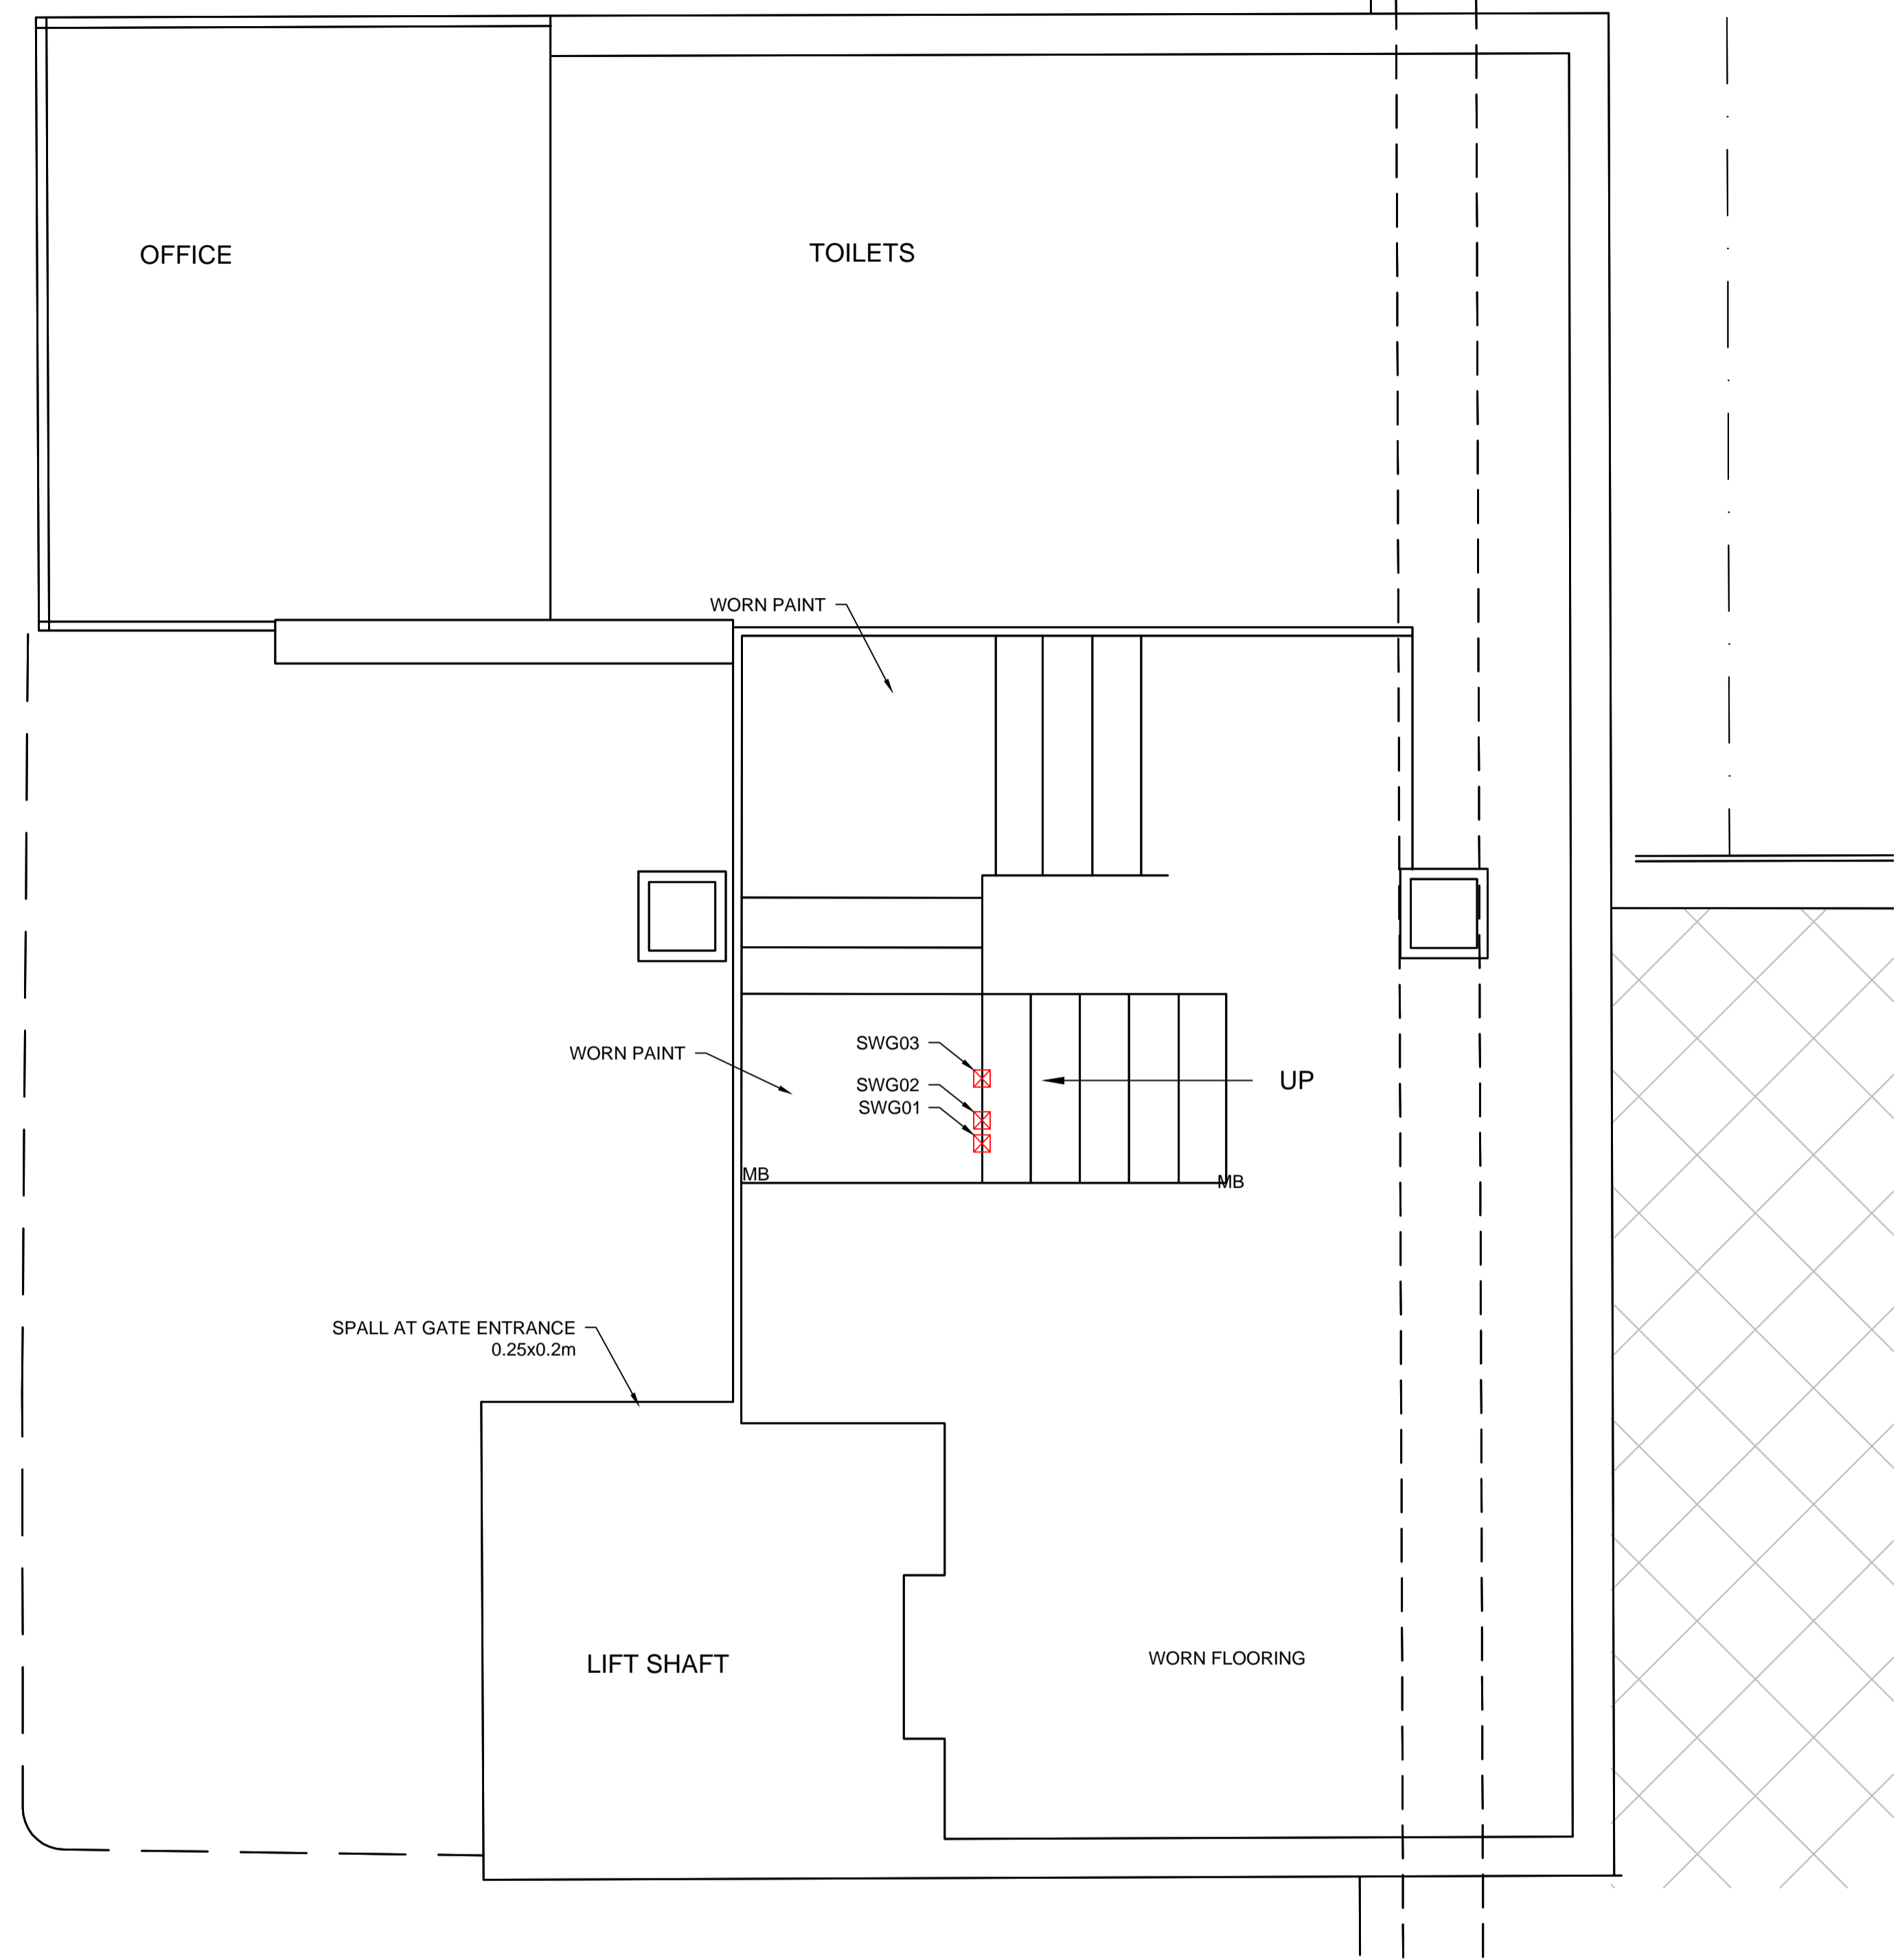

DETAIL 1
NOT TO SCALE

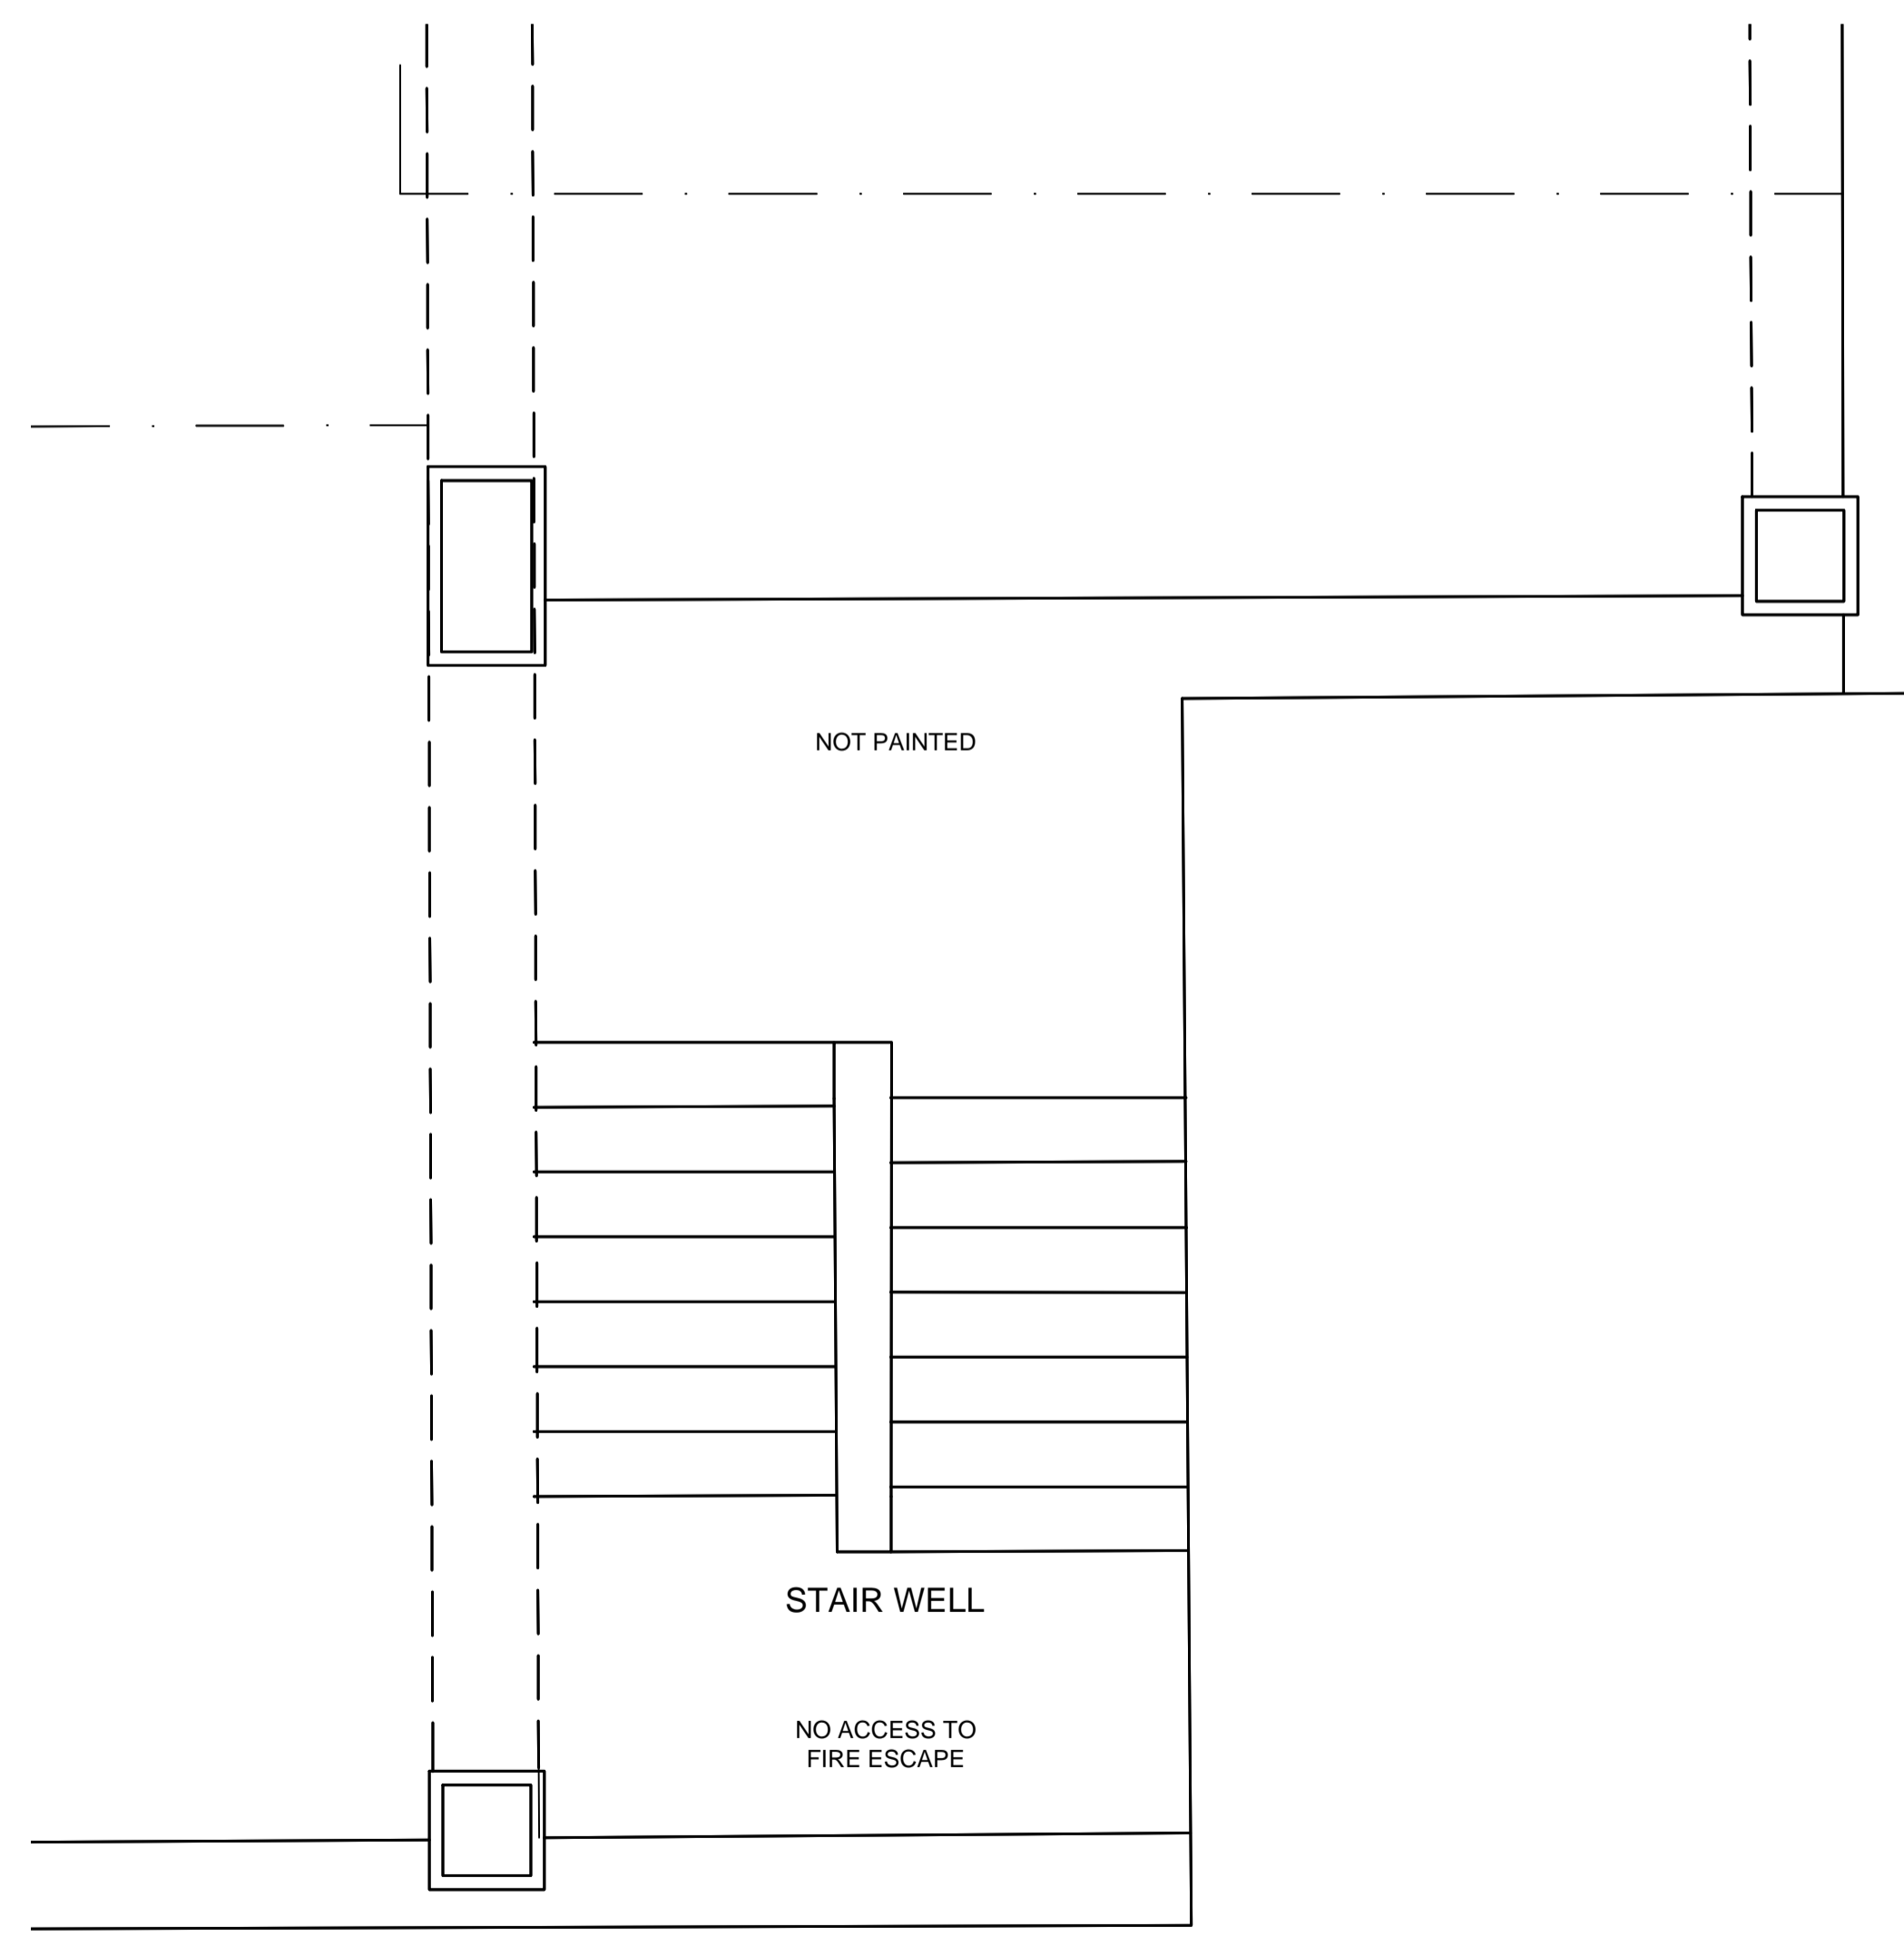

DETAIL 2
NOT TO SCALE

KEY

- MB: MISSING BOLT
- ☒ STAIR WELL DEFECT

Rev	By	Chkd	Apprvd	Date	Description
A	FG	AP	RB	13/02/2018	FIRST ISSUE



CH2M HILL
1 The Square Temple Quay Bristol BS1 6DG
Tel +44 (0)117 910 2580 Fax +44 (0)117 910 2581



Project
TEMPLE GATE MULTI STOREY CAR PARK STUDY

Drawing
TEMPLE GATE GROUND FLOOR STAIRCASE DEFECTS

Drawn by: FG	Date: 13/02/2018
Checked by: AP	Date: 13/02/2018
Approved by: RB	Date: 13/02/2018

Drawing No.	Revision
673846-TG-101	A

Drawing Scale: NTS

CONCRETE REPAIR SCHEDULE - STAIR WELLS

REPAIR REFERENCE	LENGTH (mm)	WIDTH (mm)
SWG01	50	50
SWG02	50	50
SWG03	50	50

This map is reproduced from Ordnance Survey® material by Halcrow on behalf of Bristol City Council with the permission of the Controller of Her Majesty's Stationery Office. © Crown copyright. Unauthorised reproduction infringes Crown copyright and may lead to prosecution or civil proceedings. Licence Number :100023406


CONCRETE REPAIR SCHEDULE - DECK		
REPAIR REFERENCE	LENGTH (mm)	WIDTH (mm)
DG1	300	300
DG2	500	150
DG3	300	200
DG4	300	300
DG5	600	600
DG6	400	300
DG7	500	500
DG8		
DG9	900	550
DG10	400	600
DG11	350	350
DG12	400	150
DG13	400	100
DG14	450	250
DG15	800	300
DG16	600	400
DG17	900	200
DG18	200	100
DG19	550	300
DG20	500	550
DG21	4720	580
DG22	200	100
DG23	500	150
DG24	100	100

CONCRETE REPAIR SCHEDULE - SOFFIT		
REPAIR REFERENCE	LENGTH (mm)	WIDTH (mm)
SG1	400	400
SG2	300	1200
SG3	300	500
SG4	100	500
SG5	200	200
SG6	2300	400
SG7	100x	100
SG8	300	300
SG9	200	200
SG10	200	200
SG11	400	200
SG12	200	100
SG13	100	100
SG14	300	400
SG15	300	200
SG16	100	100
SG17	100	100
SG18	700	400
SG19	600	300
SG20	400	200
SG21	100	100
SG22	200	200
SG23	200	200
SG24	600	300
SG25	300	200
SG26	200	200
SG27	150	150
SG28	150	150
SG29	200	200

KEY

PPS: PEELING PAINT SOFFIT

- ☒ DECK DEFECT
- ☒ SOFFIT DEFECT

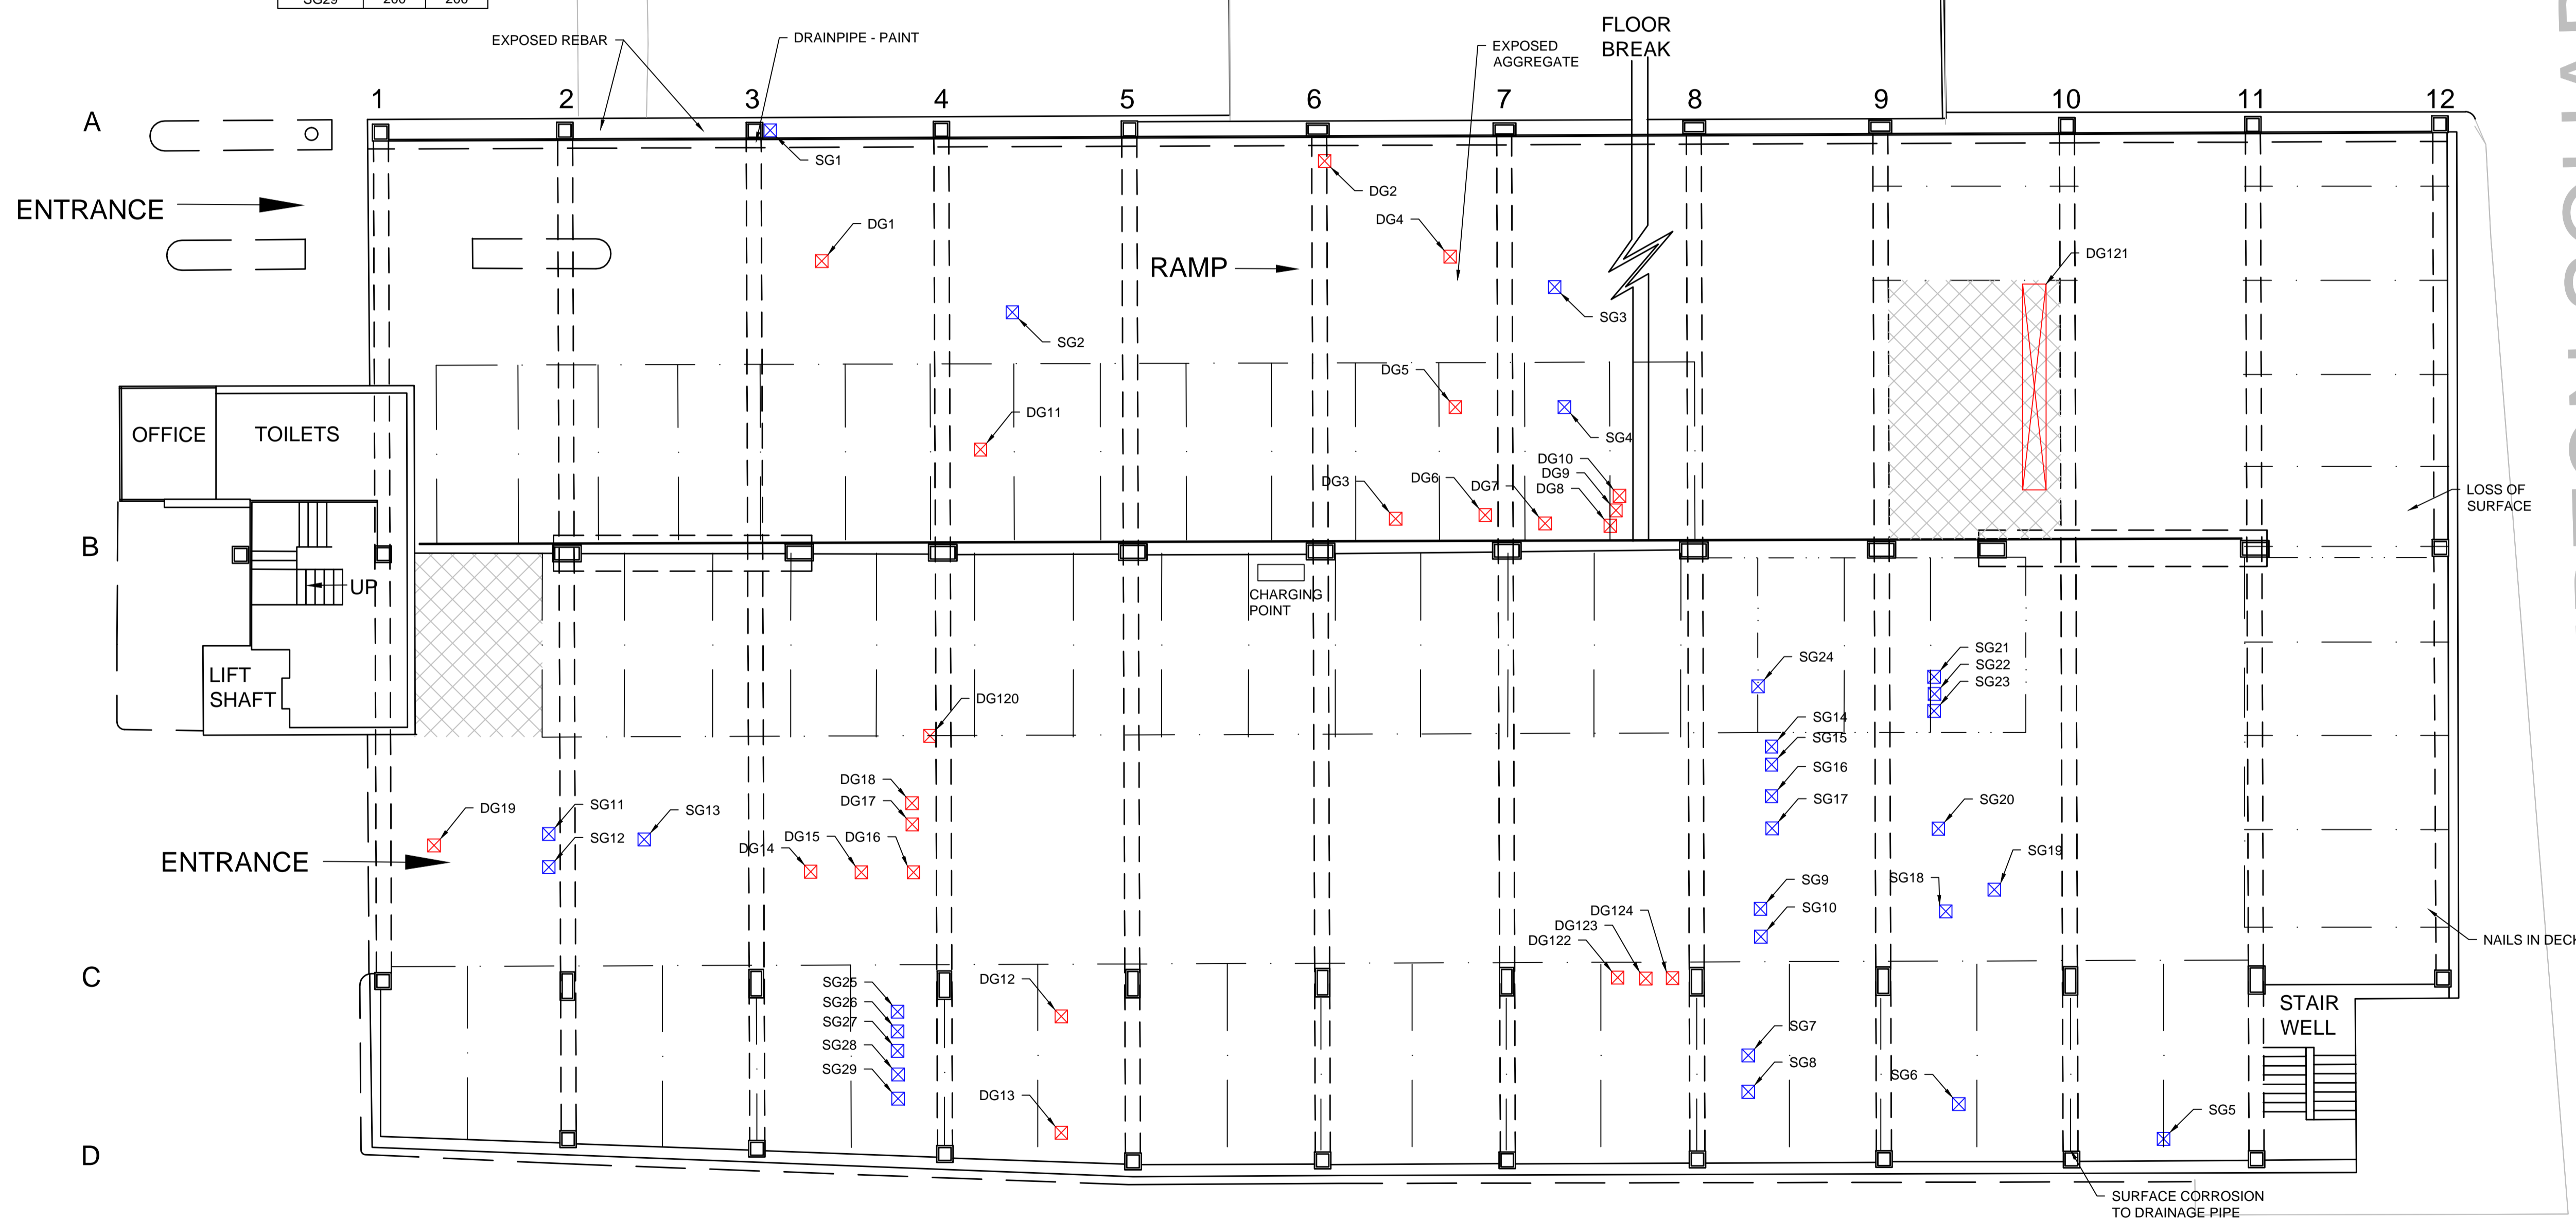

CHATTERTON SQUARE

GROUND FLOOR PLAN
NOT TO SCALE

Rev	By	Chkd	Apprvd	Date	Description
A	FG	AP	RB	13/02/2018	FIRST ISSUE



CH2M HILL
1 The Square Temple Quay Bristol BS1 6DG
Tel +44 (0)117 910 2580 Fax +44 (0)117 910 2581



Project
**TEMPLE GATE MULTI STOREY
CAR PARK STUDY**


Drawing
**TEMPLE GATE
GROUND FLOOR
DEFECTS**

Drawn by: FG	Date: 13/02/2018
Checked by: AP	Date: 13/02/2018
Approved by: RB	Date: 13/02/2018


Drawing No.	Revision
673846-TG-102	A

Drawing Scale: NTS


This map is reproduced from Ordnance Survey® material by Helcrow on behalf of Bristol City Council with the permission of the Controller of Her Majesty's Stationery Office. © Crown copyright. Unauthorised reproduction infringes Crown copyright and may lead to prosecution or civil proceedings. Licence Number: 100023406

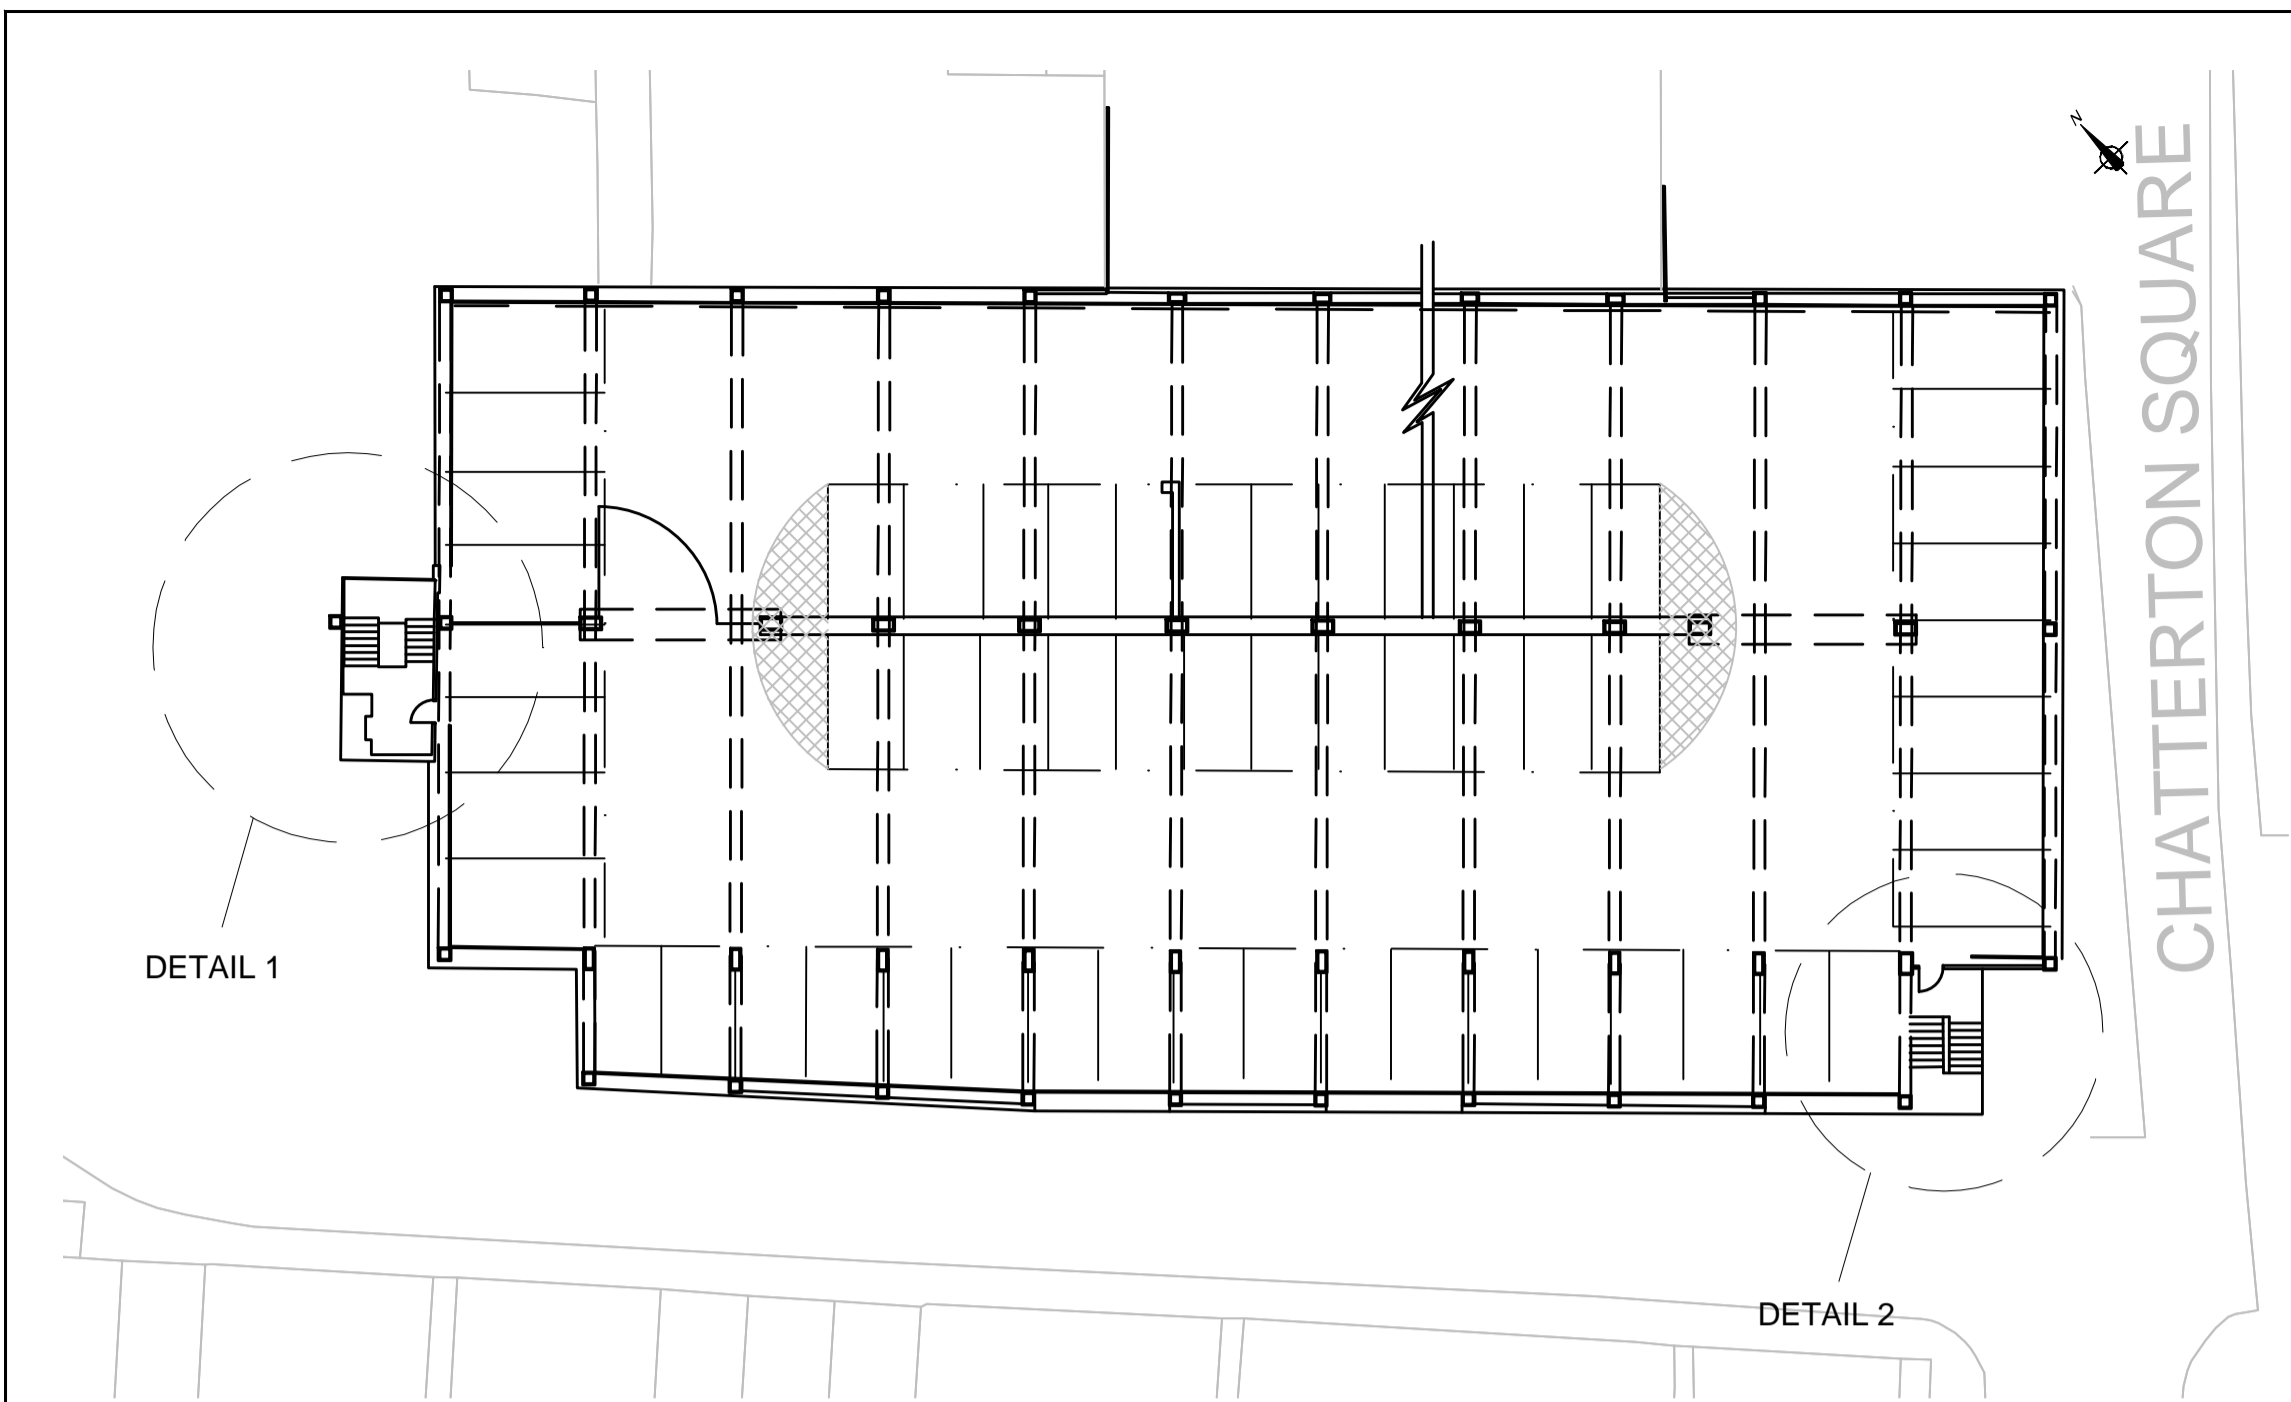

LEVEL 1 FLOOR PLAN
NOT TO SCALE

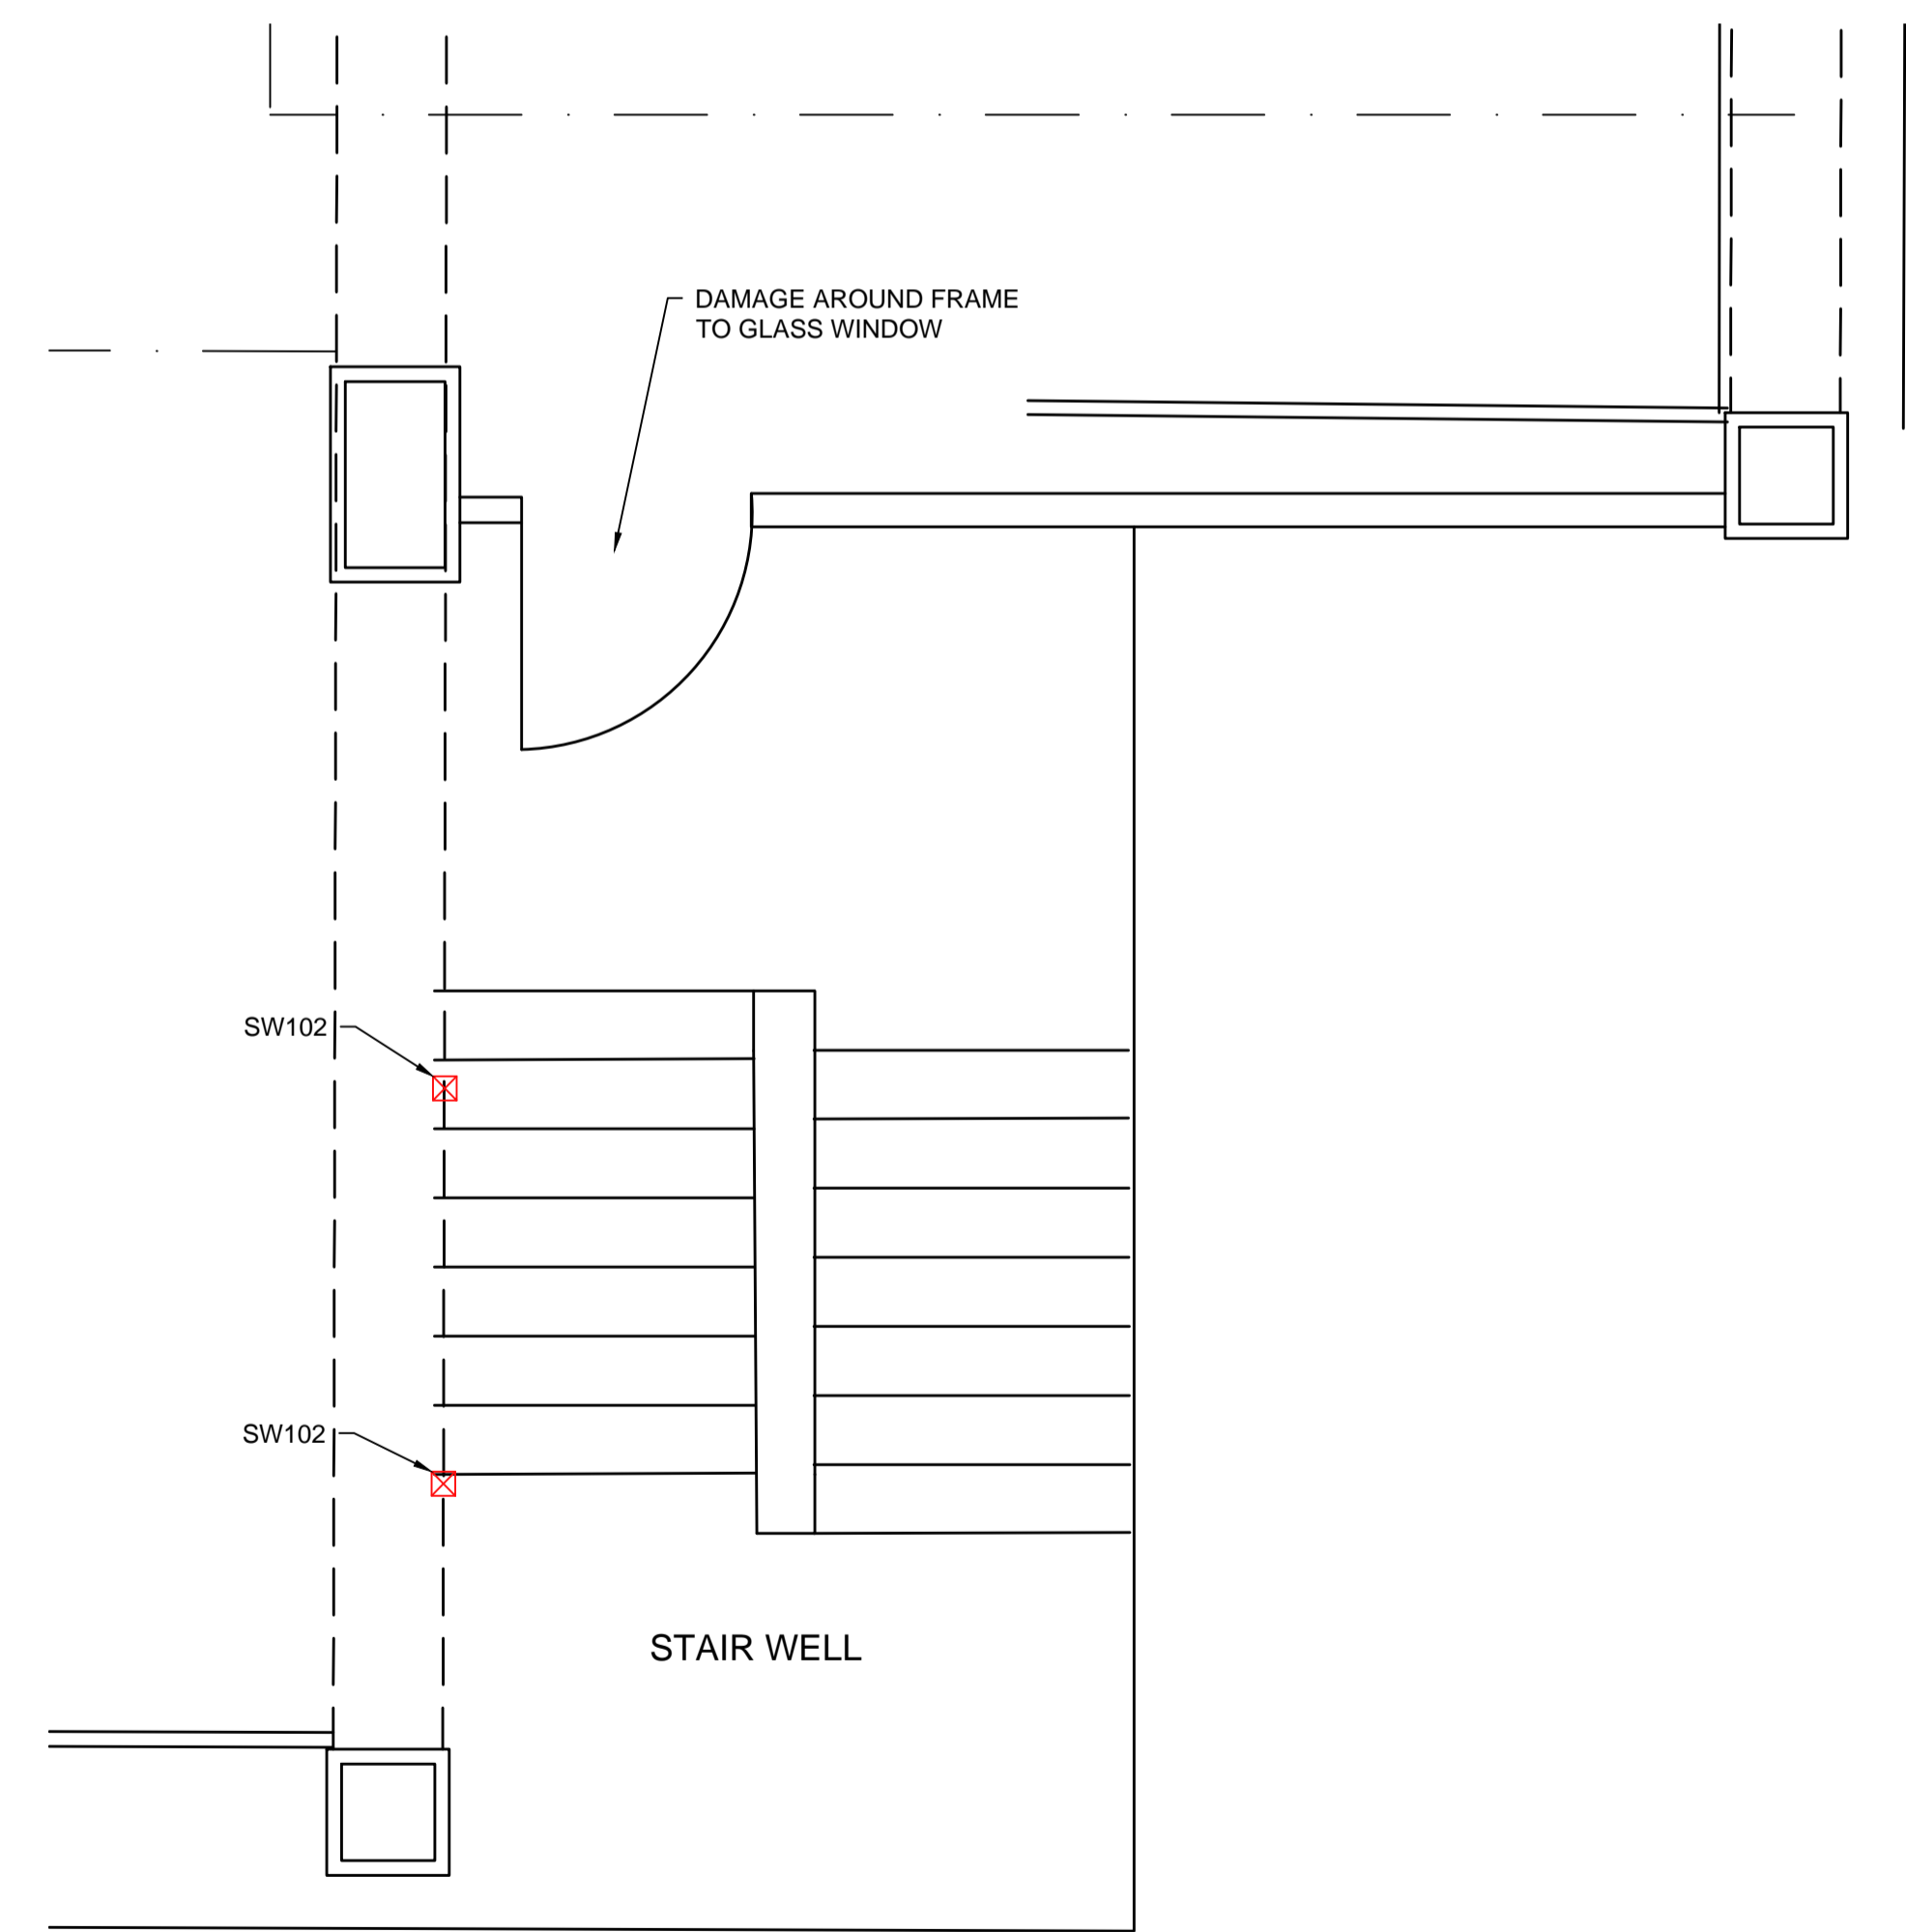

DETAIL 2
NOT TO SCALE

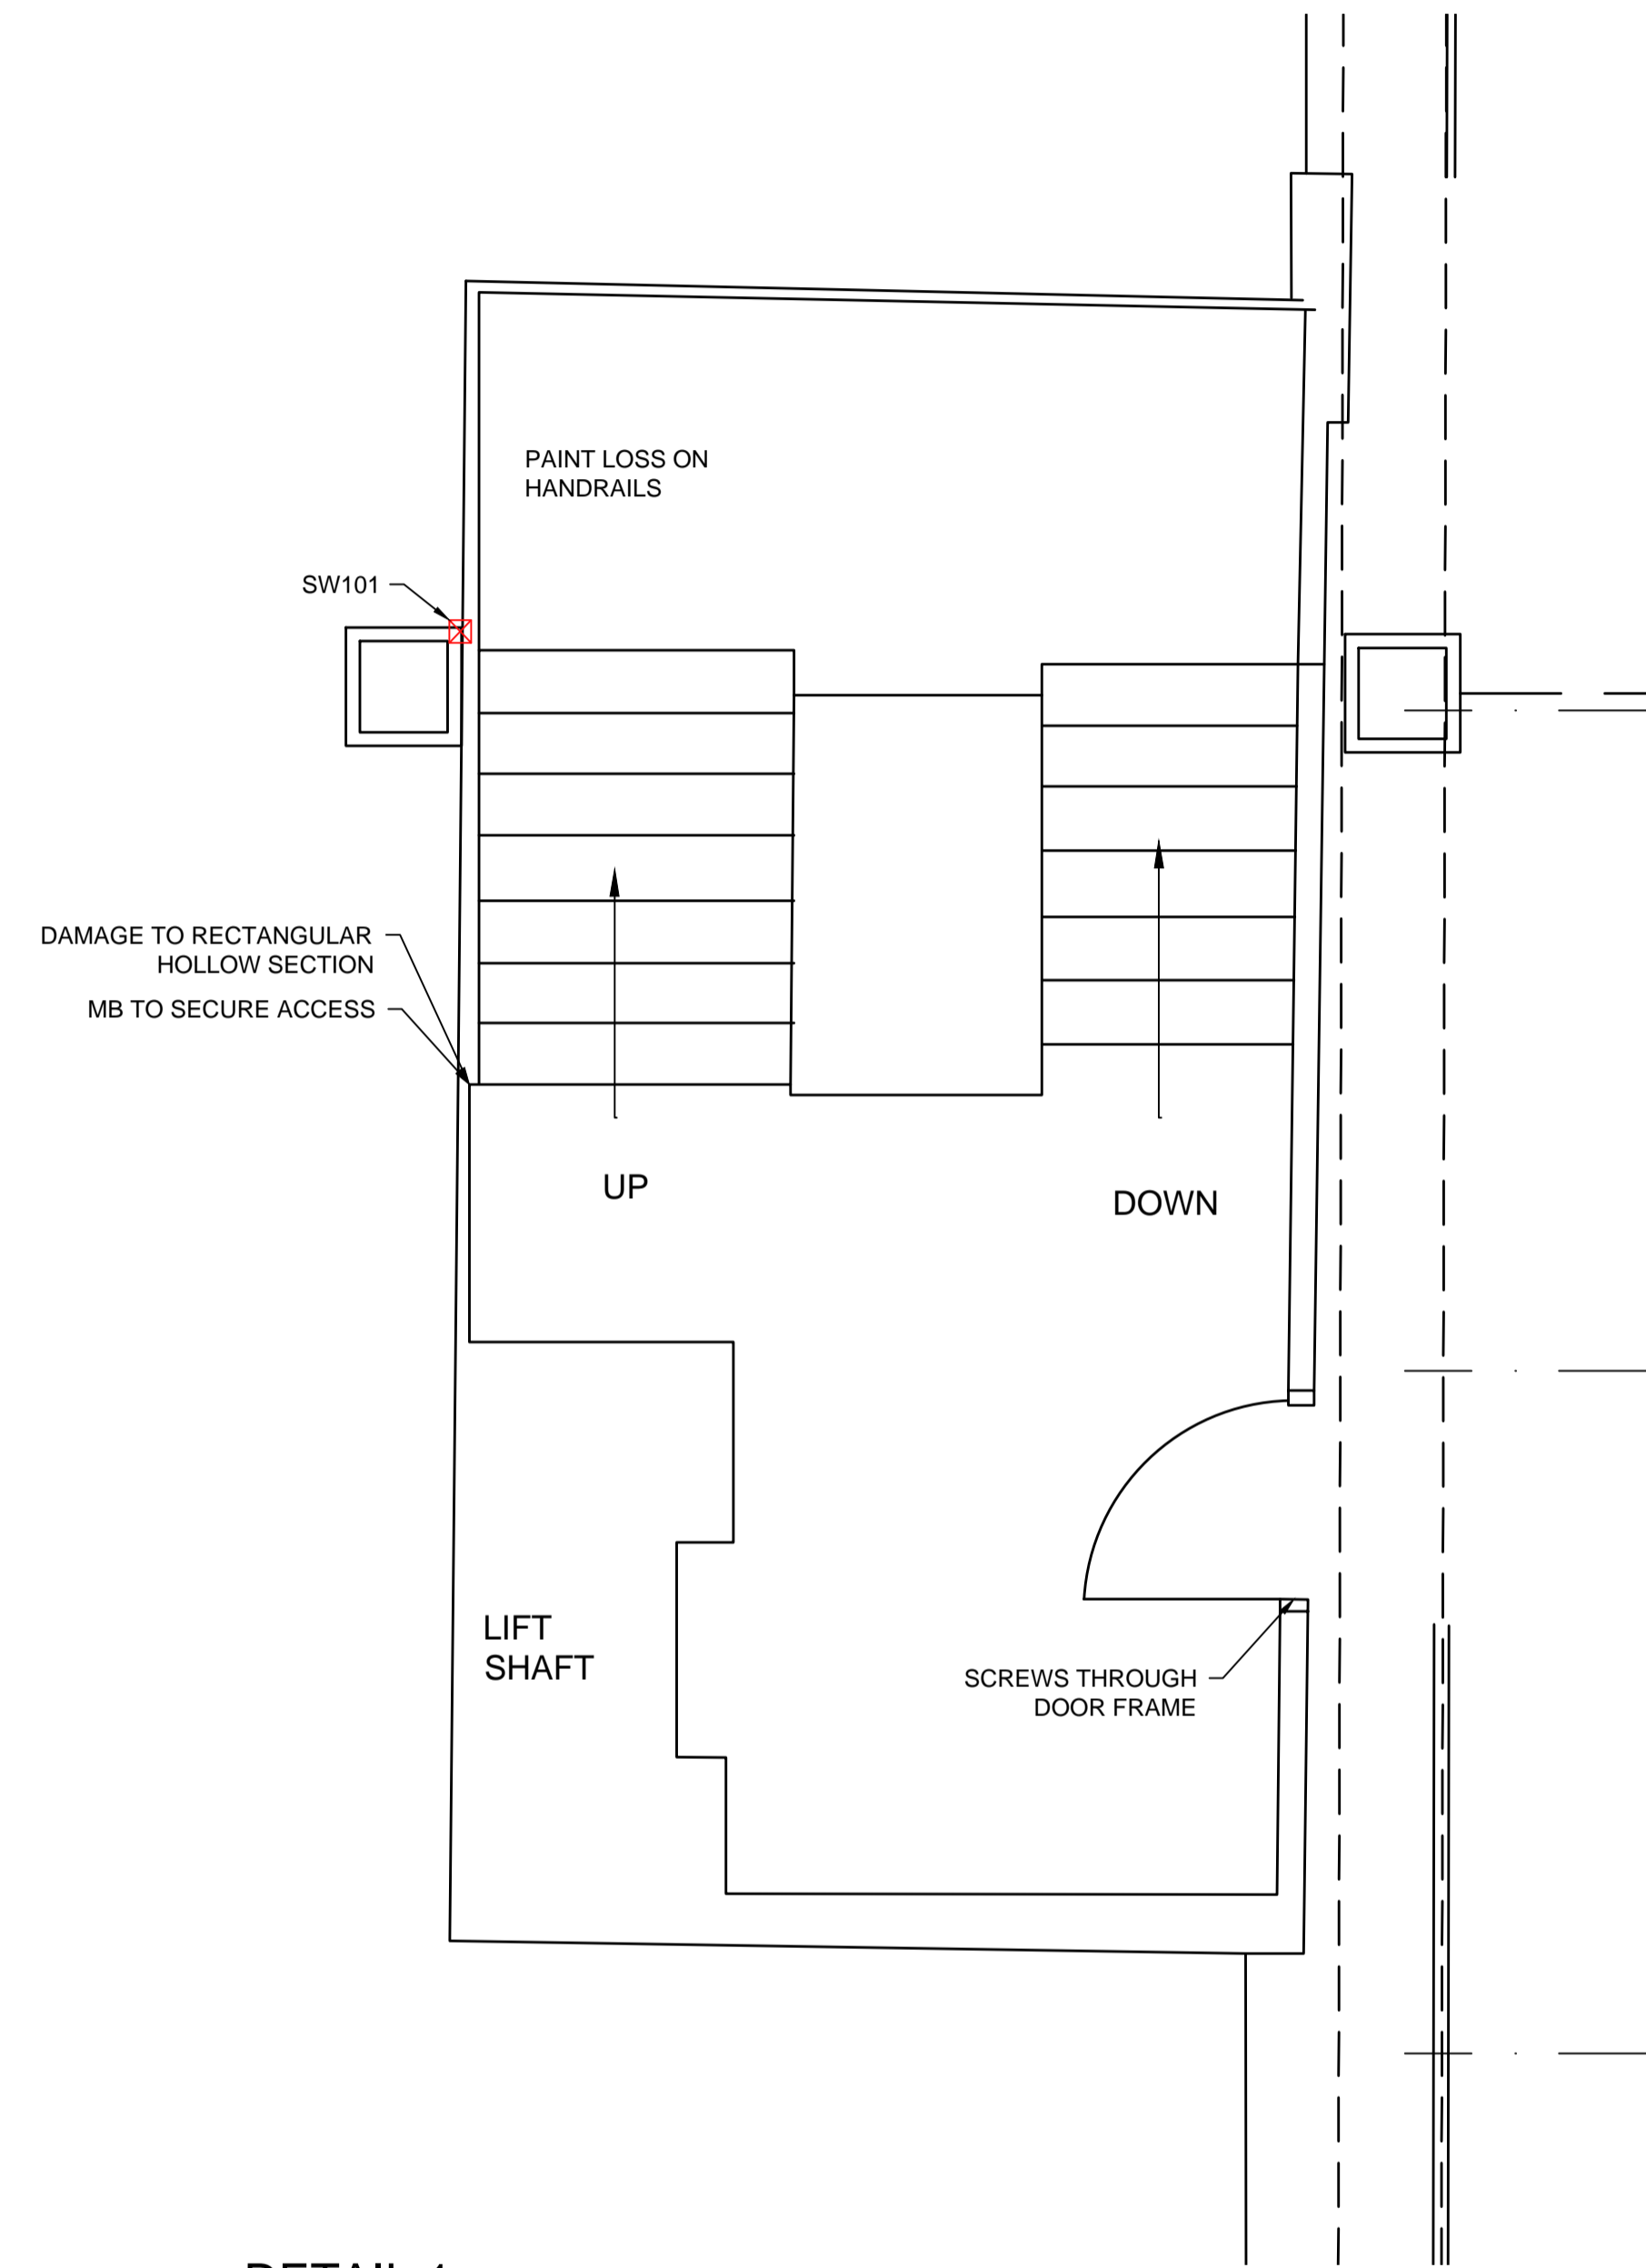

DETAIL 1
NOT TO SCALE

KEY

- MB: MISSING BOLT
- ⊗ STAIR WELL DEFECT

Rev	By	Chkd	Apprvd	Date	Description
A	FG	AP	RB	13/02/2018	FIRST ISSUE



CH2M HILL
1 The Square Temple Quay Bristol BS1 6DG
Tel +44 (0)117 910 2580 Fax +44 (0)117 910 2581



Project
**TEMPLE GATE MULTI STOREY
CAR PARK STUDY**

Drawing
**TEMPLE GATE
LEVEL 1
STAIRCASE DEFECTS**

Drawn by: FG	Date: 13/02/2018
Checked by: AP	Date: 13/02/2018
Approved by: RB	Date: 13/02/2018

Drawing No.	Revision
673846-TG-103	A

Drawing Scale: NTS

CONCRETE REPAIR SCHEDULE
- STAIR WELLS

REPAIR REFERENCE	LENGTH (mm)	WIDTH (mm)
SW101	?	?
SW102	100	150
SW103	100	150

This map is reproduced from Ordnance Survey® material by Halcrow on behalf of Bristol City Council with the permission of the Controller of Her Majesty's Stationery Office. © Crown copyright. Unauthorised reproduction infringes Crown copyright and may lead to prosecution or civil proceedings. Licence Number : 100023406

CONCRETE REPAIR SCHEDULE - DECK		
REPAIR REFERENCE	LENGTH (mm)	WIDTH (mm)
D101	350	150
D102	750	600
D103	400	400
D104	100	100
D105	200	200
D106	100	400
D107	100	600
D108	100	300
D109	100	500
D110	500	400
D111	900	600
D112	300	200
D113	500	100
D114	500	200
D115	700	250
D116	900	300
D117	400	150
D118	600	200
D119	300	150
D120	300	250
D121	200	200
D122	350	150
D123	750	500
D124	400	250
D125	700	100
D126	250	100
D127	250	150
D128	100	150
D129	400	500
D130	550	400
D131	350	200
D132	550	450
D133	1000	600
D134	500	200
D135	150	100
D136	500	500
D137	150	200
D138	200	200
D139	450	200
D140	350	200
D141	150	100
D142	400	800
D143	300	200
D144	500	600
D145	600	400
D146	300	300
D147	100	100


CONCRETE REPAIR SCHEDULE - SOFFIT		
REPAIR REFERENCE	LENGTH (mm)	WIDTH (mm)
S101	900	300
S102	100	100
S103	100	100
S104	150	300
S105	100	100
S106	500	400
S107	500	400
S201	100	100
S202	100	100

CONCRETE REPAIR SCHEDULE - UPSTAND			
REPAIR REFERENCE	HEIGHT (mm)	LENGTH (mm)	WIDTH (mm)
U101	-	100	100
U102	100	250	150
U103	100	150	300
U201	100	400	150
U202	100	100	100
U203	-	500	100
U204	-	100	100

KEY

PPS: PEELING PAINT SOFFIT

- ✘ DECK DEFECT
- ✘ SOFFIT DEFECT
- ✘ UPSTAND DEFECT

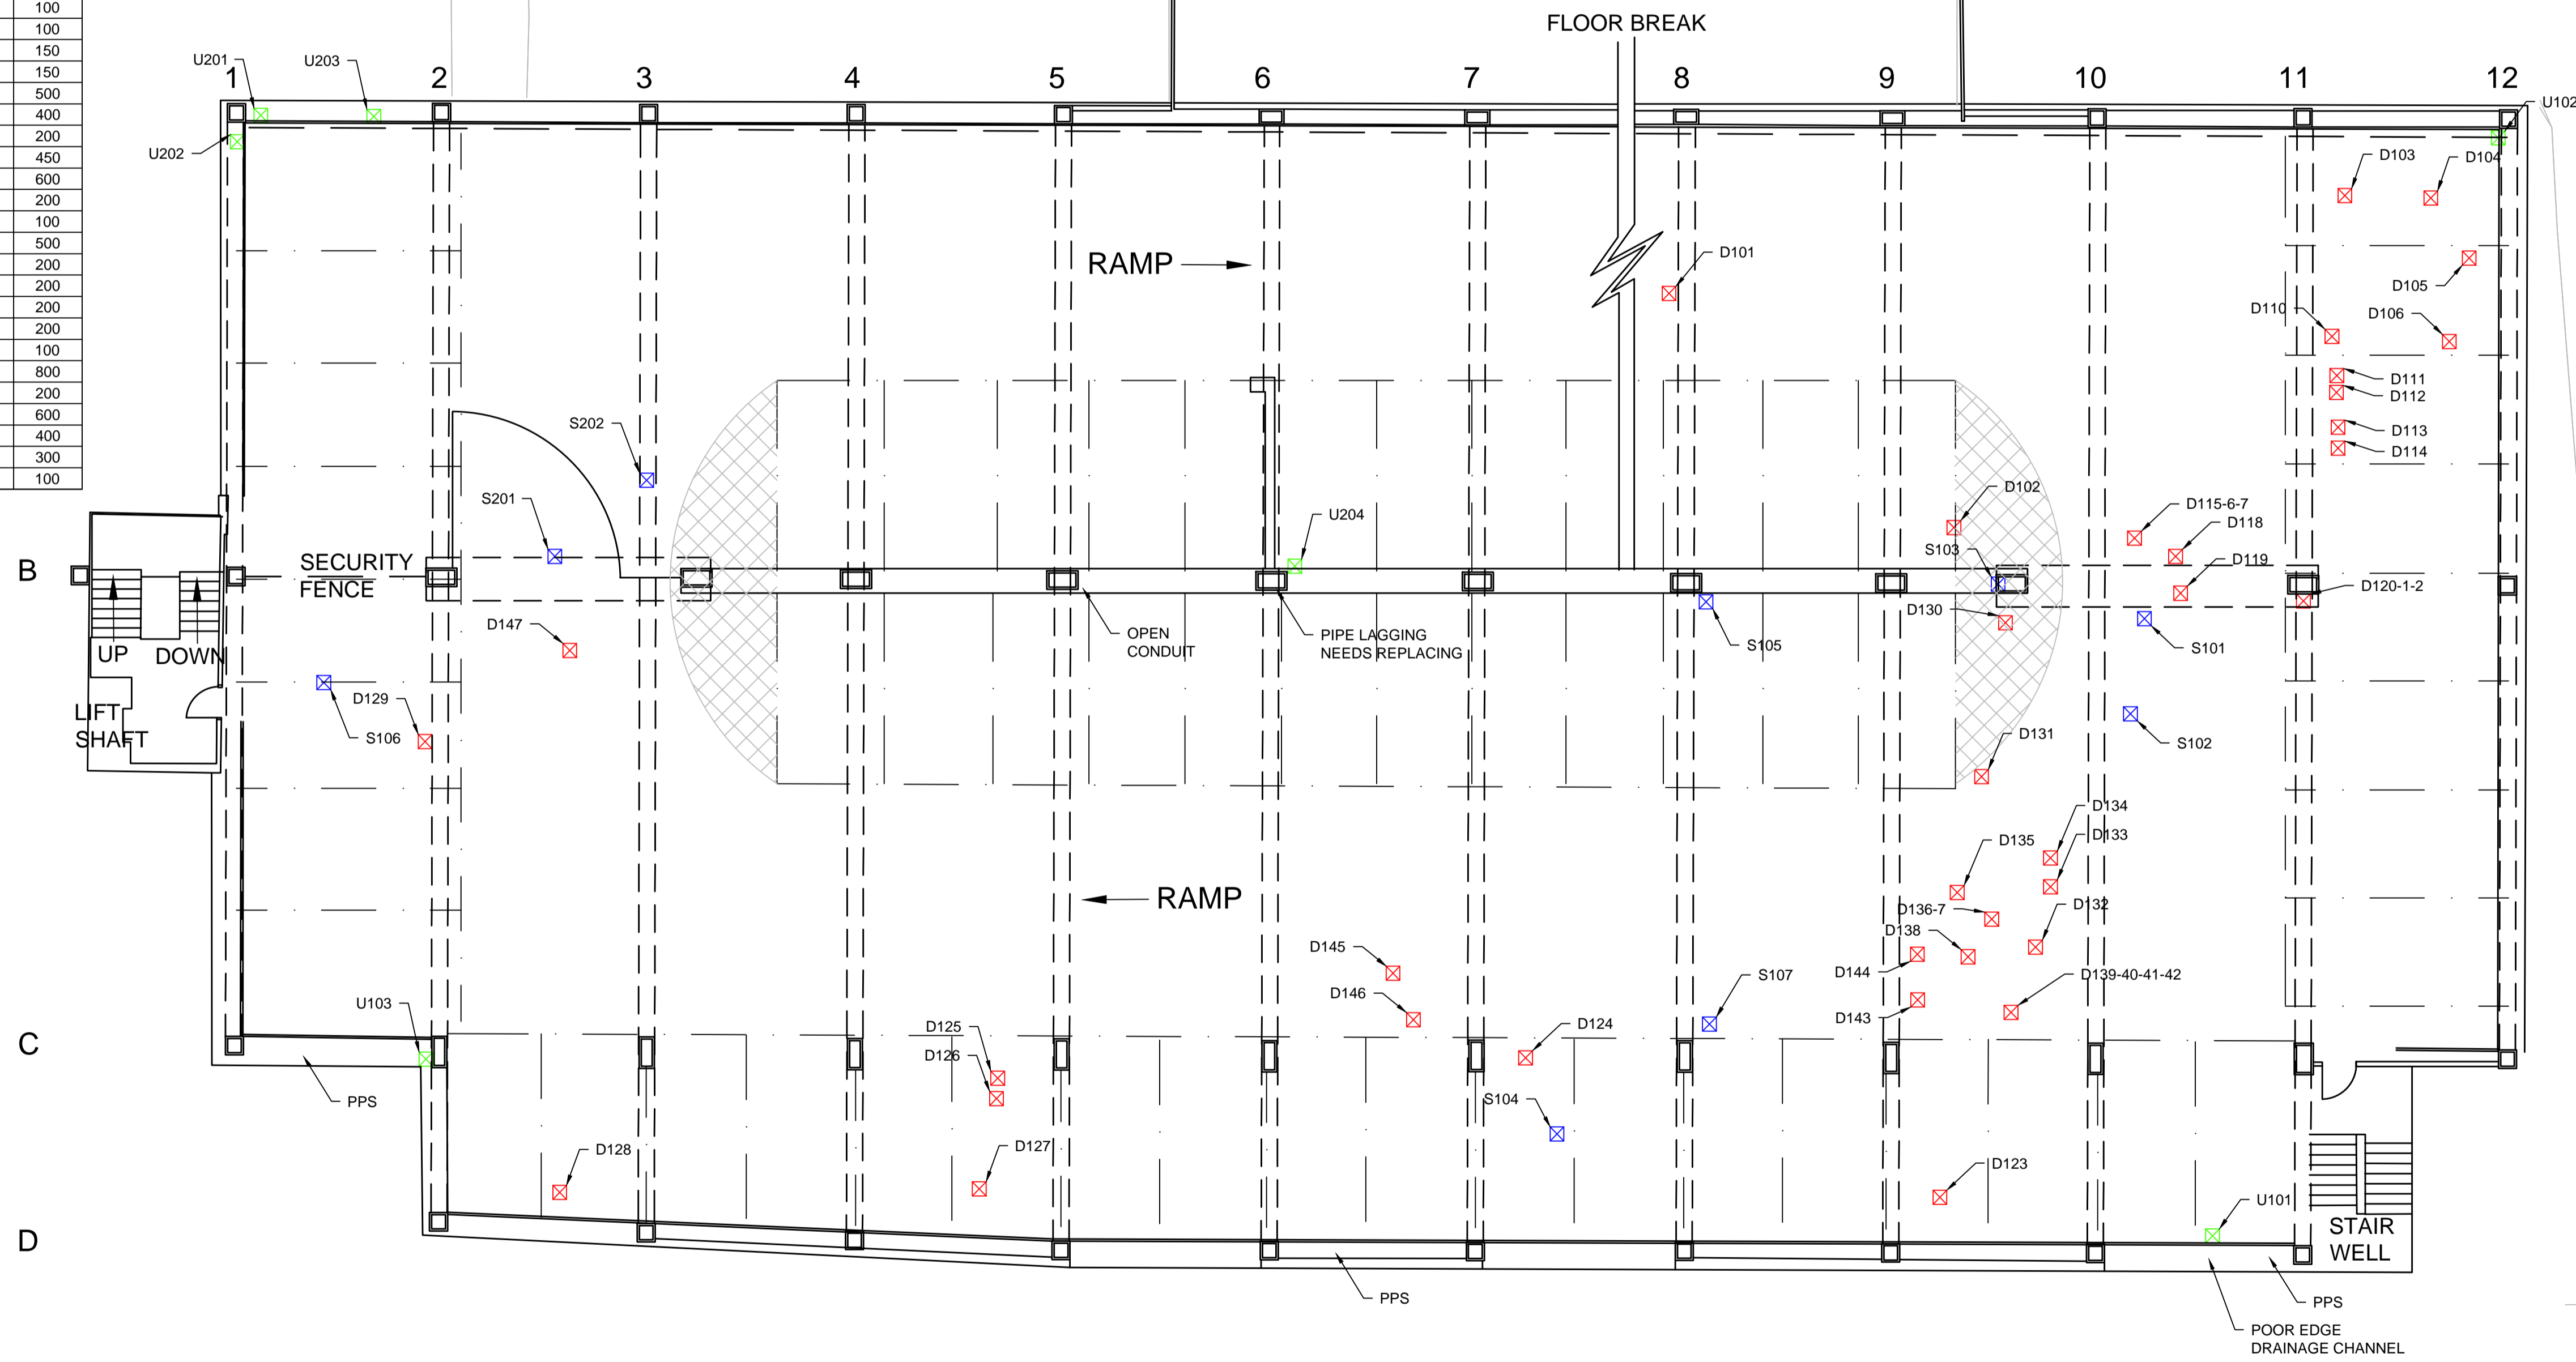

CHATTERTON SQUARE

LEVEL 1 FLOOR PLAN
NOT TO SCALE

This map is reproduced from Ordnance Survey® material by Halcrow on behalf of Bristol City Council with the permission of the Controller of Her Majesty's Stationery Office. © Crown copyright. Unauthorised reproduction infringes Crown copyright and may lead to prosecution or civil proceedings. Licence Number: 100023406

Rev	By	Chkd	Apprvd	Date	Description
A	FG	AP	RB	13/02/2018	FIRST ISSUE



CH2M HILL
1 The Square Temple Quay Bristol BS1 6DG
Tel +44 (0)117 910 2580 Fax +44 (0)117 910 2581



Project: **TEMPLE GATE MULTI STOREY CAR PARK STUDY**

Drawing: **TEMPLE GATE LEVEL 1 DEFECTS**


Drawn by: FG Date: 13/02/2018

Checked by: AP Date: 13/02/2018


Approved by: RB Date: 13/02/2018

Drawing No. 673846-TG-104 Revision A


Drawing Scale: NTS

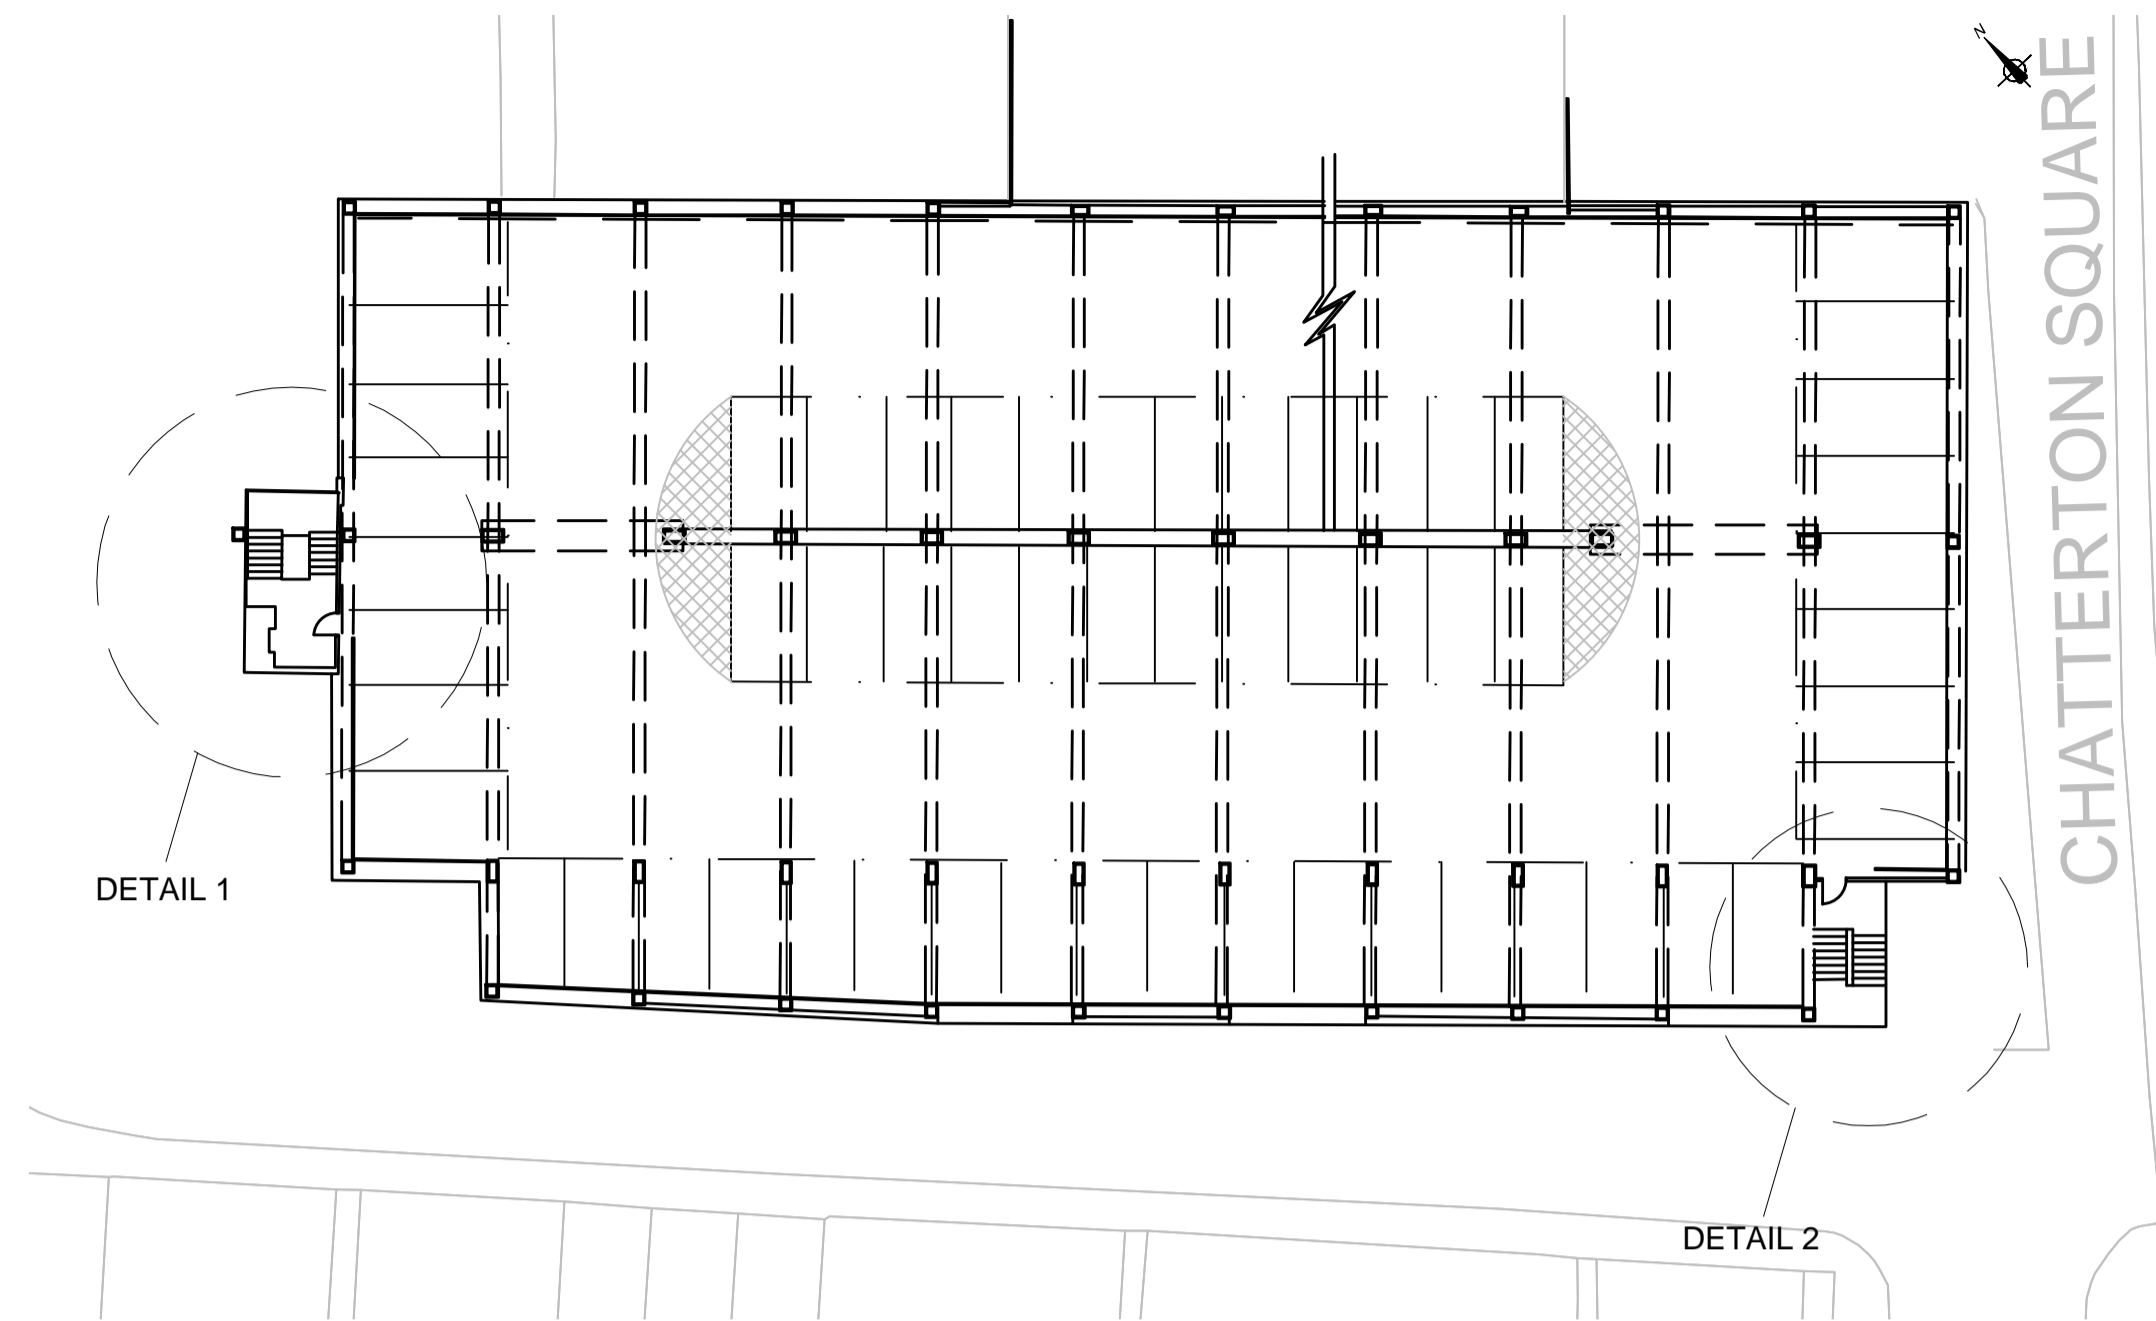

LEVEL 2 FLOOR PLAN
NOT TO SCALE

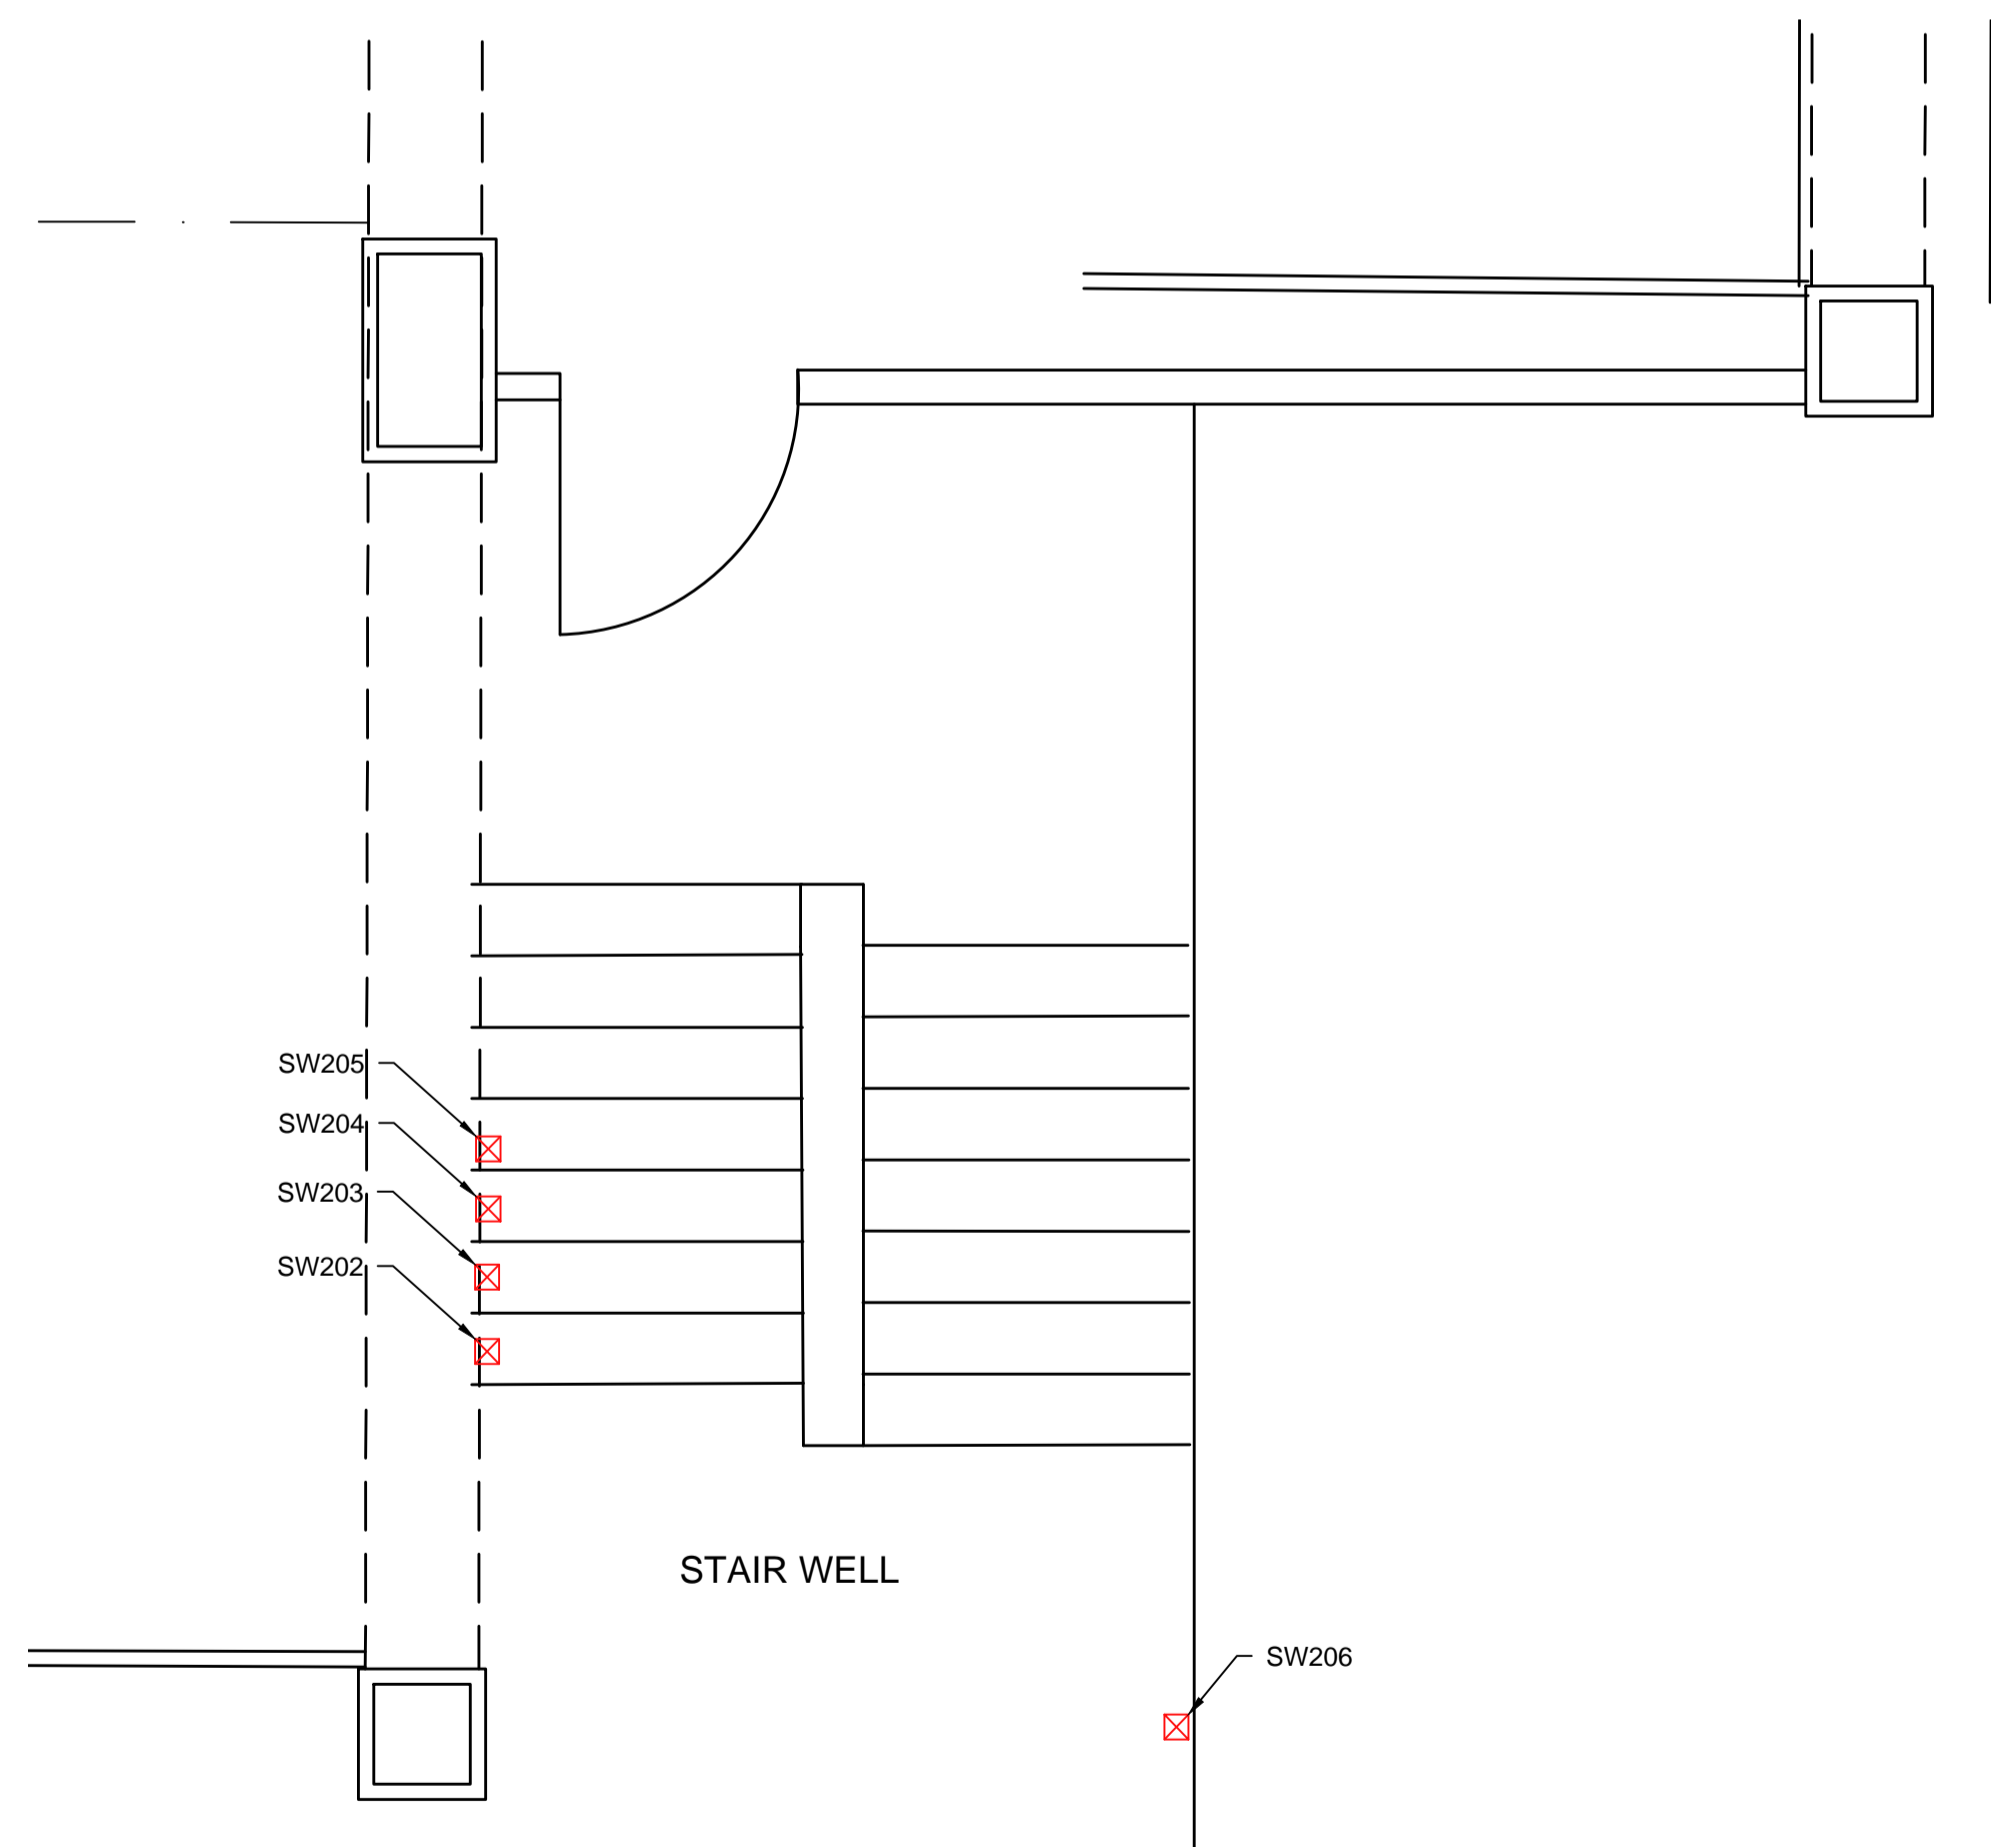

DETAIL 2
NOT TO SCALE

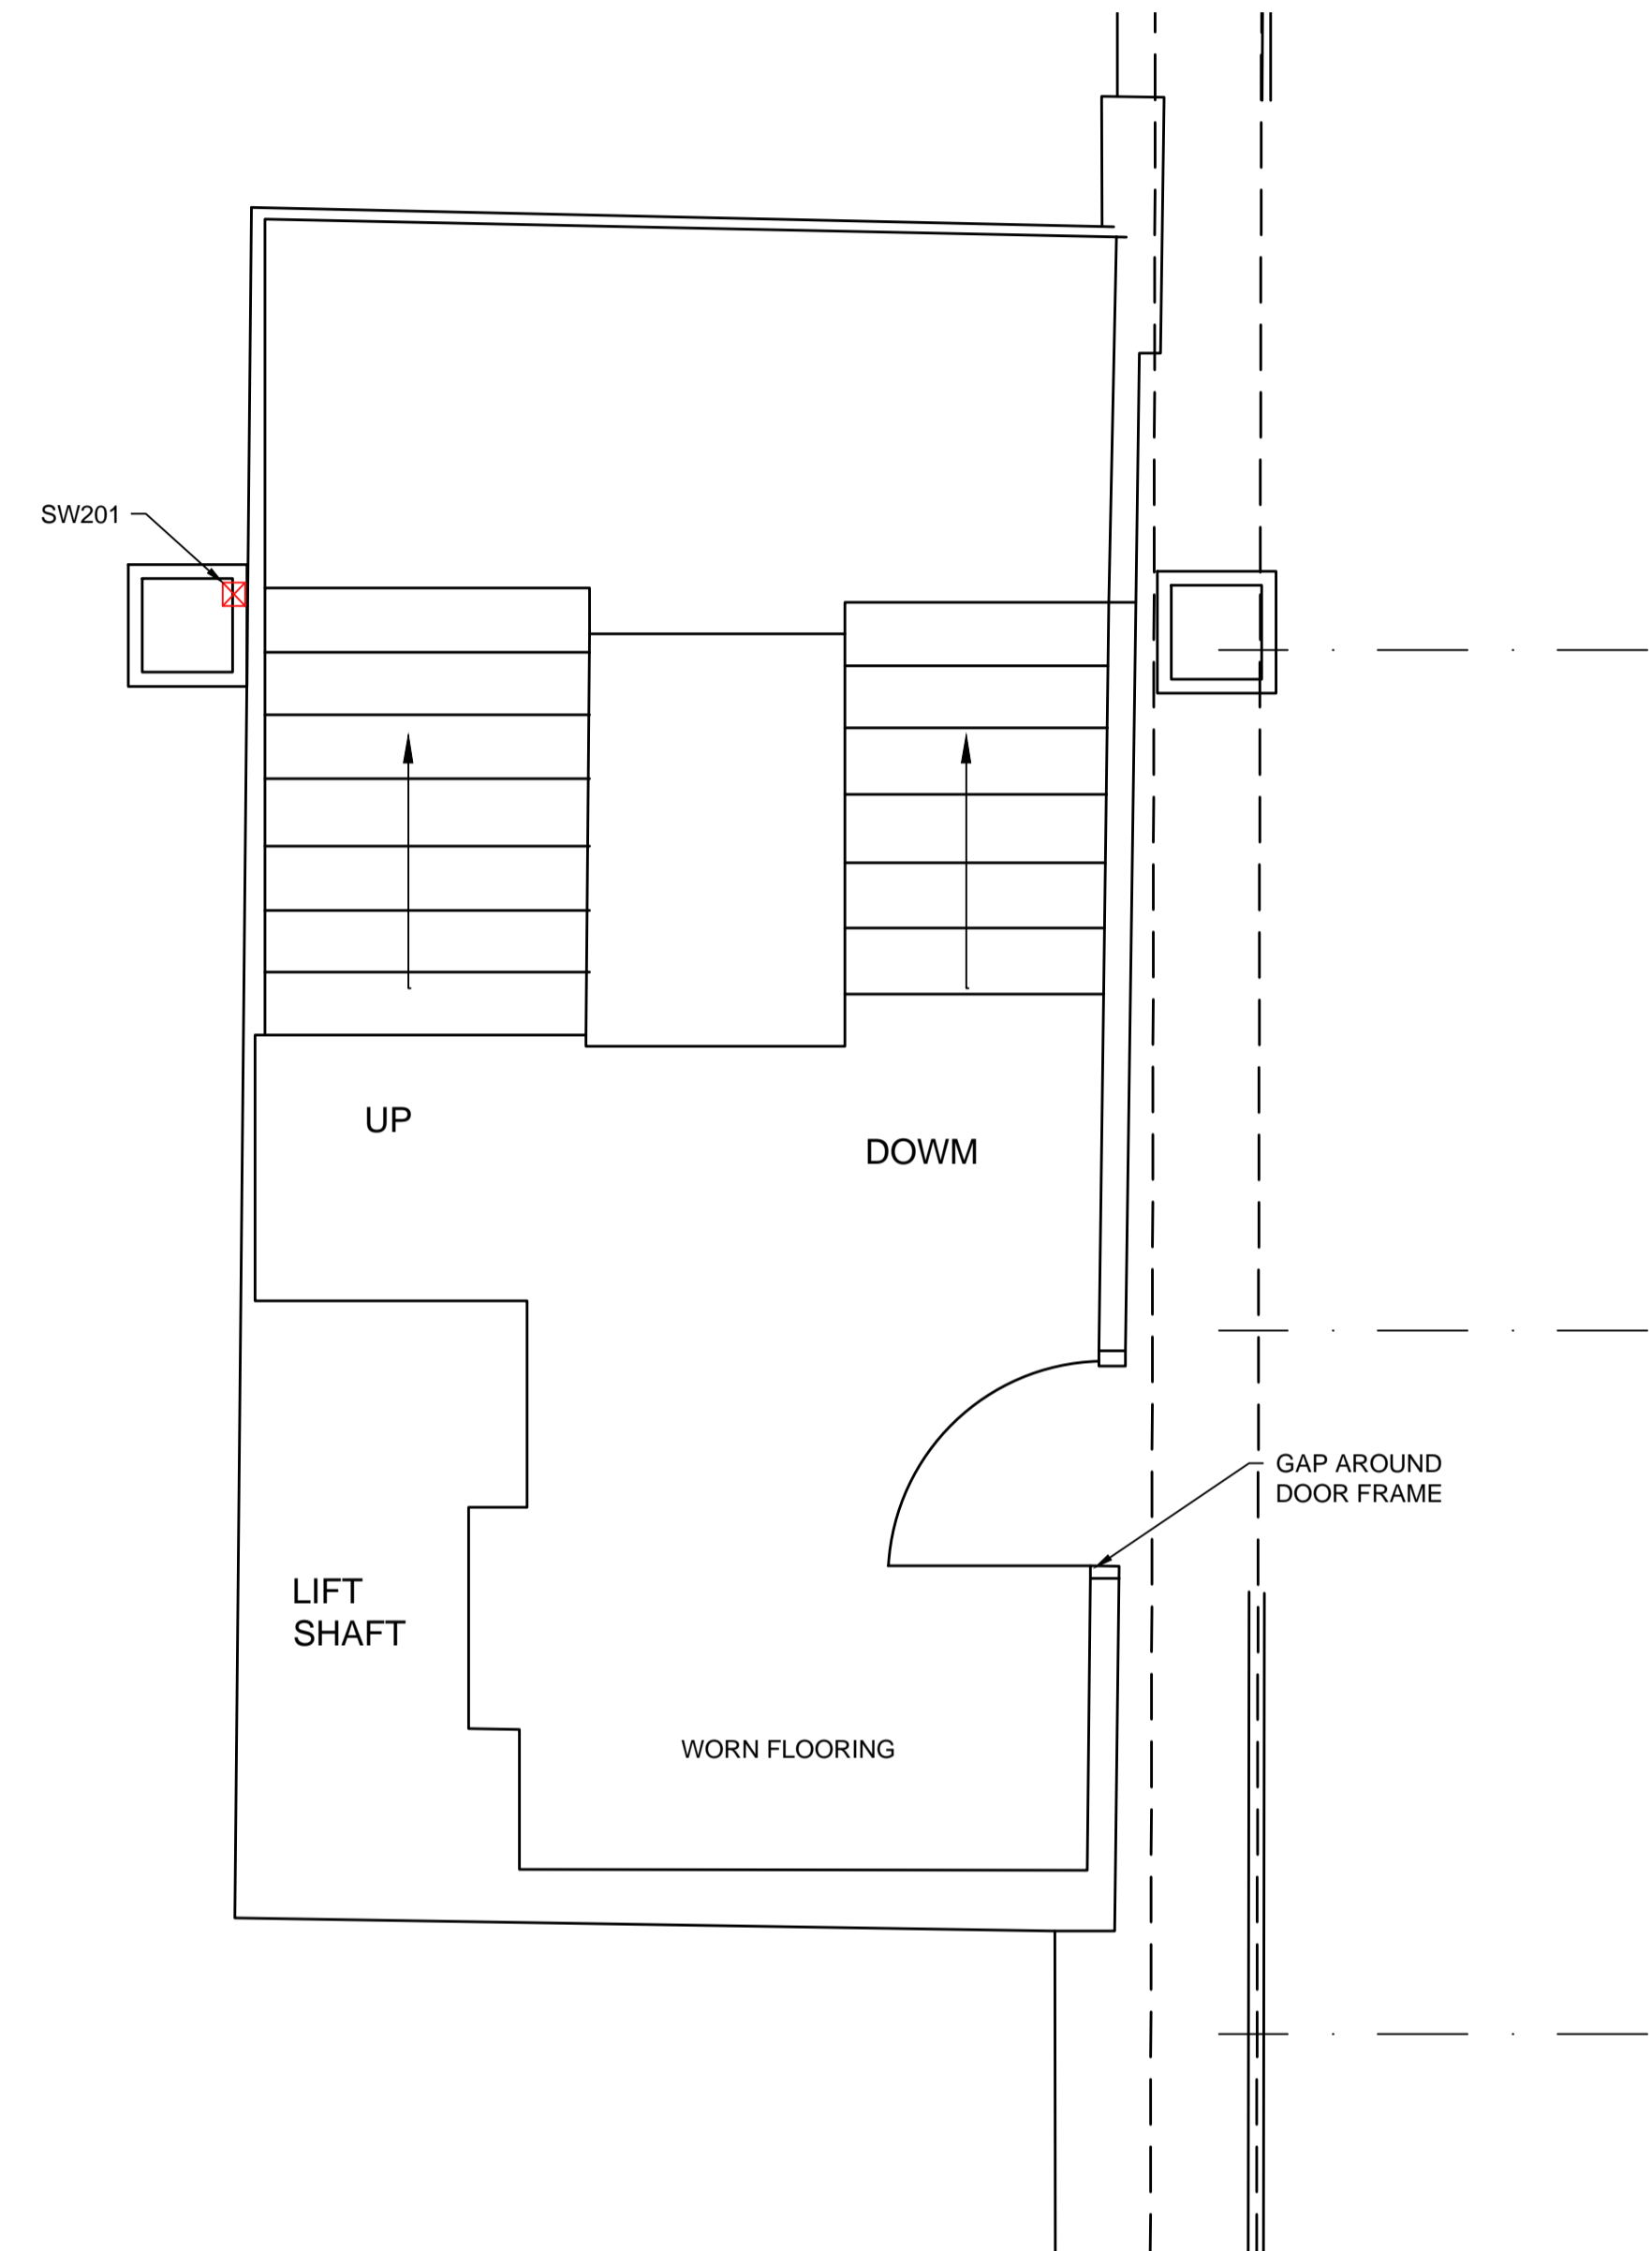

DETAIL 1
NOT TO SCALE

CONCRETE REPAIR SCHEDULE - STAIR WELLS			
REPAIR REFERENCE	HEIGHT (mm)	LENGTH (mm)	WIDTH (mm)
SW201	-	200	100
SW202	250	100	50
SW203	250	100	50
SW204	250	100	50
SW205	250	100	50
SW206	-	400	150

KEY

☒ STAIR WELL DEFECT

Rev	By	Chkd	Apprvd	Date	Description
A	FG	AP	RB	13/02/2018	FIRST ISSUE

Client



CH2M HILL
1 The Square Temple Quay Bristol BS1 6DG
Tel +44 (0)117 910 2580 Fax +44 (0)117 910 2581



Project

**TEMPLE GATE MULTI STOREY
CAR PARK STUDY**

Drawing

**TEMPLE GATE
LEVEL 2
STAIRCASE DEFECTS**

Drawn by: FG Date: 13/02/2018

Checked by: AP Date: 13/02/2018

Approved by: RB Date: 13/02/2018

Drawing No. Revision

673846-TG-105

A

Drawing Scale: NTS


CONCRETE REPAIR SCHEDULE - DECK		
REPAIR REFERENCE	LENGTH (mm)	WIDTH (mm)
D201	100	150
D202	500	150
D203	300	400
D204	100	100
D205	200	250
D206	500	250
D207	100	150
D208	700	450
D209	500	300
D210	300	300
D211	300	200
D212	250	350
D301	250	250
D302	200	200
D303	450	500
D304	100	100
D305	500	200
D306	250	200
D307	300	400

CONCRETE REPAIR SCHEDULE - SOFFIT		
REPAIR REFERENCE	LENGTH (mm)	WIDTH (mm)
S203	100	100
S204	200	200
S205	100	200
S206	100	200
S207	100	200
S208	100	100
S209	500	100
S210	100	100
S211	200	300
S212	200	200
S213	200	200
S214	100	100
S215	300	300
S216	300	300
S217	200	100
S218	400	200
S219	200	200??

CONCRETE REPAIR SCHEDULE - UPSTAND			
REPAIR REFERENCE	HEIGHT (mm)	LENGTH (mm)	WIDTH (mm)
U205	-	100	100
U206	100	150	300
U207	-	100	200
U208	-	100	100
U209	-	300	200
U210	-	100	100
U211	-	100	100
U212	-	200	150
U213	-	400	200
U214	-	100	100
U215	-	200	150
U216	-	400	100
U217	-	350	200
U218	-	450	150
U219	-	100	100
U220	-	100	100
U301	100	300	100
U302	100	200	150

KEY

- ✘ DECK DEFECT
- ✘ SOFFIT DEFECT
- ✘ UPSTAND DEFECT

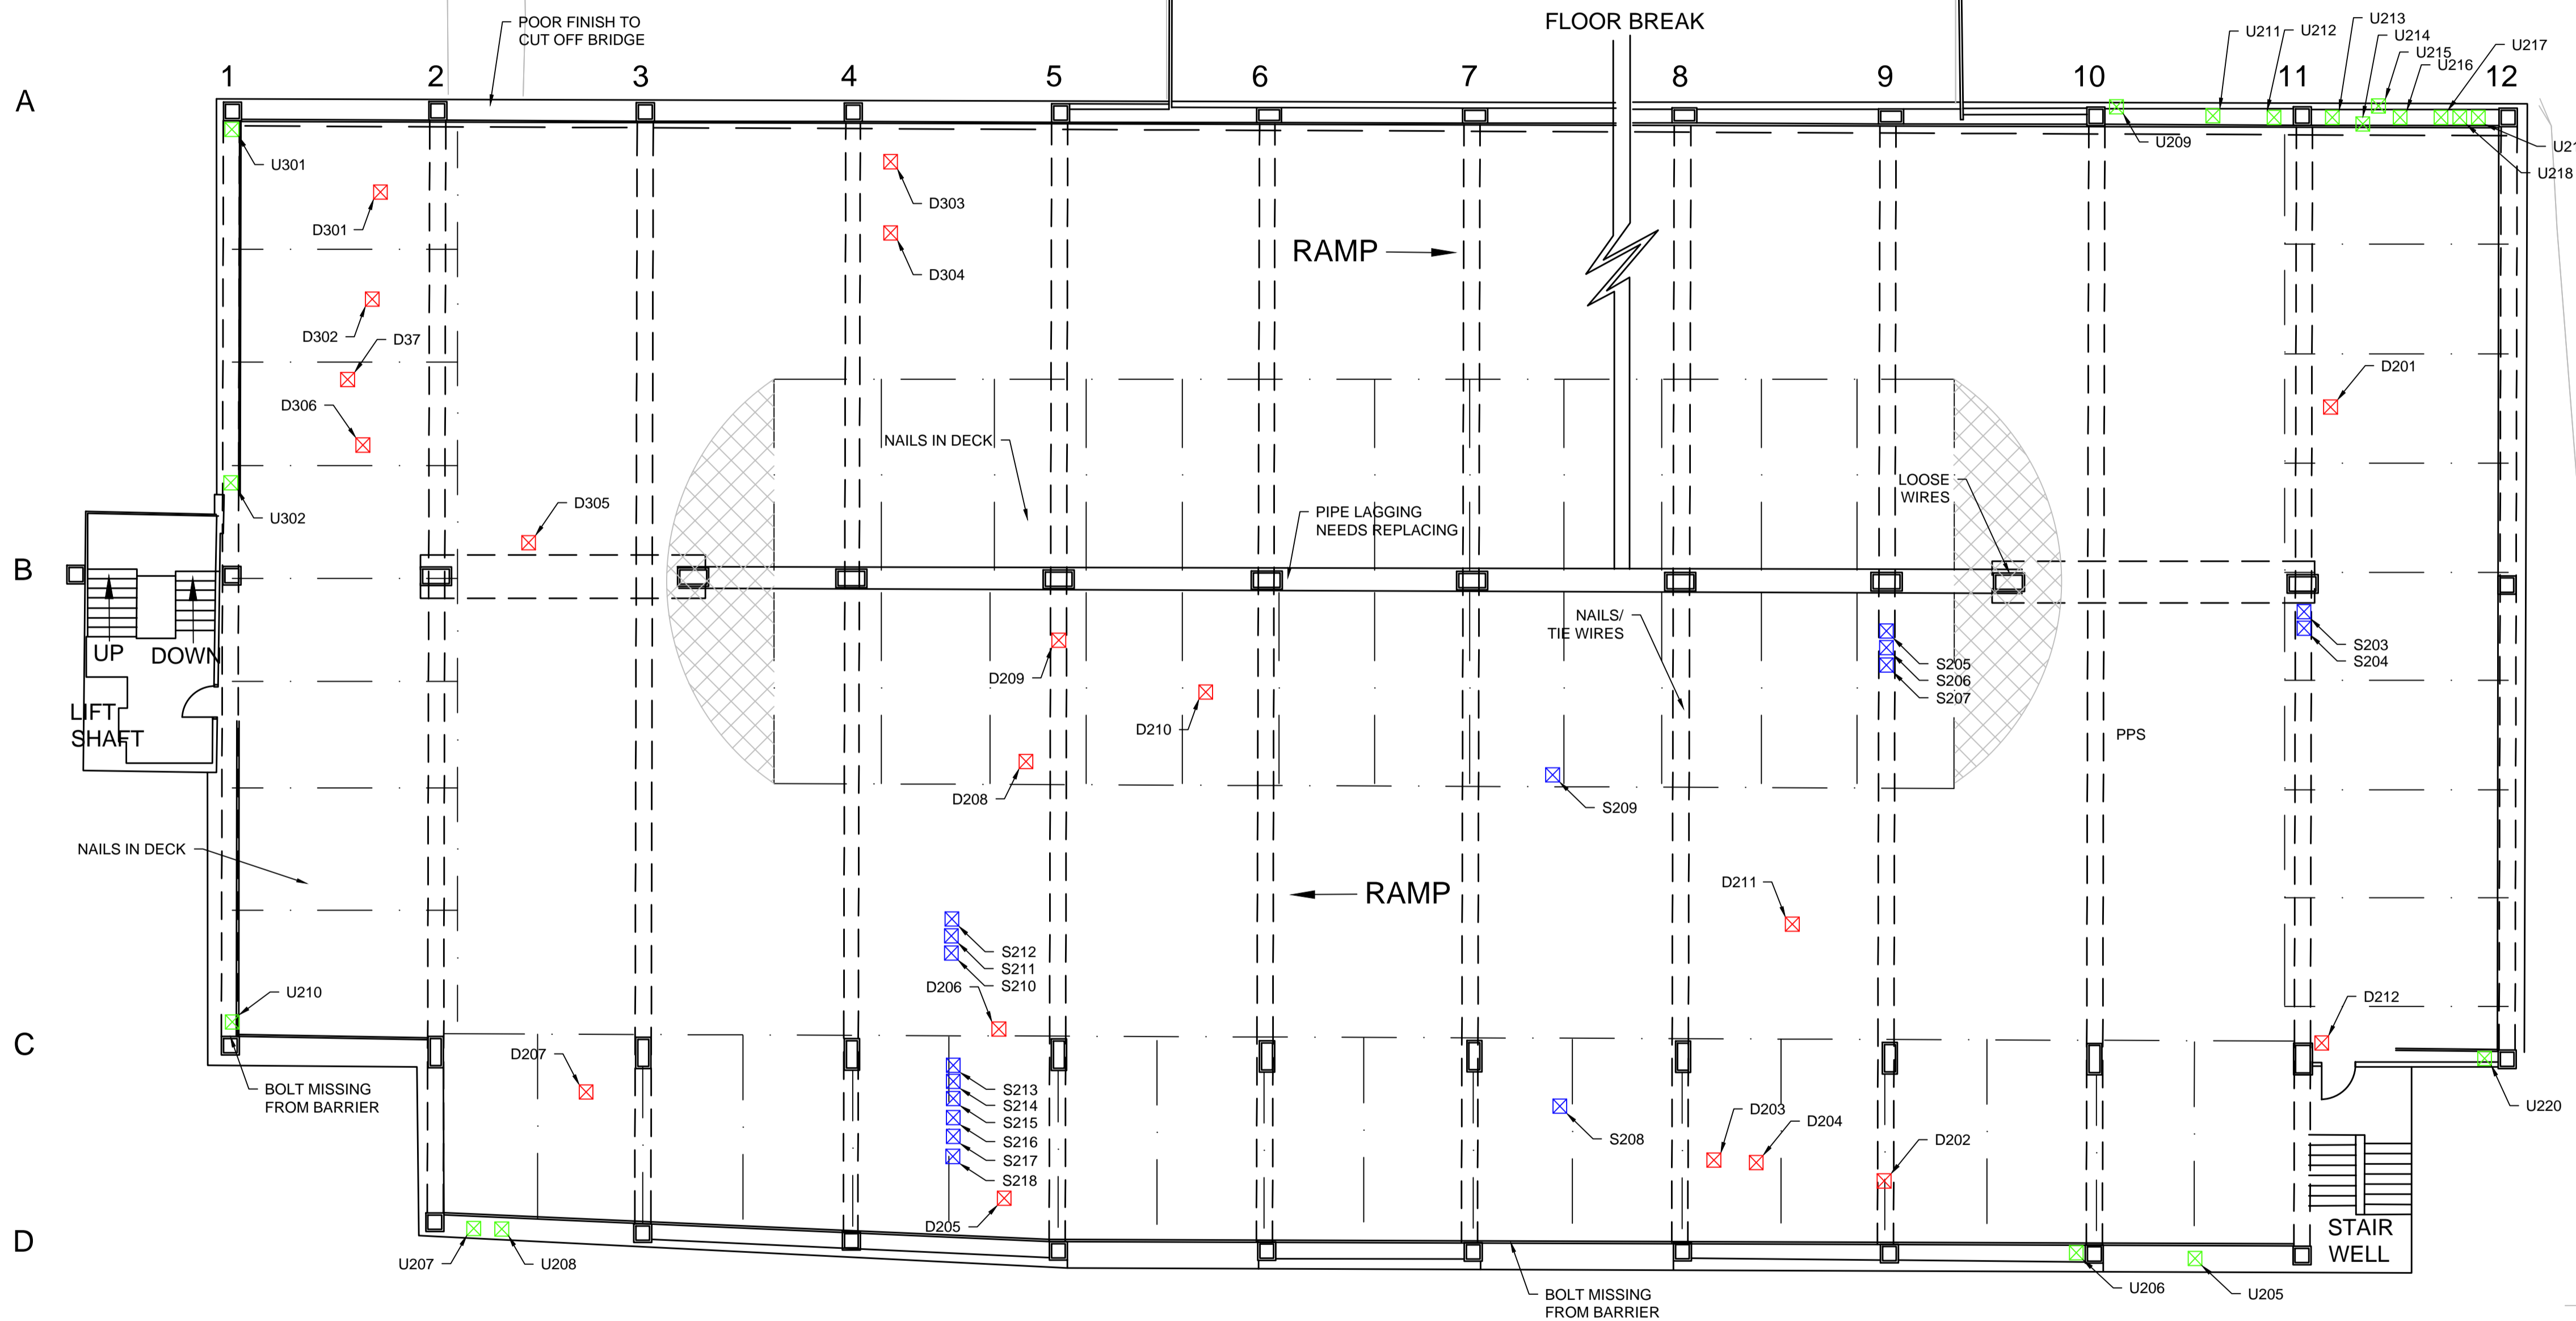

CHATTERTON SQUARE

LEVEL 2 FLOOR PLAN
NOT TO SCALE

This map is reproduced from Ordnance Survey® material by Halcrow on behalf of Bristol City Council with the permission of the Controller of Her Majesty's Stationery Office. © Crown copyright. Unauthorised reproduction infringes Crown copyright and may lead to prosecution or civil proceedings. Licence Number :100023406

Rev	By	Chkd	Apprvd	Date	Description
A	FG	AP	RB	13/02/2018	FIRST ISSUE



CH2M HILL
1 The Square Temple Quay Bristol BS1 6DG
Tel +44 (0)117 910 2580 Fax +44 (0)117 910 2581




Project
**TEMPLE GATE MULTI STOREY
CAR PARK STUDY**

Drawing
**TEMPLE GATE
LEVEL 2
DEFECTS**


Drawn by: FG	Date: 13/02/2018
Checked by: AP	Date: 13/02/2018
Approved by: RB	Date: 13/02/2018

Drawing No.	Revision
673846-TG-106	A


Drawing Scale: NTS

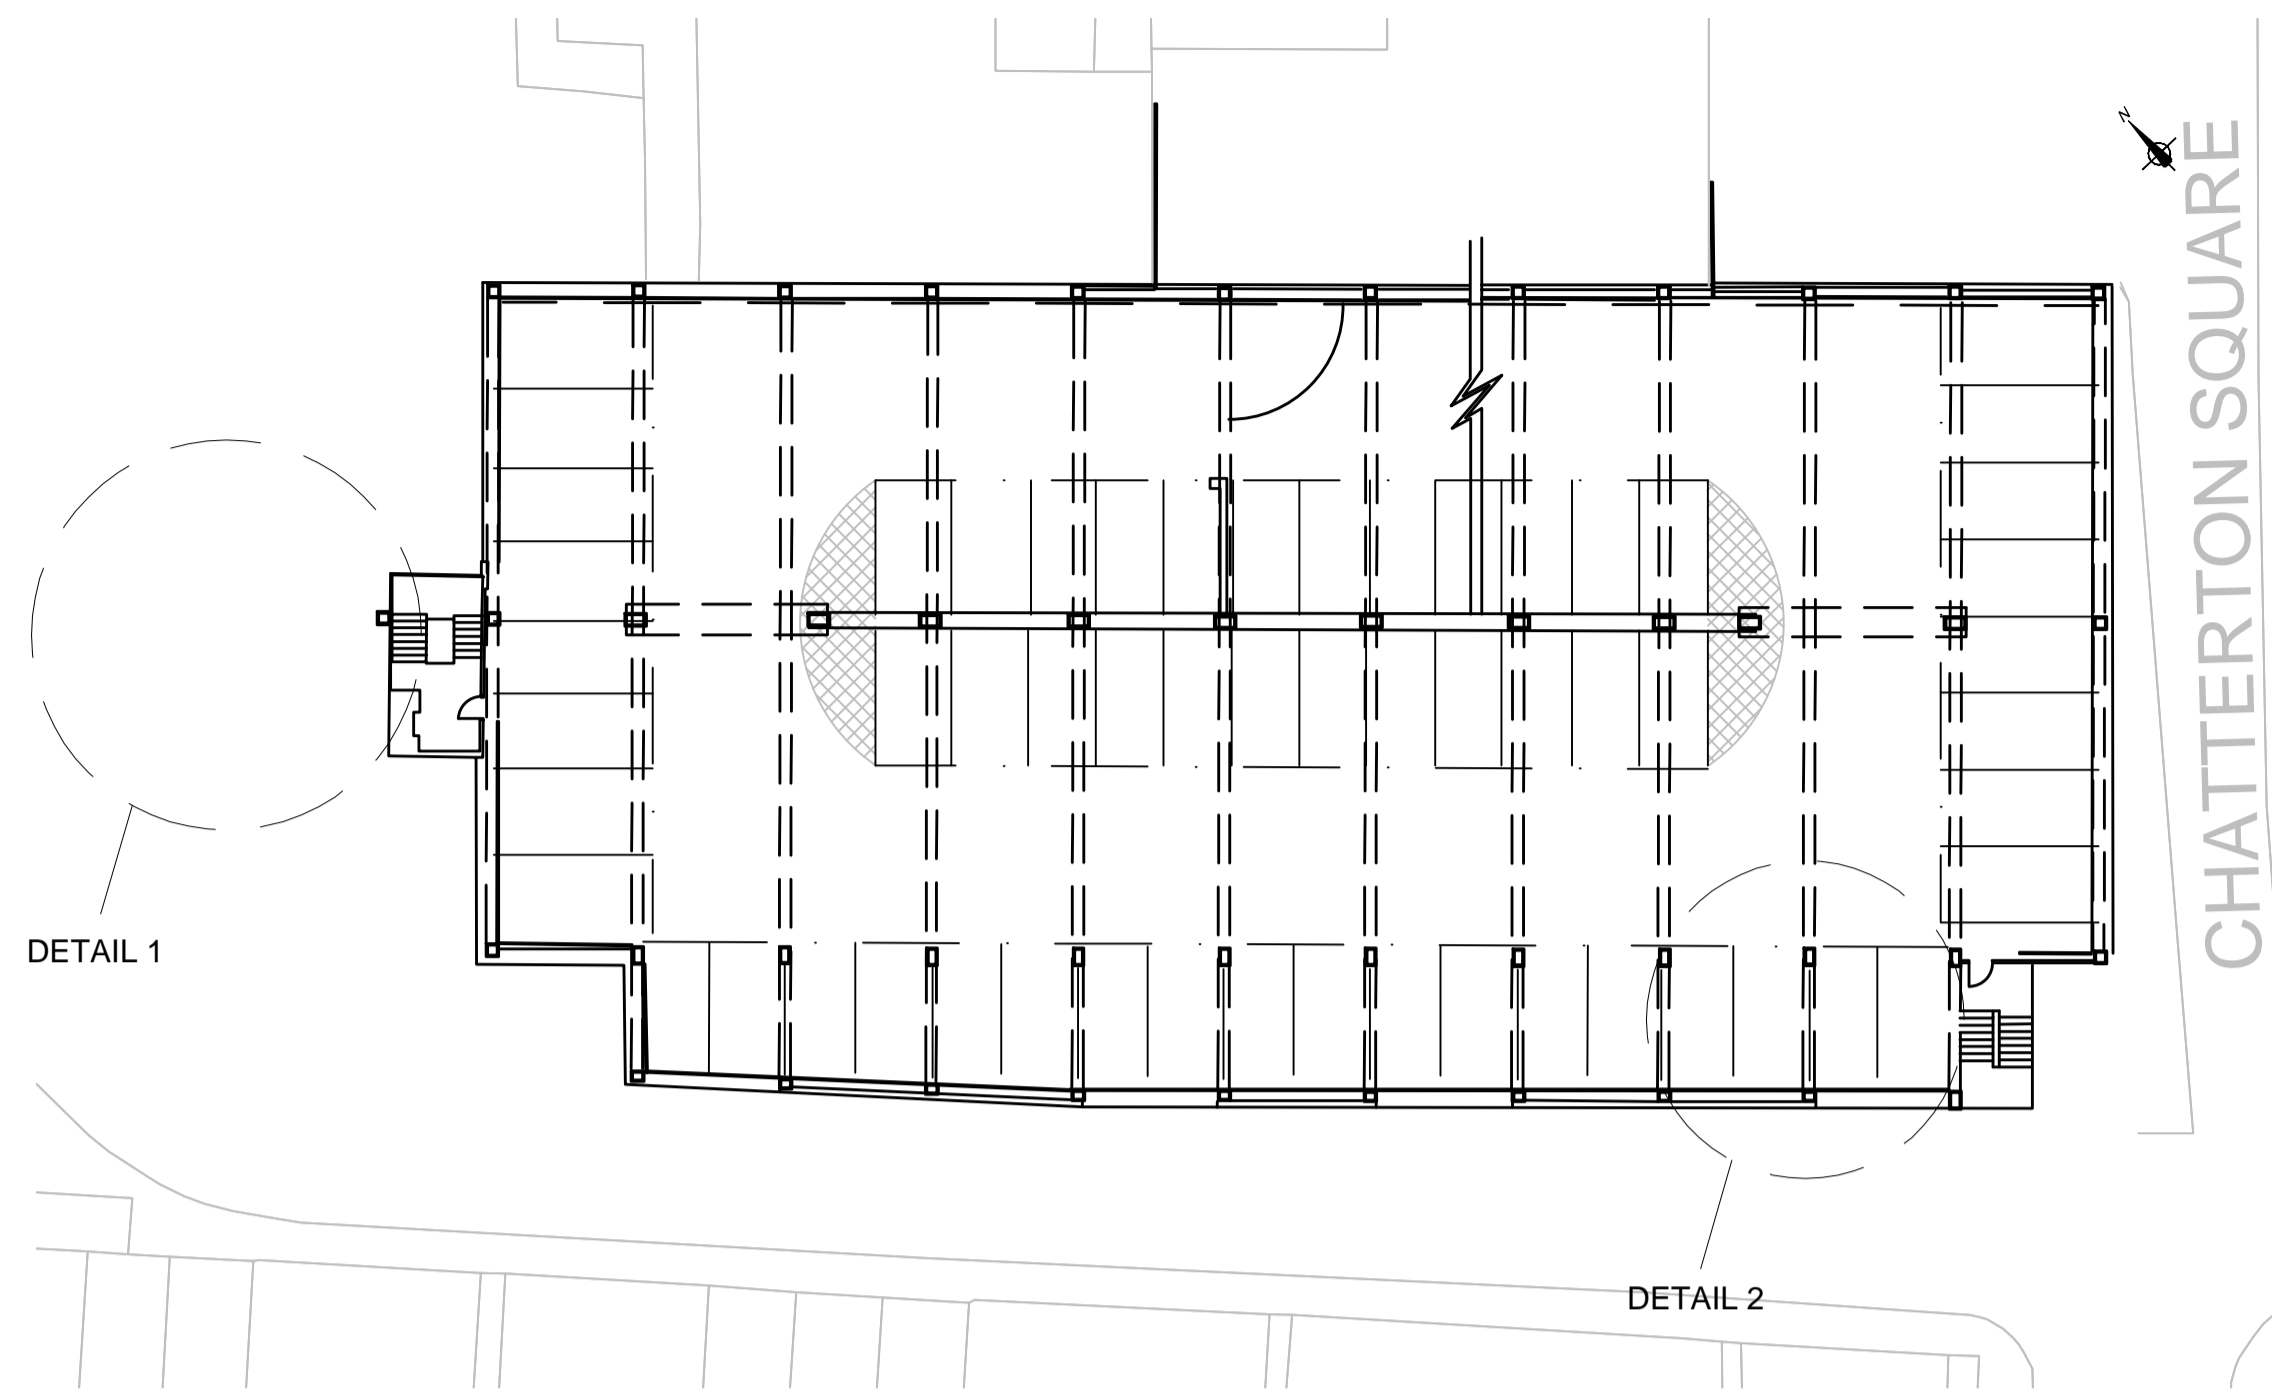

LEVEL 3 FLOOR PLAN
NOT TO SCALE

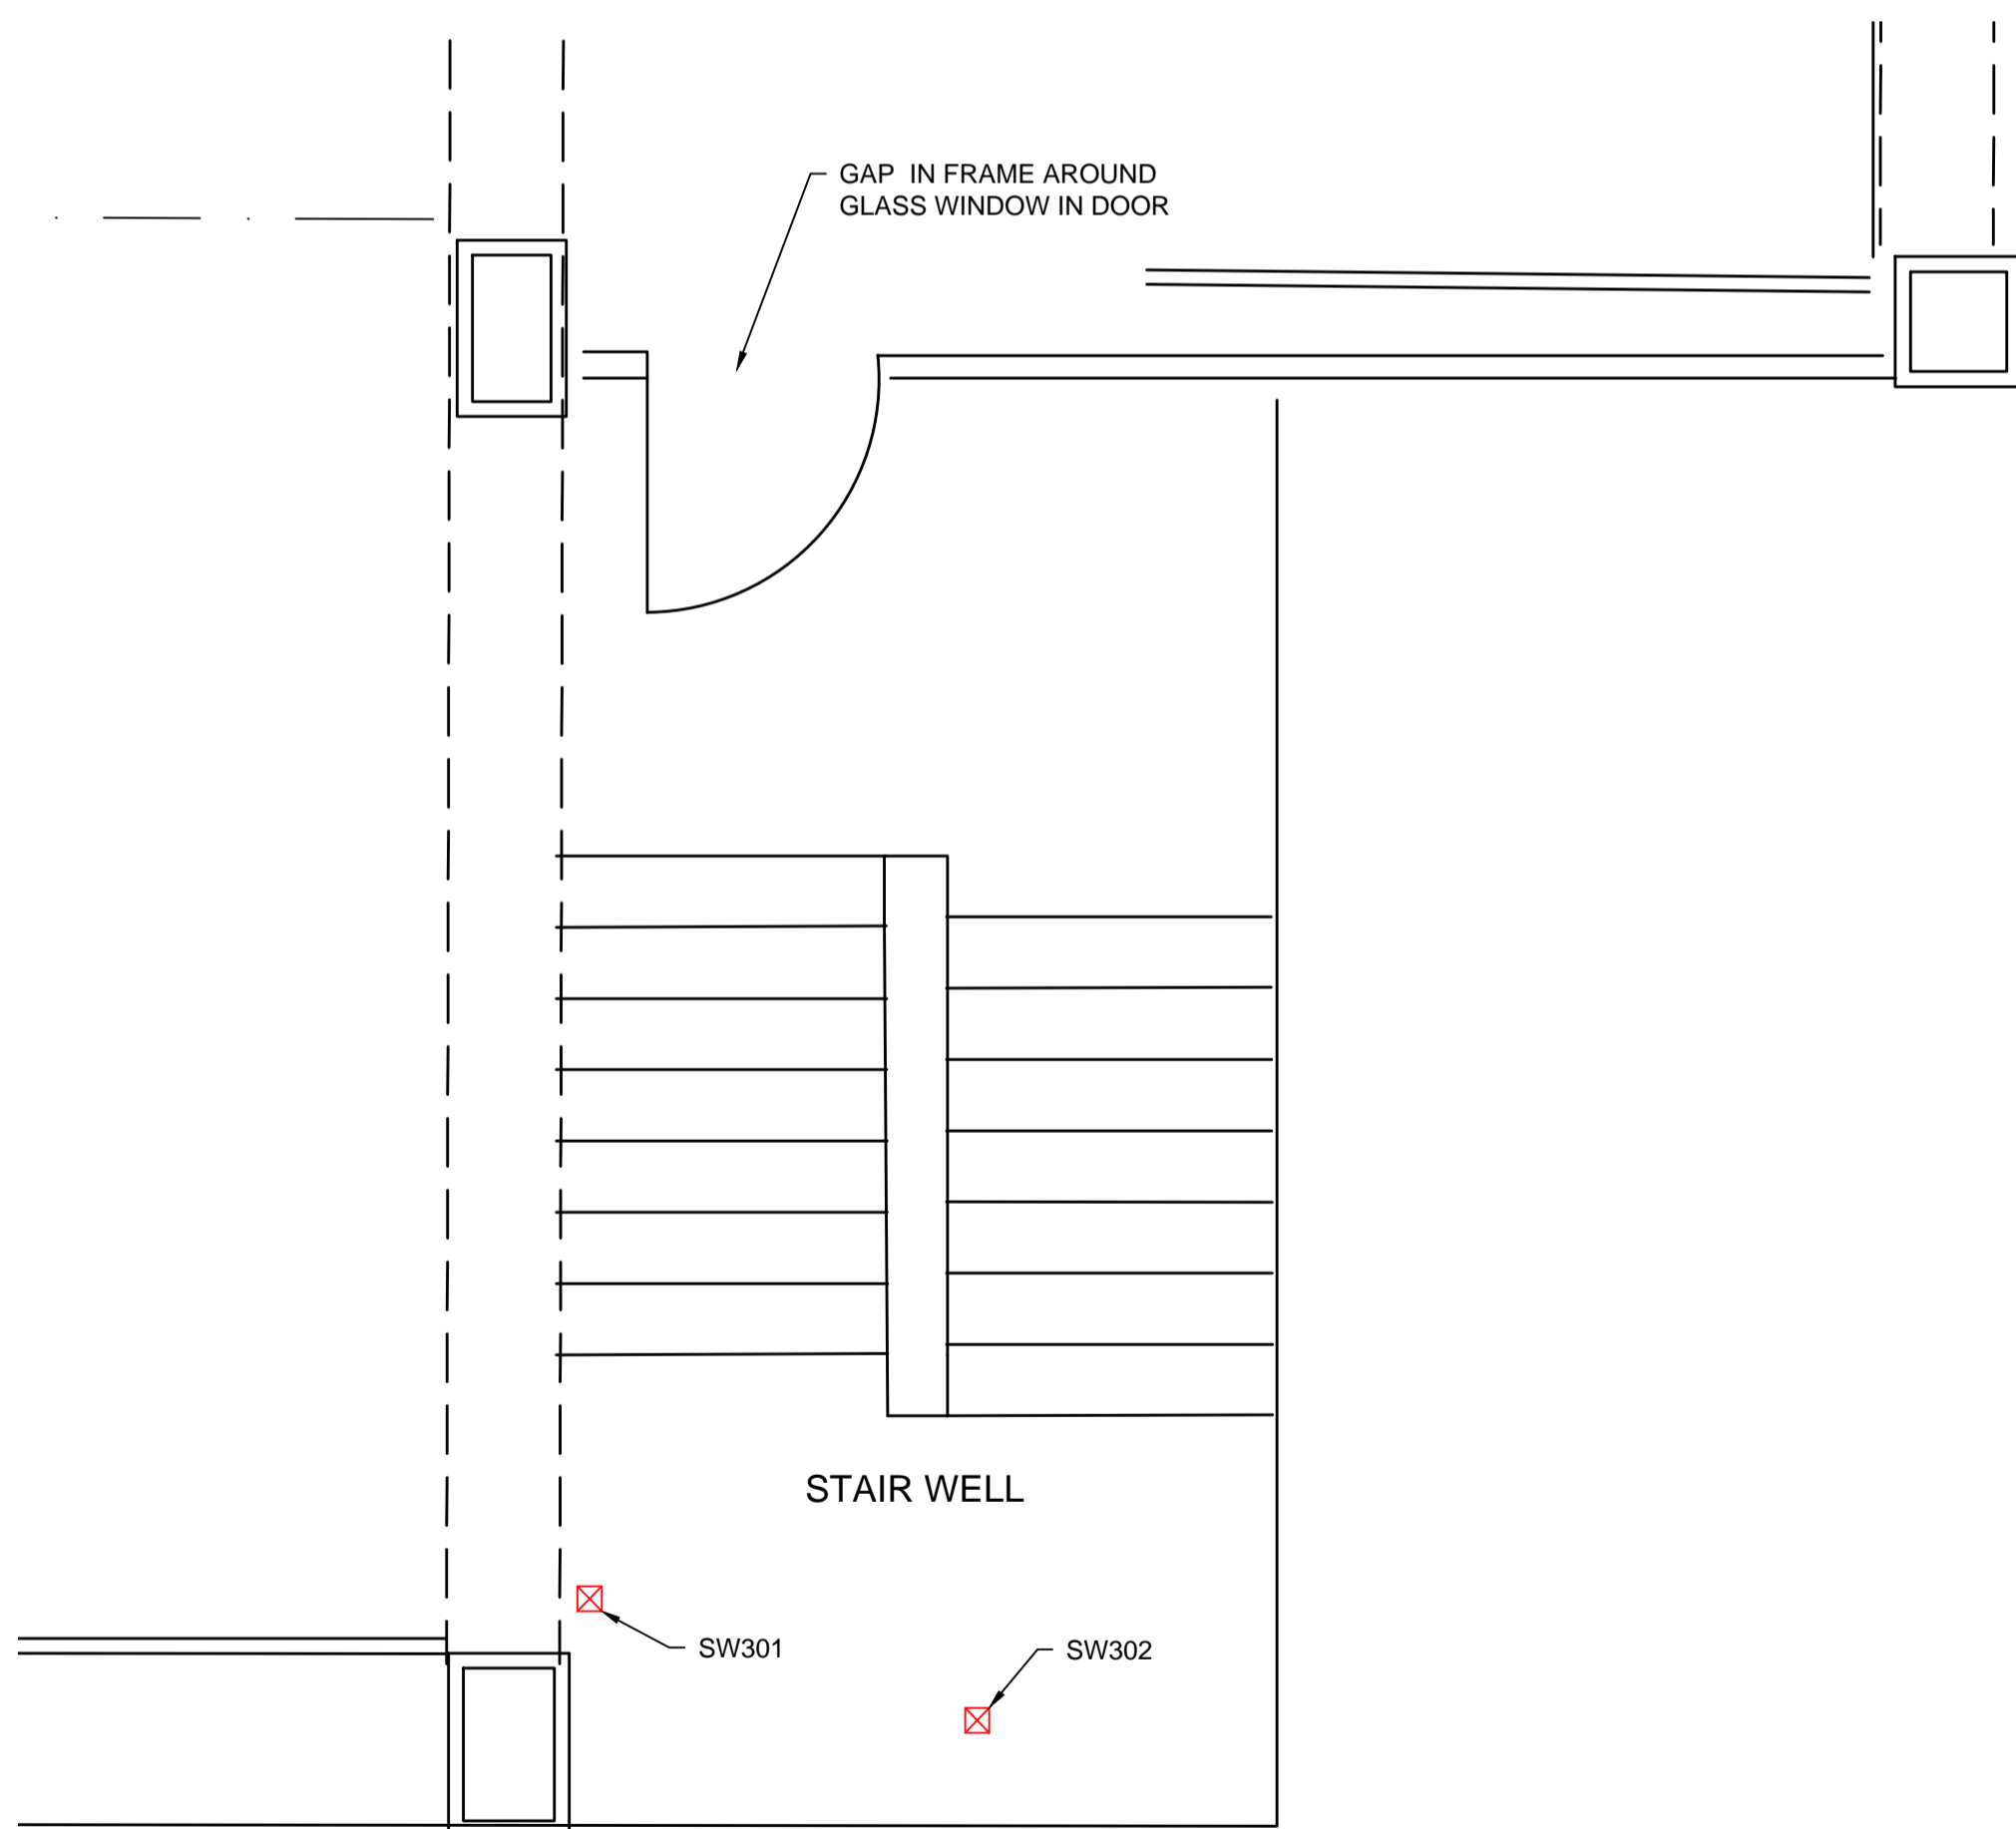

DETAIL 2
NOT TO SCALE

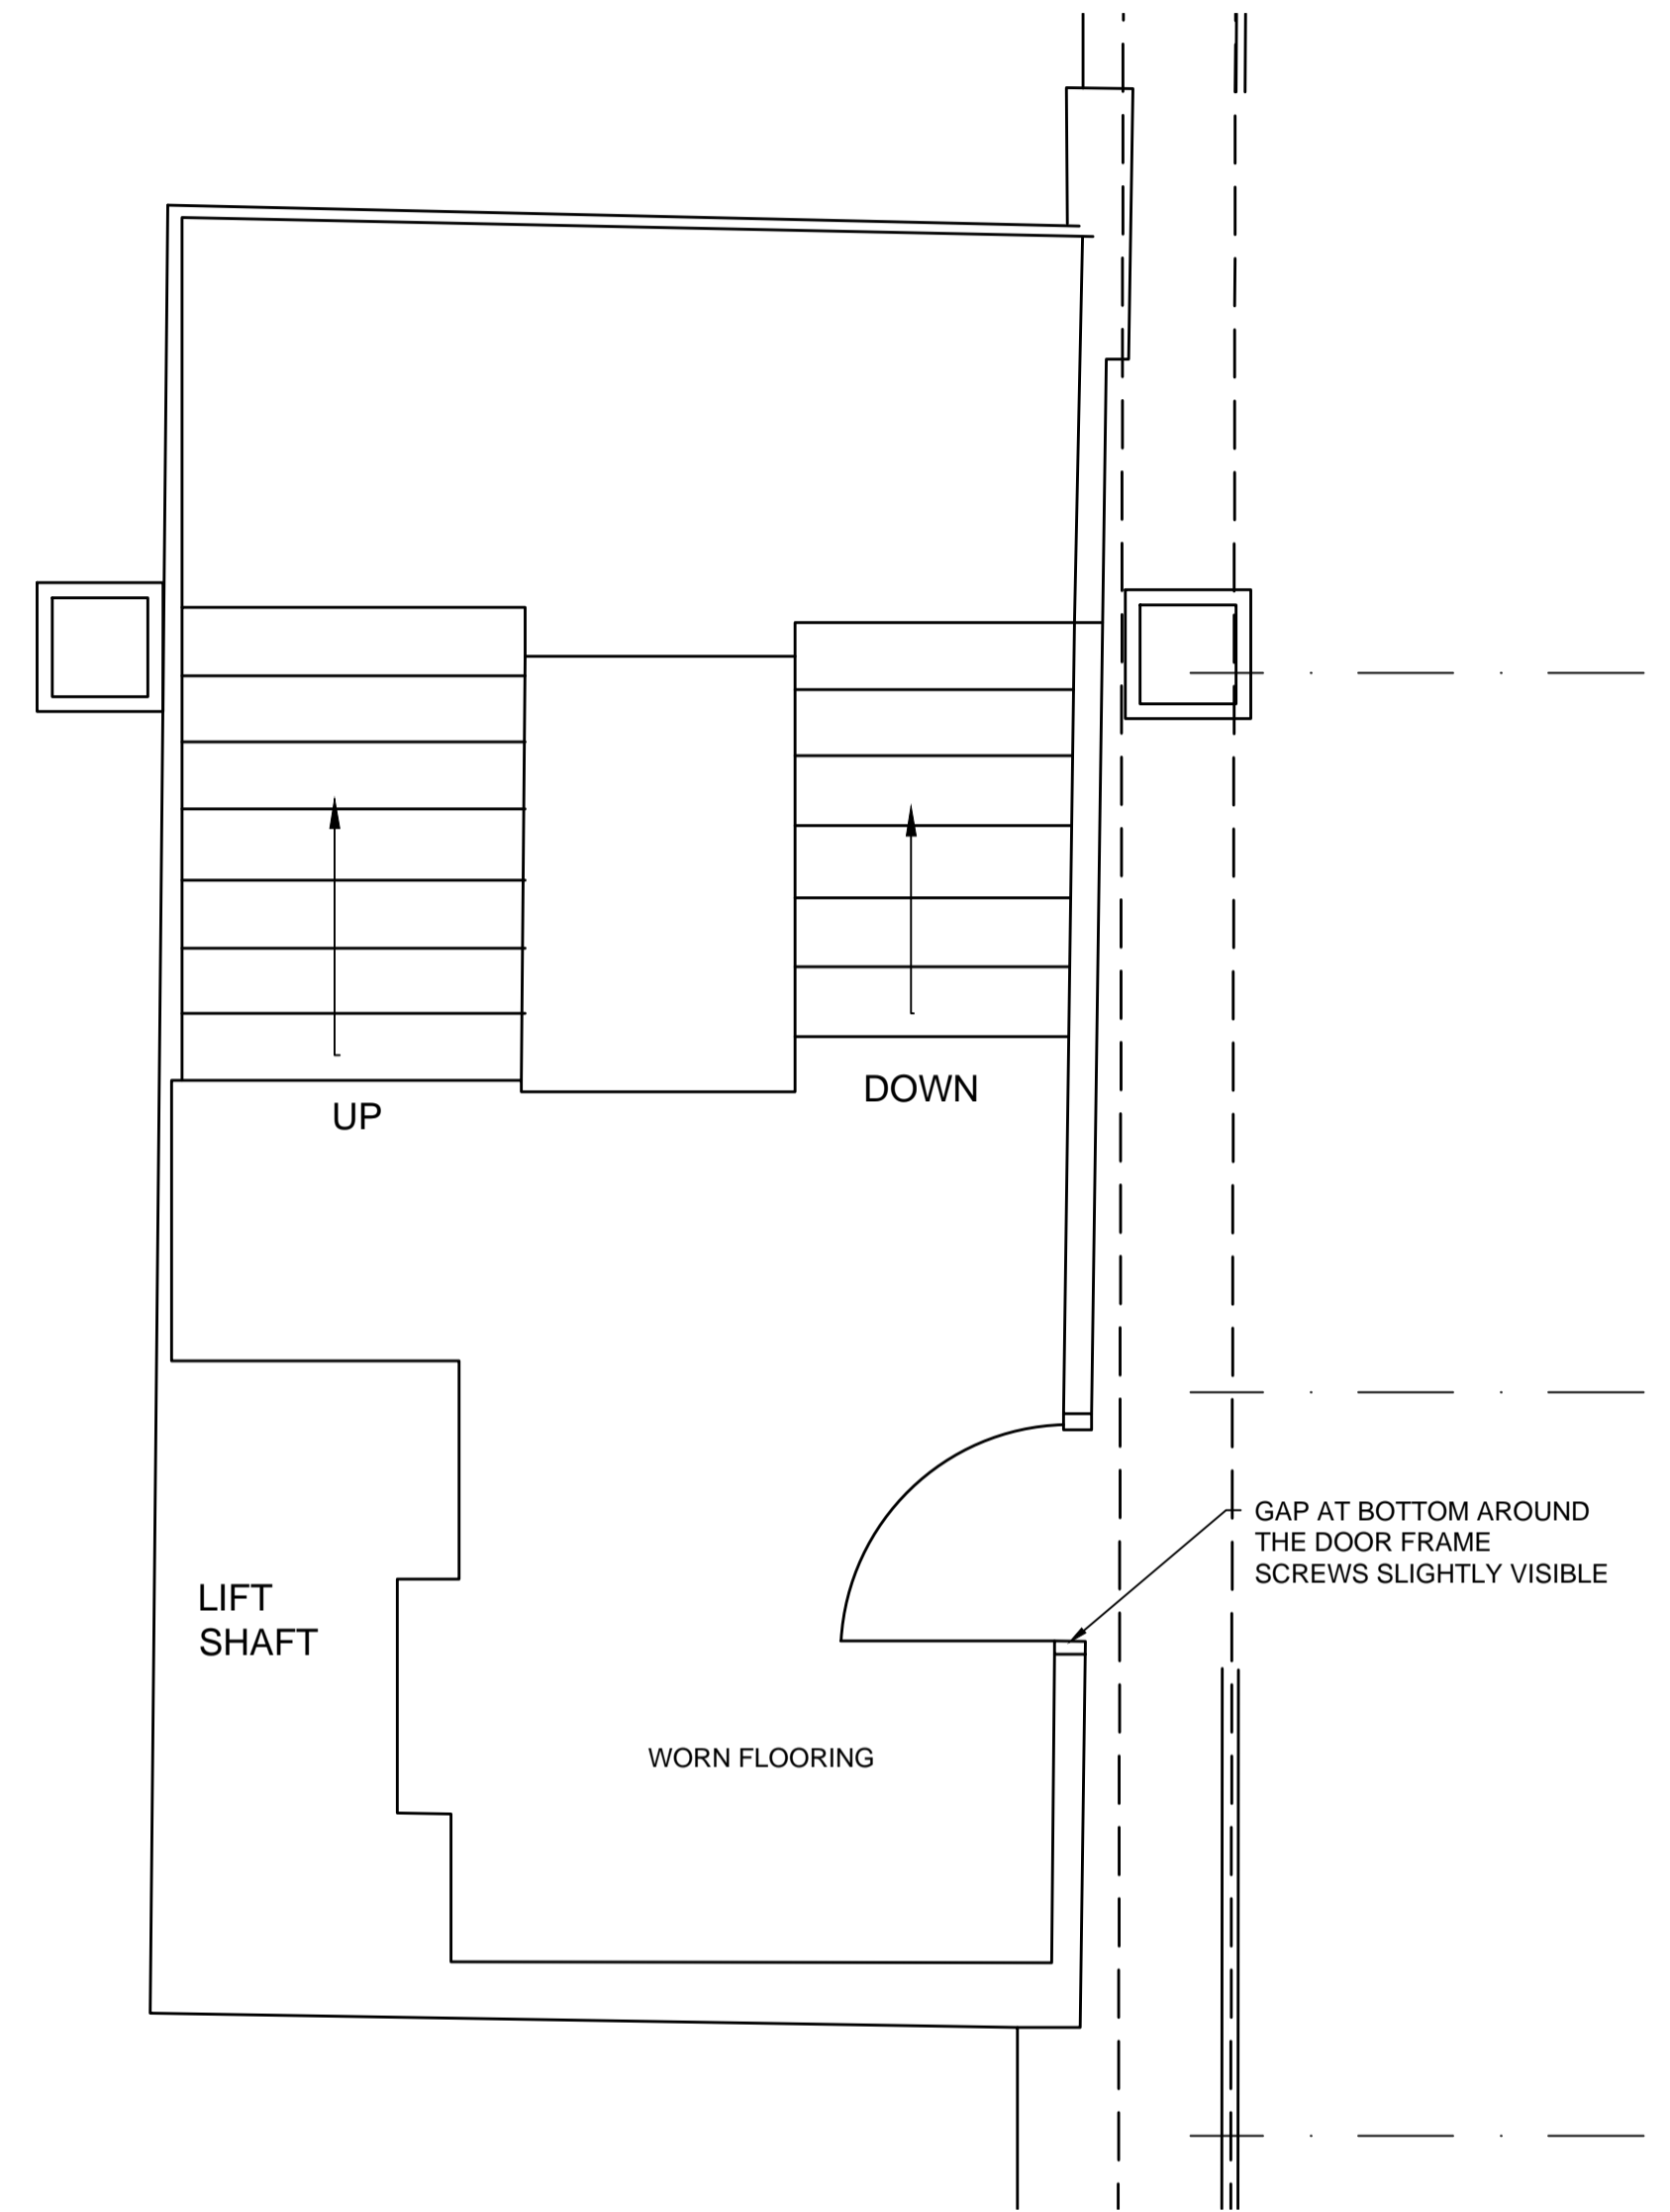

DETAIL 1
NOT TO SCALE

CONCRETE REPAIR SCHEDULE
- STAIR WELLS

REPAIR REFERENCE	LENGTH (mm)	WIDTH (mm)
SW301	300	250
SW302	300	200

KEY

☒ STAIR WELL DEFECT

Rev	By	Chkd	Apprvd	Date	Description
A	FG	AP	RB	13/02/18	FIRST ISSUE

Client



CH2M HILL
1 The Square Temple Quay Bristol BS1 6DG
Tel +44 (0)117 910 2580 Fax +44 (0)117 910 2581



Project

TEMPLE GATE MULTI STOREY
CAR PARK STUDY

Drawing

TEMPLE GATE
LEVEL 3
STAIRCASE DEFECTS

Drawn by: FG Date: 13/02/2018

Checked by: AP Date: 13/02/2018

Approved by: RB Date: 13/02/2018

Drawing No. Revision

673846-TG-107 A

Drawing Scale: NTS


CONCRETE REPAIR SCHEDULE - DECK		
REPAIR REFERENCE	LENGTH (mm)	WIDTH (mm)
D308	500	350
D309	200	100
D310	200	200
D311	250	150
D312	450	100
D313	100	100

CONCRETE REPAIR SCHEDULE - SOFFIT		
REPAIR REFERENCE	LENGTH (mm)	WIDTH (mm)
S301	200	200
S302	200	200
S303	200	100
S304	200	200
S305	200	200
S306	200	100
S307	400	100
S308	400	100
S309	200	200
S310	200	100???
S311	150	100
S312	300	300
S313	500	700
S314	500	300
S315	1000	400
S316	400	200
S317	300	200
S318	300	200
S319	200	200
S320	100	100
S321	200	200
S322	100	100
S323	300	300
S401	300	200
S402	400	200

CONCRETE REPAIR SCHEDULE - UPSTAND		
REPAIR REFERENCE	LENGTH (mm)	WIDTH (mm)
U301	200	100
U302	100	100
U303	200	200
U304	300	100
U305	100	100
U306	200	200

KEY

- ☒ DECK DEFECT
- ☒ SOFFIT DEFECT
- ☒ UPSTAND DEFECT

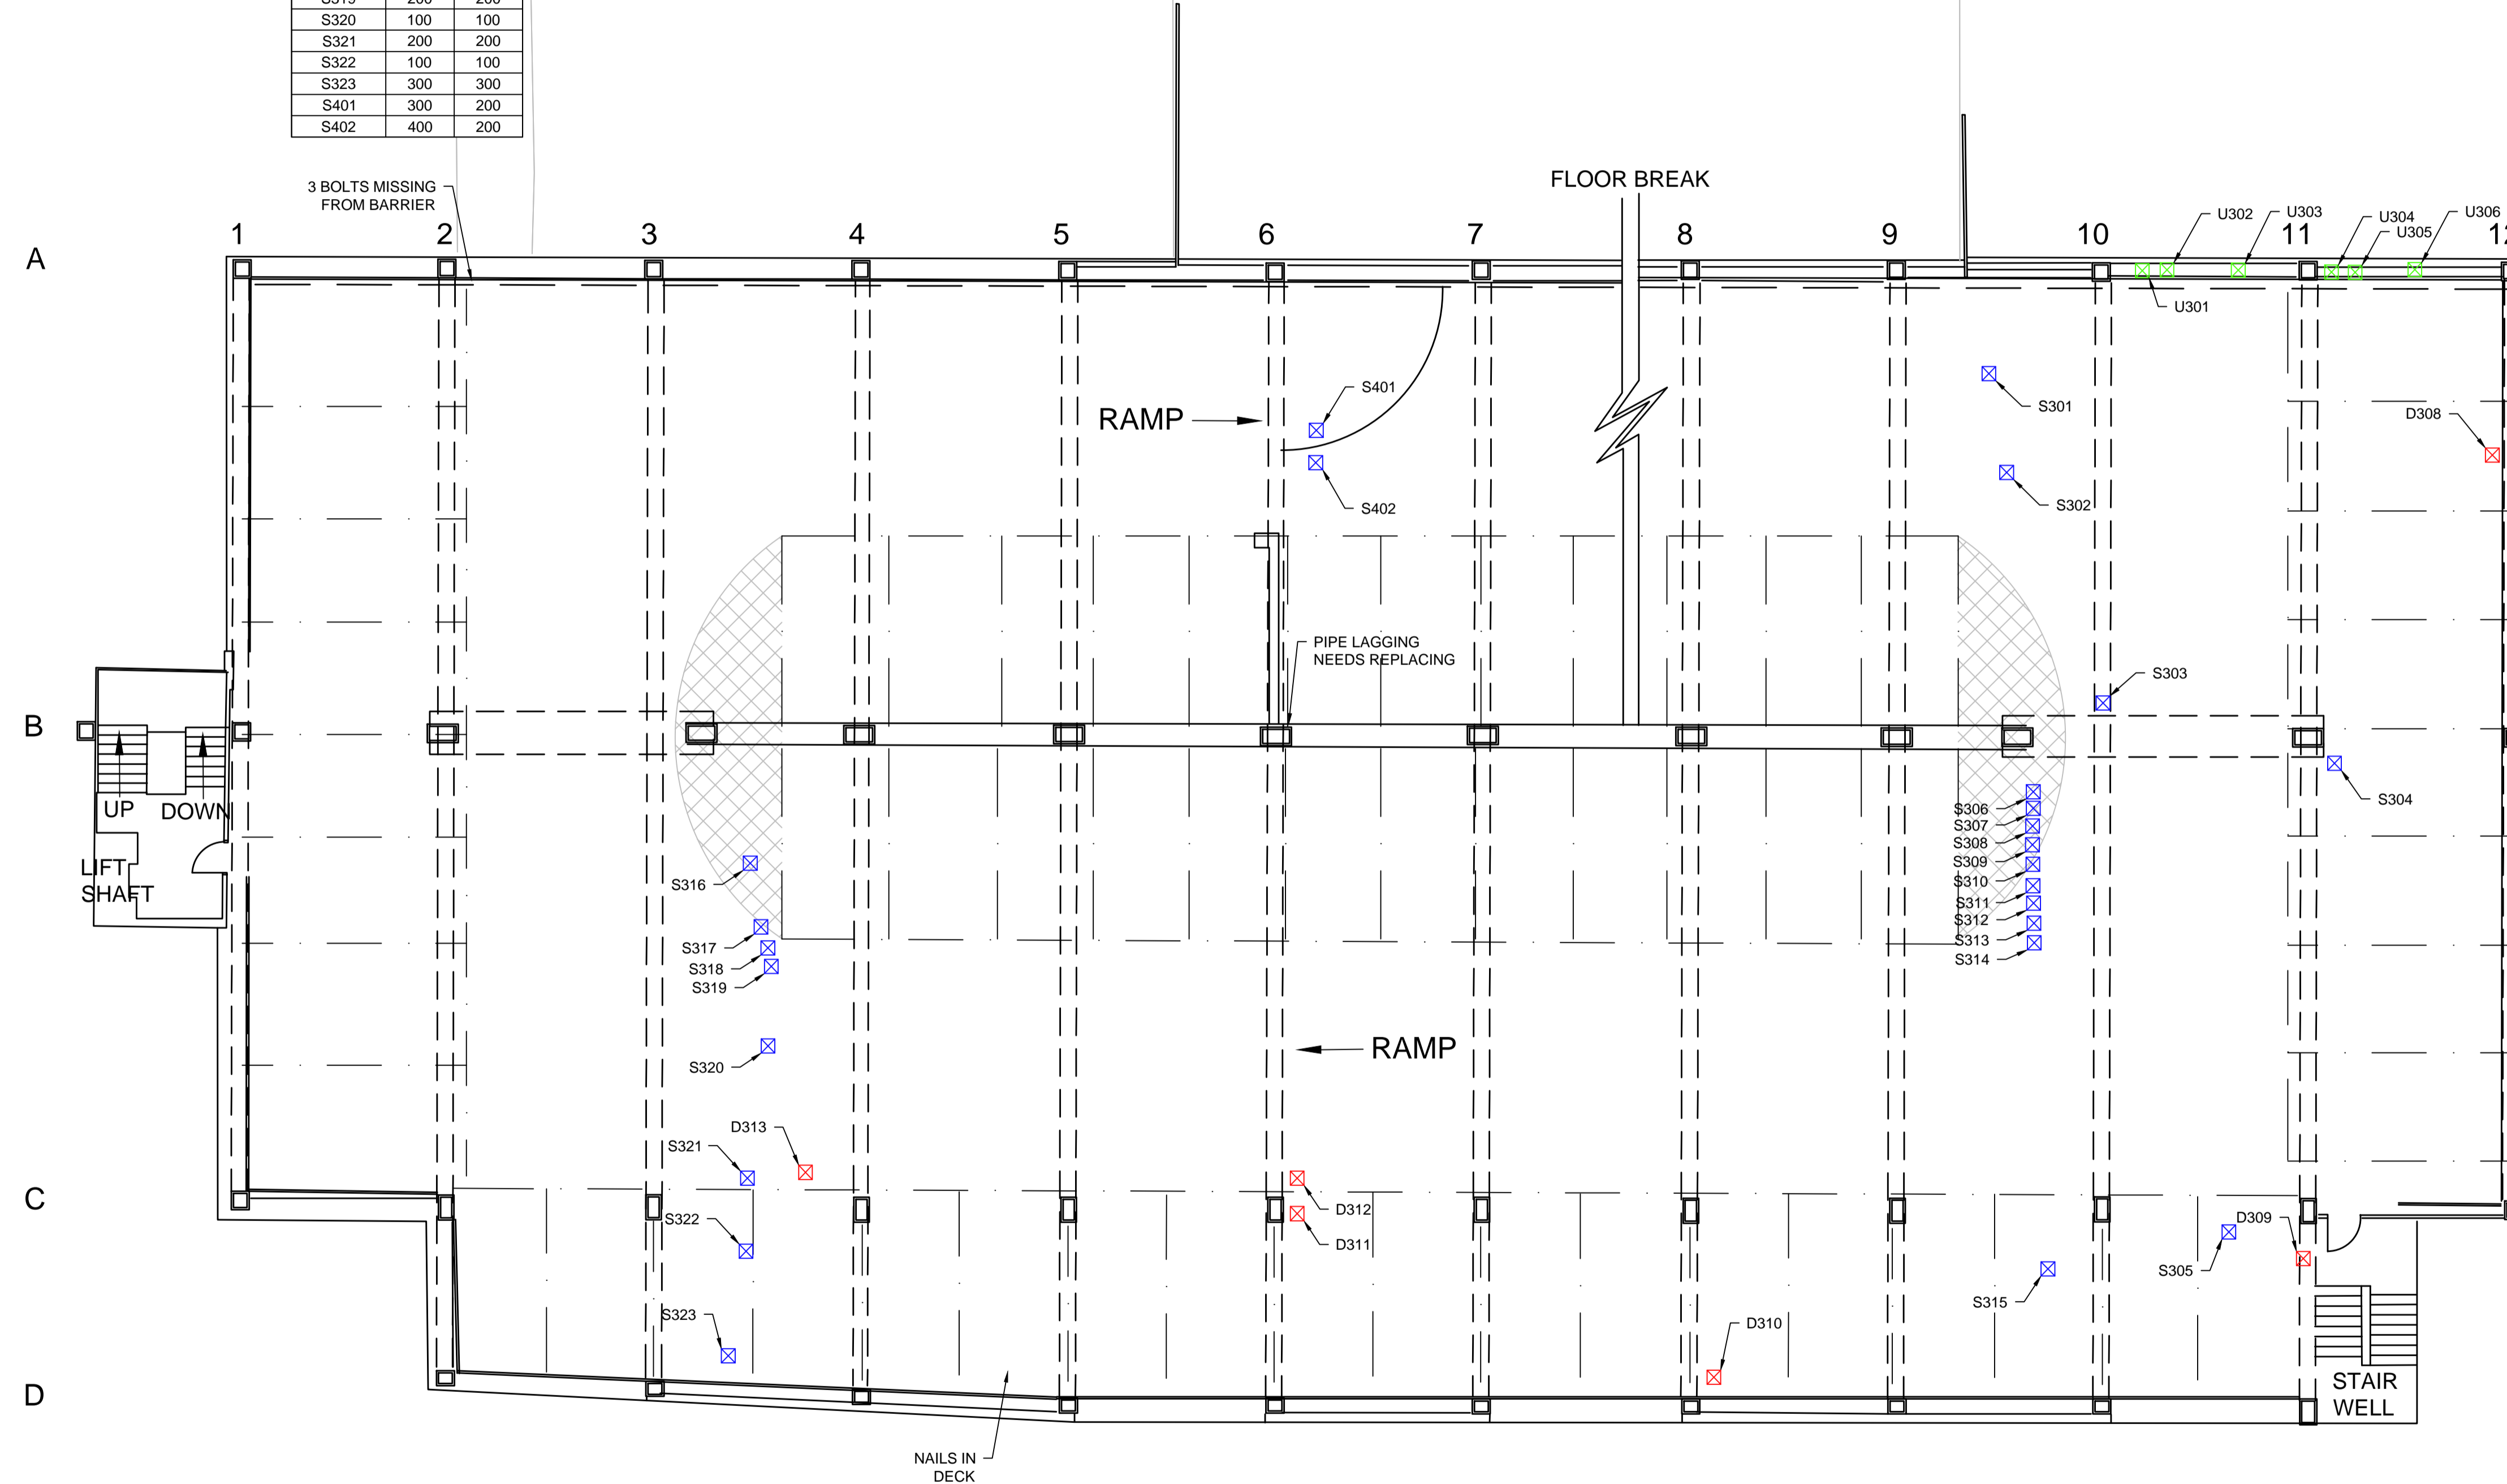

CHATTERTON SQUARE

LEVEL 3 FLOOR PLAN
NOT TO SCALE

This map is reproduced from Ordnance Survey® material by Halcrow on behalf of Bristol City Council with the permission of the Controller of Her Majesty's Stationery Office. Crown copyright. Unauthorised reproduction infringes Crown copyright and may lead to prosecution or civil proceedings. Licence Number: 100023406

Rev	By	Chkd	Apprvd	Date	Description
A	FG	AP	RB	13/02/2018	FIRST ISSUE



CH2M HILL
1 The Square Temple Quay Bristol BS1 6DG
Tel +44 (0)117 910 2580 Fax +44 (0)117 910 2581



Project: **TEMPLE GATE MULTI STOREY CAR PARK STUDY**

Drawing: **TEMPLE GATE LEVEL 3 DEFECTS**


Drawn by: FG	Date: 13/02/2018
Checked by: AP	Date: 13/02/2018
Approved by: RB	Date: 13/02/2018

Drawing No.	Revision
673846-TG-108	A


Drawing Scale: NTS

KEY


☒ STAIR WELL DEFECT

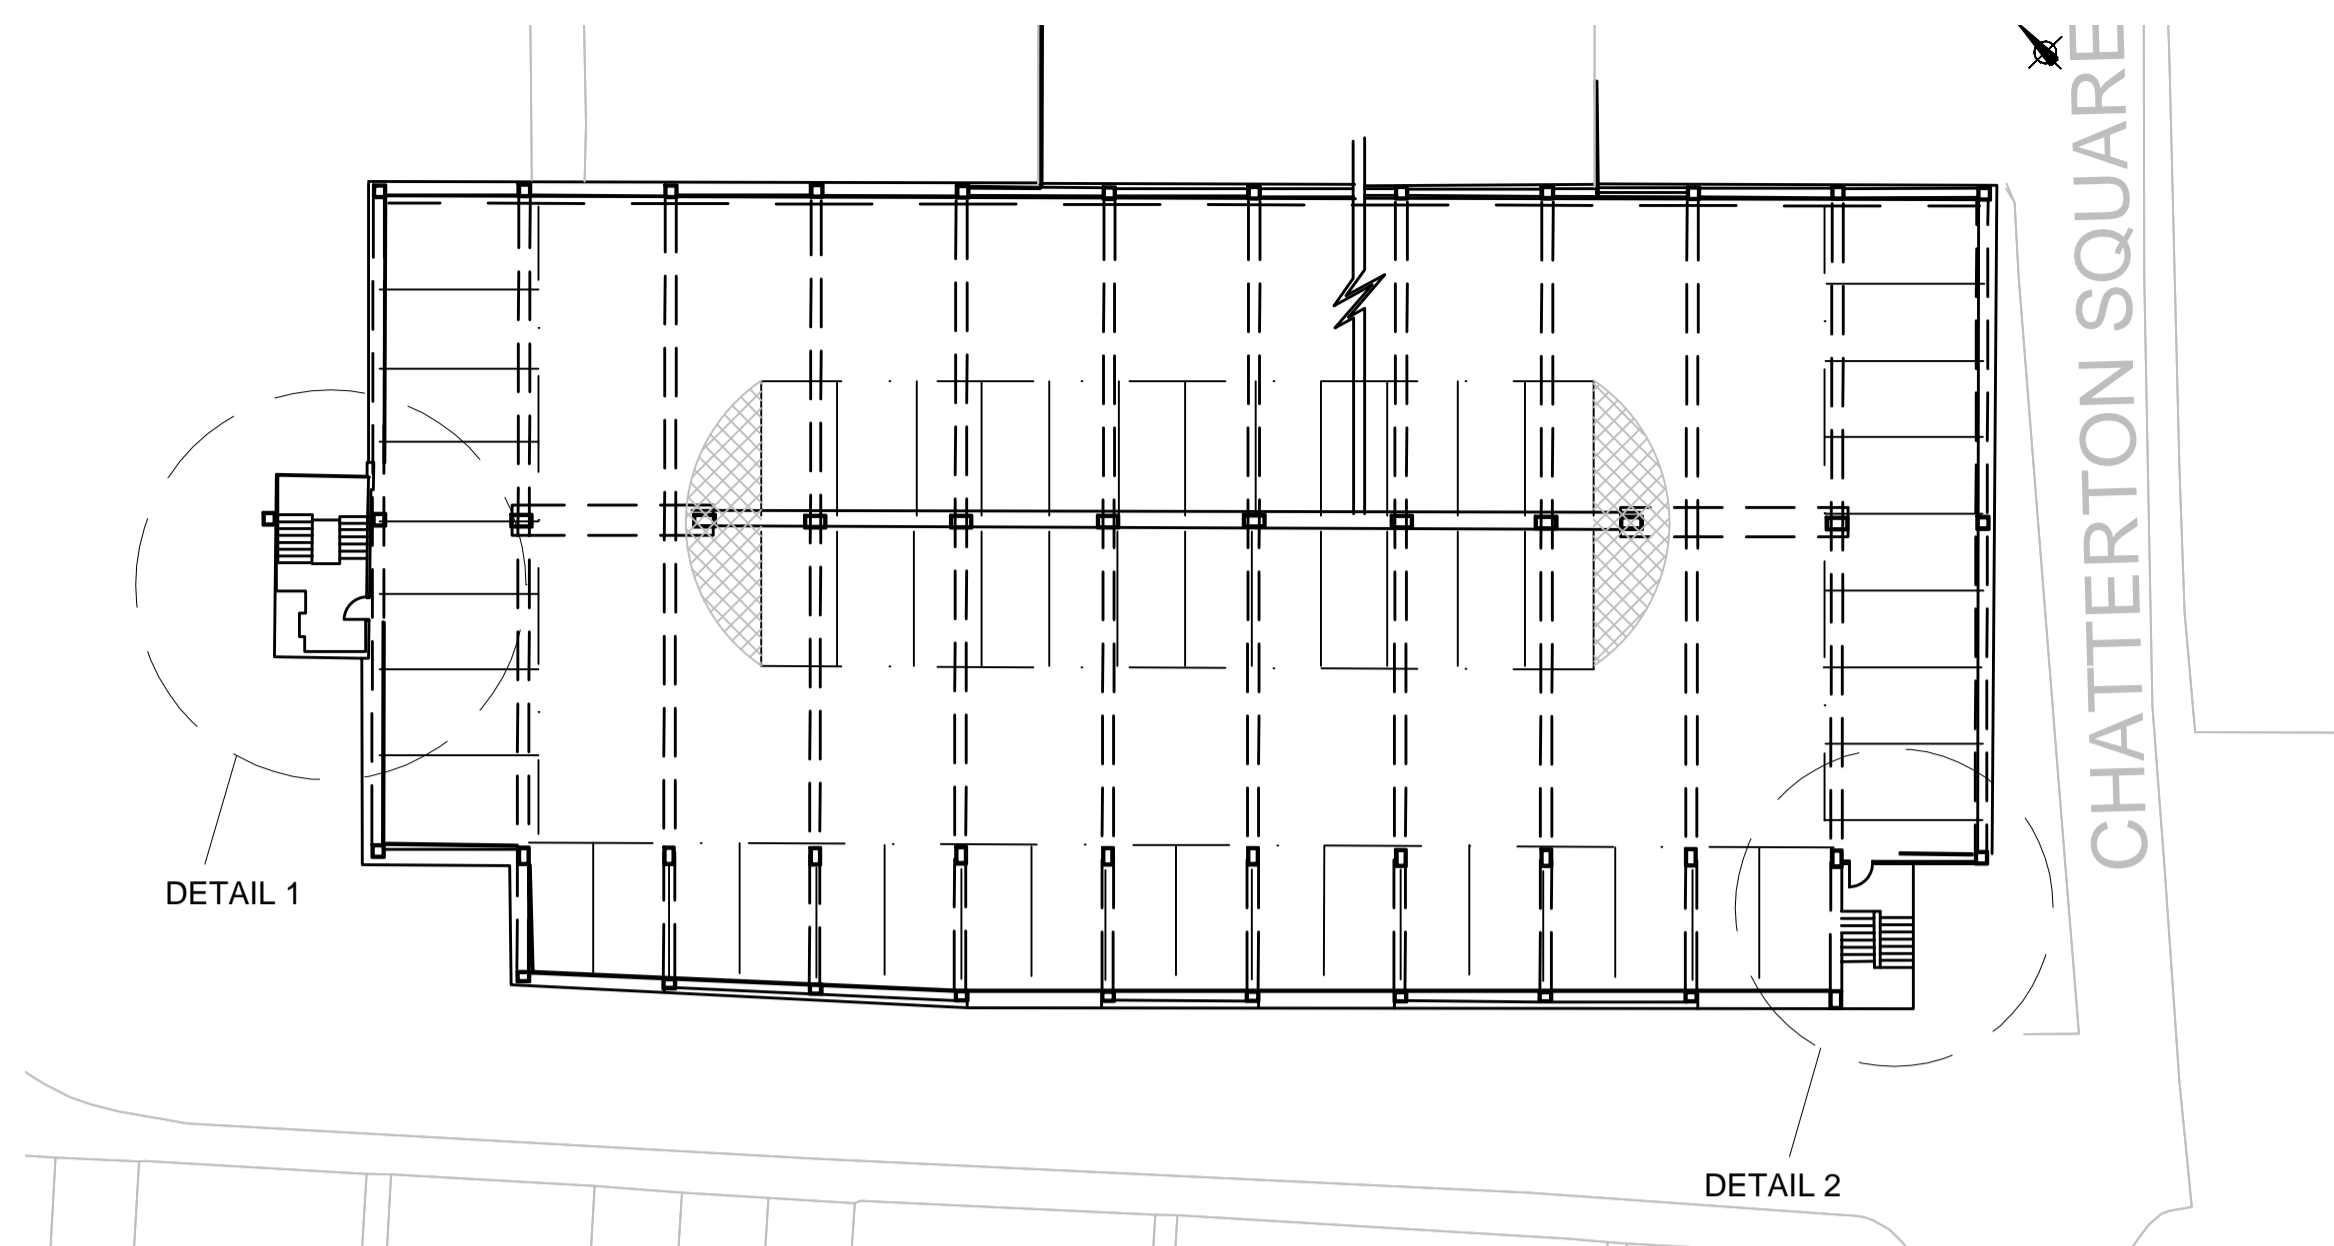

LEVEL 4 FLOOR PLAN
NOT TO SCALE

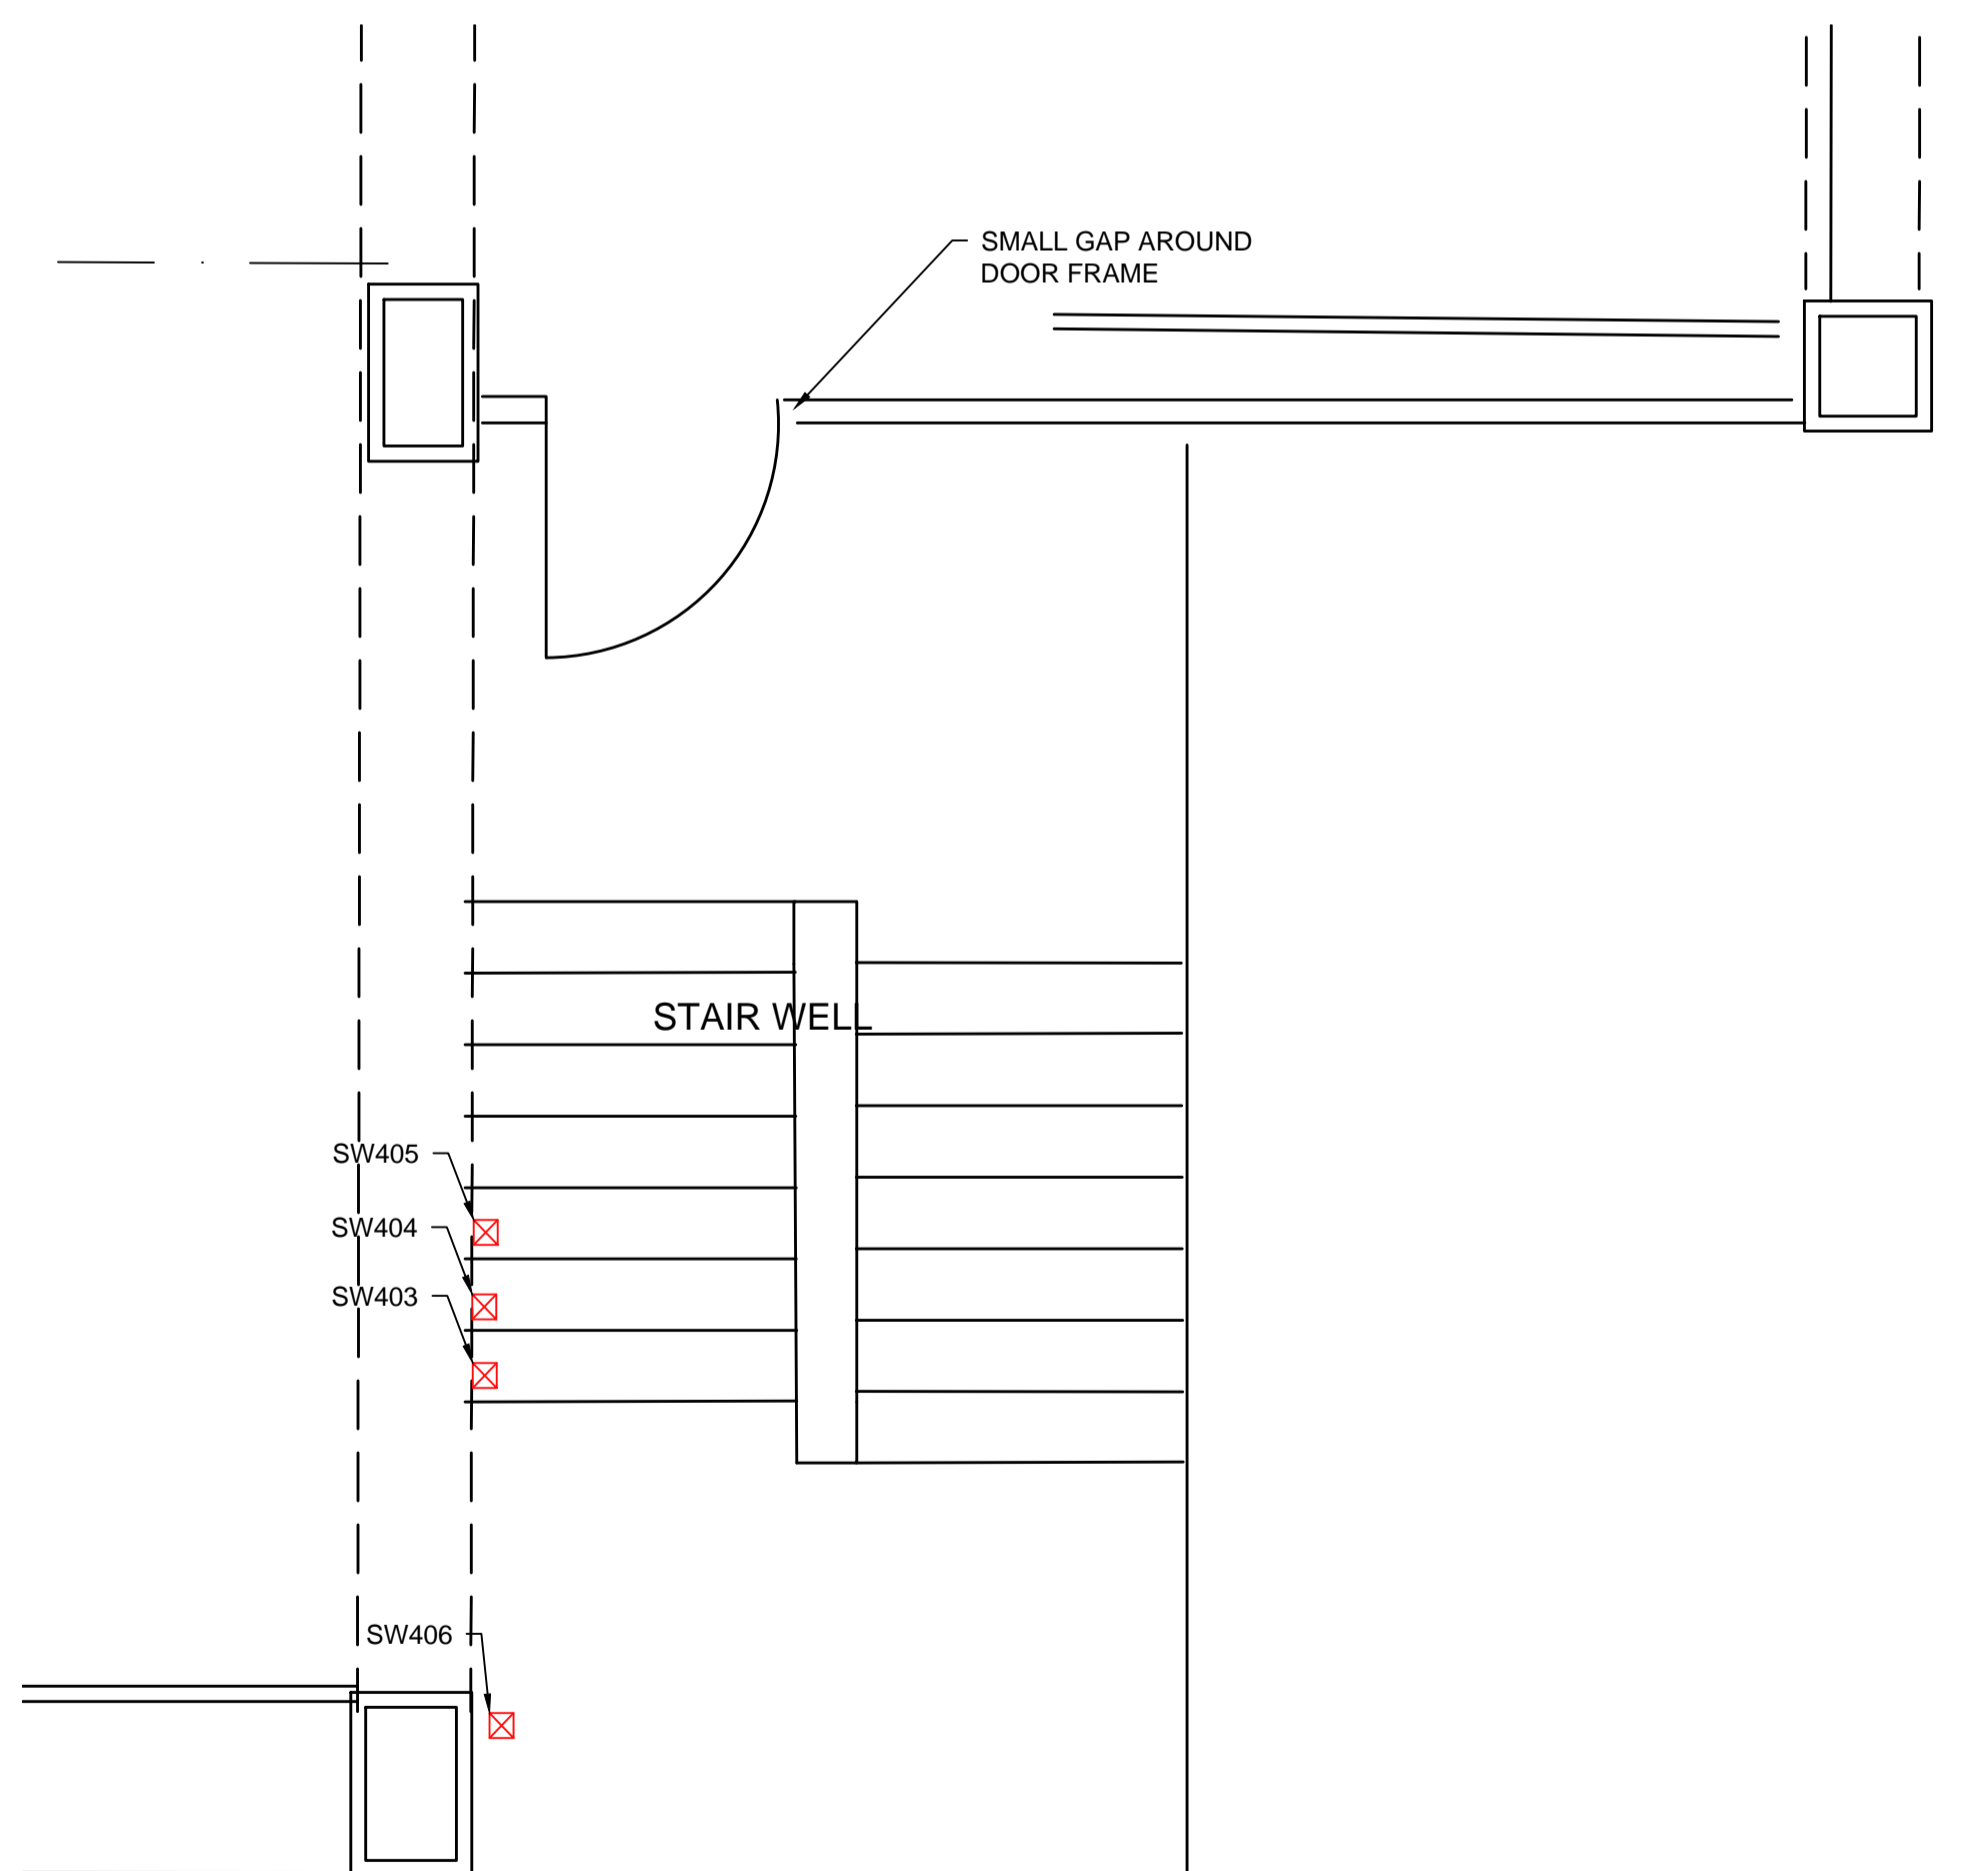

DETAIL 2
NOT TO SCALE

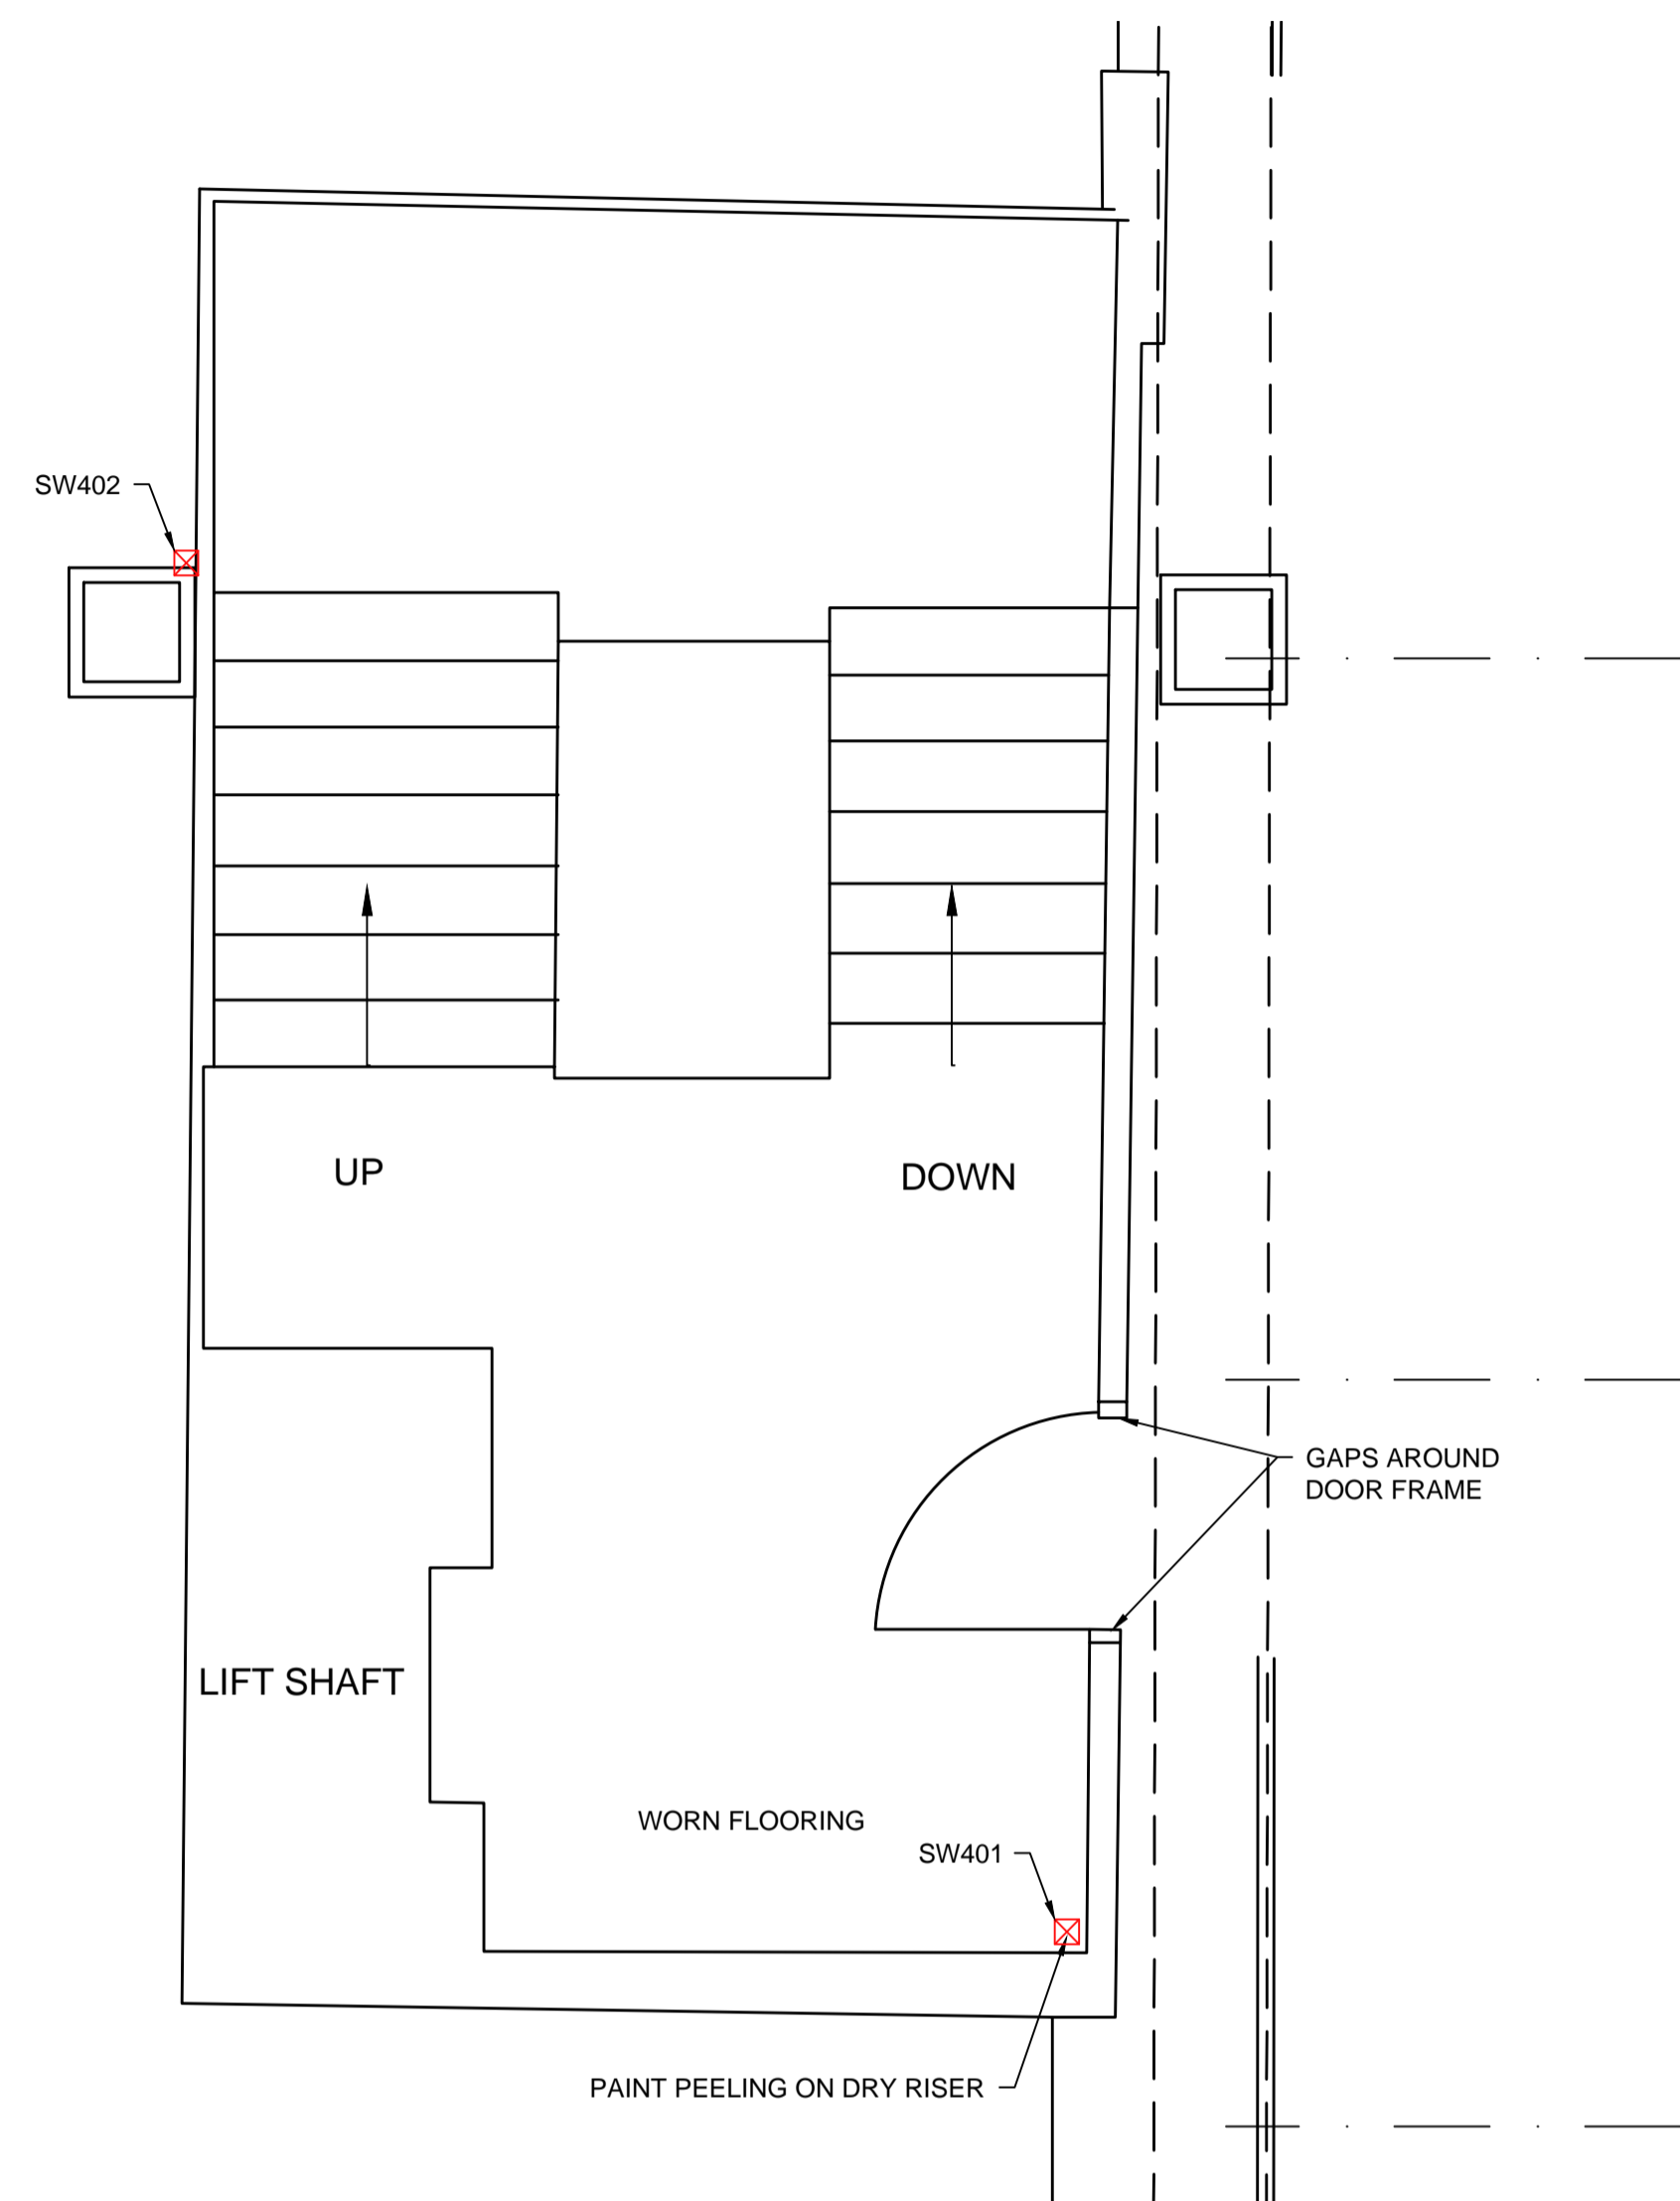

DETAIL 1
NOT TO SCALE

CONCRETE REPAIR SCHEDULE - STAIR WELLS			
REPAIR REFERENCE	HEIGHT (mm)	LENGTH (mm)	WIDTH (mm)
SW301	-	500	300
SW302	500	150	100
SW303	250	150	50
SW304	250	150	50
SW305	250	150	50
SW306	-	150	150

Rev	By	Chkd	Apprvd	Date	Description
A	FG	AP	RB	13/02/2018	FIRST ISSUE

Client



CH2M HILL
1 The Square Temple Quay Bristol BS1 6DG
Tel +44 (0)117 910 2580 Fax +44 (0)117 910 2581



Project

**TEMPLE GATE MULTI STOREY
CAR PARK STUDY**

Drawing

**TEMPLE GATE
LEVEL 4
STAIRCASE DEFECTS**

Drawn by: FG Date: 13/02/2018

Checked by: AP Date: 13/02/2018

Approved by: RB Date: 13/02/2018

Drawing No. Revision

673846-TG-109

A

Drawing Scale: NTS

CONCRETE REPAIR SCHEDULE - DECK		
REPAIR REFERENCE	LENGTH (mm)	WIDTH (mm)
D401	200	200
D402	200	100


CONCRETE REPAIR SCHEDULE - SOFFIT		
REPAIR REFERENCE	LENGTH (mm)	WIDTH (mm)
S403	100	100
S404	400	200
S405	300	200
S406	300	300
S407	500	200
S408	200	200
S409	200	200
S410	100	100
S411	100	150
S412	200	200
S413	100	100
S414	100	100
S415	100	100
S416	100	100
S417	300	100
S418	100	100
S419	100	150
S420	600	300
S421	100	300
S422	100	300
S423	200	200
S424	200	200
S425	100	200
S426	300	200
S427	300	2000
S428	150	150
S429	200	200
S430	400	200

CONCRETE REPAIR SCHEDULE - UPSTAND		
REPAIR REFERENCE	LENGTH (mm)	WIDTH (mm)
U401	100	100
U402	100	100
U403	100	100
U404	150	100
U405	100	50

CONCRETE REPAIR SCHEDULE - COLUMN		
REPAIR REFERENCE	LENGTH (mm)	WIDTH (mm)
C401	250	250
C402	200	100
C403	100	100

KEY

- ✘ DECK DEFECT
- ✘ SOFFIT DEFECT
- ✘ UPSTAND DEFECT
- ✘ COLUMN DEFECT

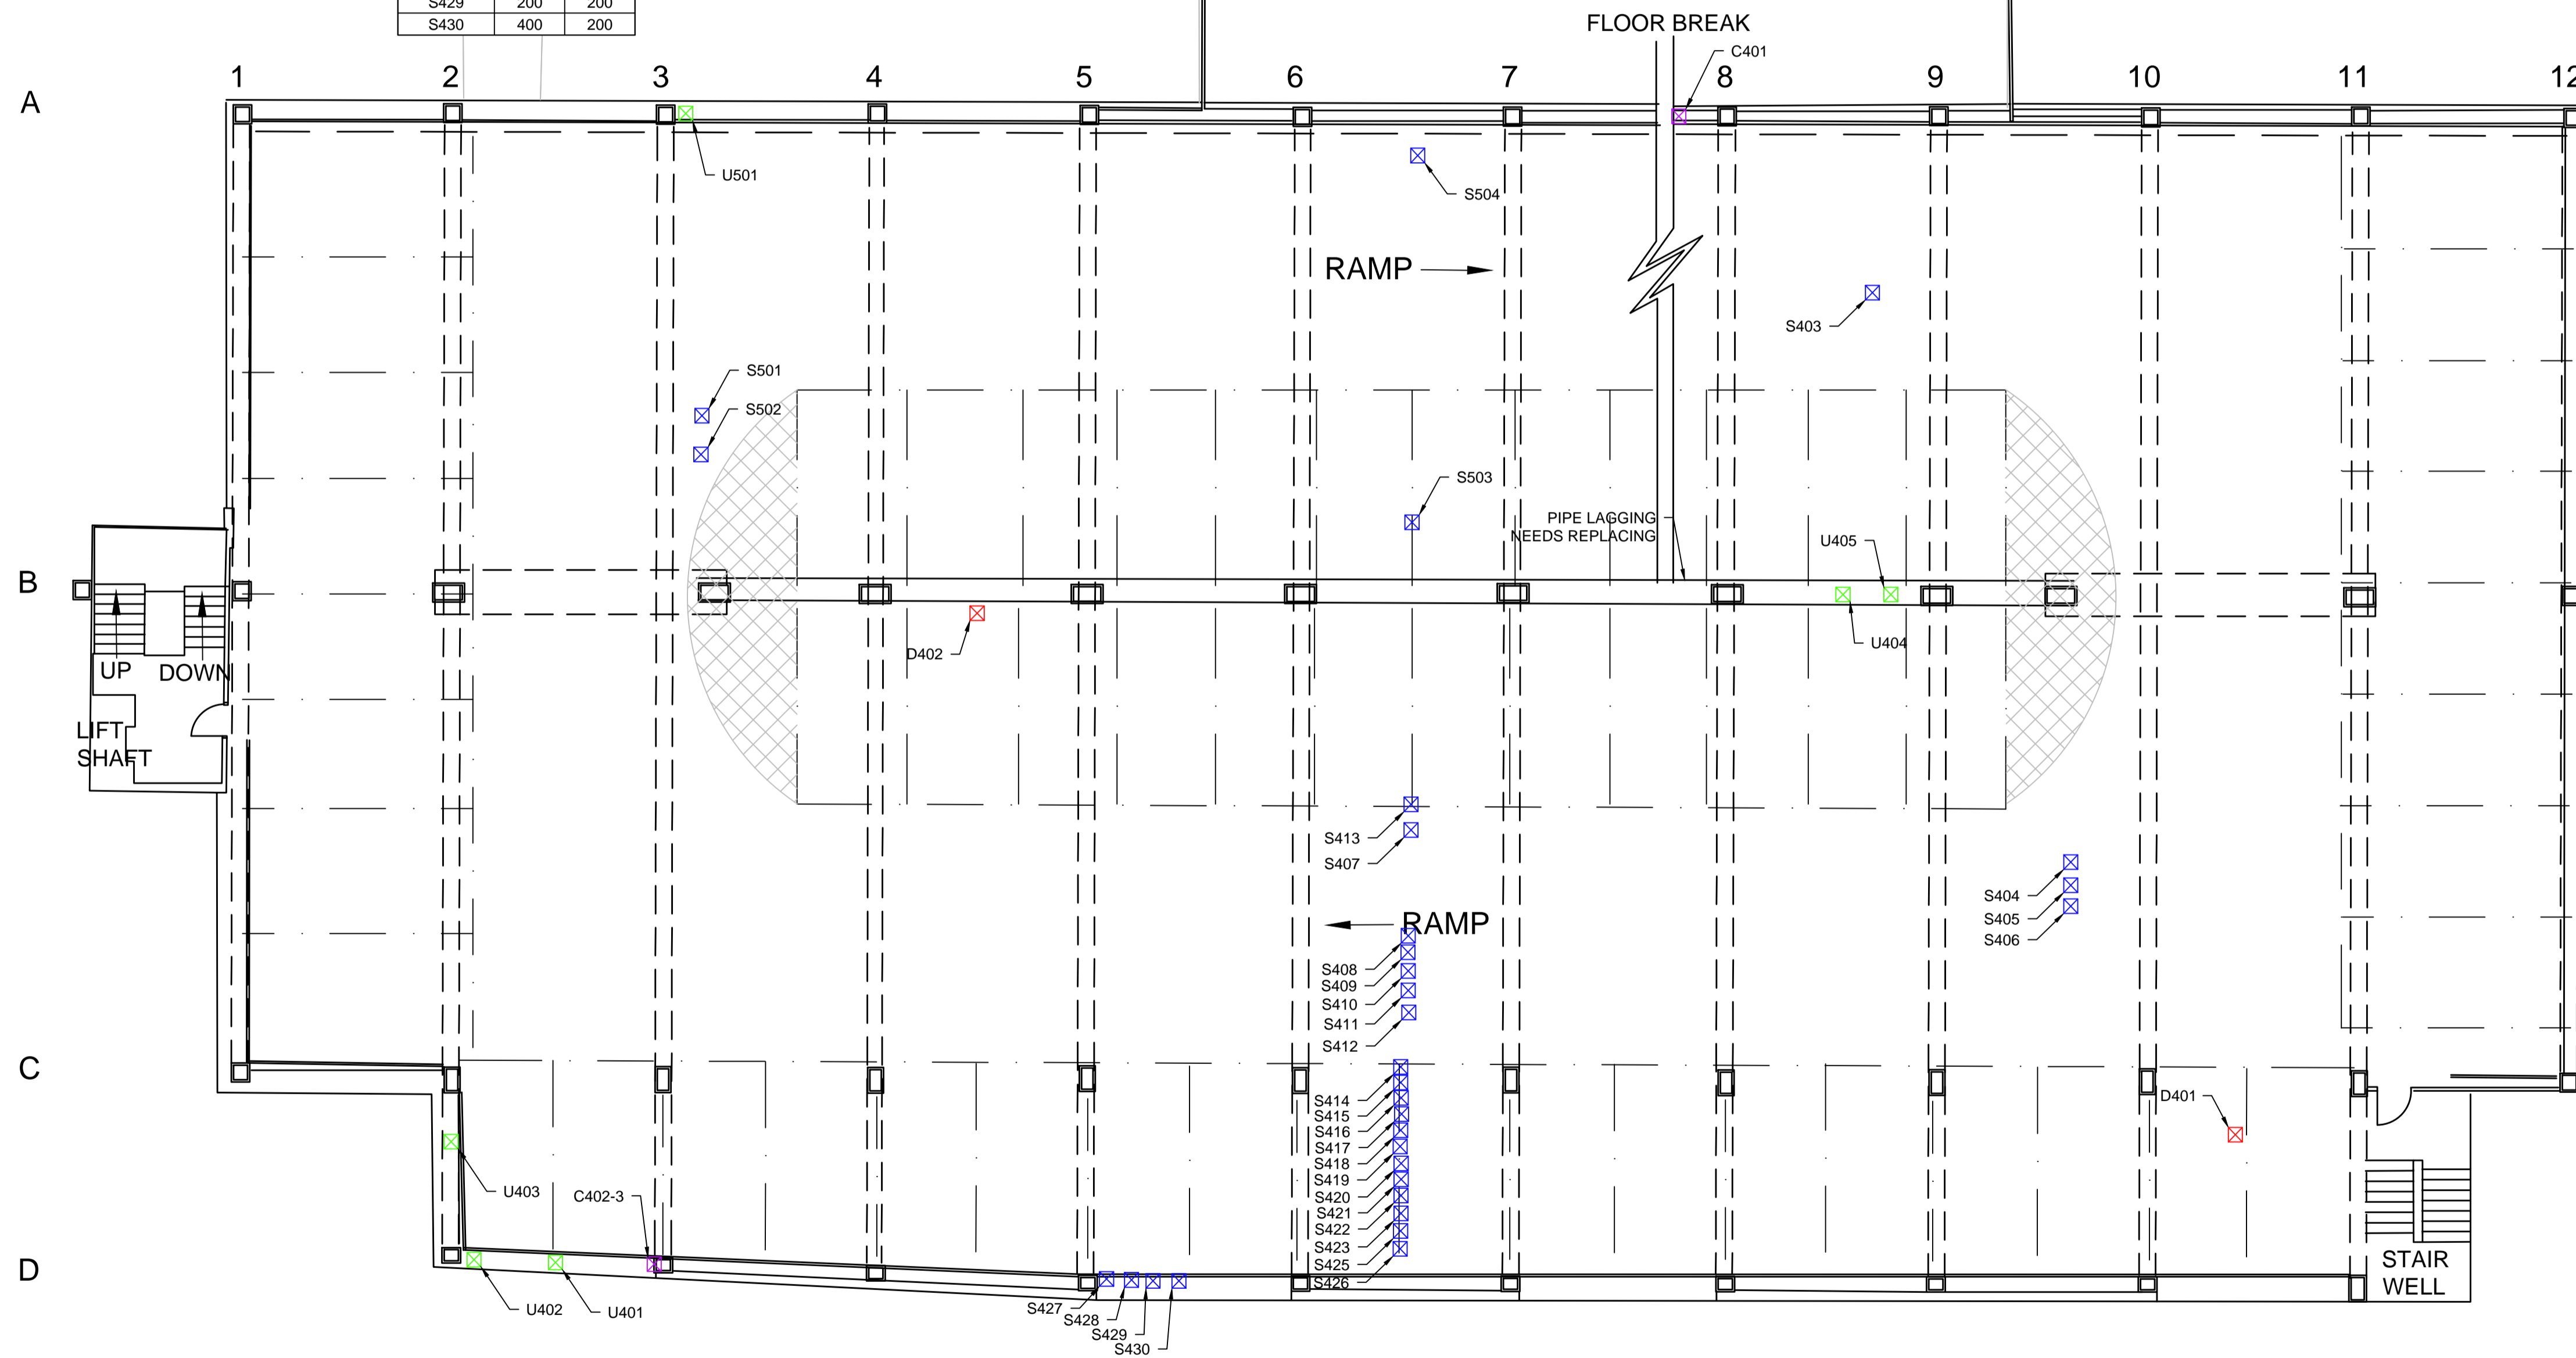

CHATTERTON SQUARE

LEVEL 4 FLOOR PLAN
NOT TO SCALE

This map is reproduced from Ordnance Survey® material by Holcrow on behalf of Bristol City Council with the permission of the Controller of Her Majesty's Stationery Office. © Crown copyright. Unauthorised reproduction infringes Crown copyright and may lead to prosecution or civil proceedings. Licence Number :100023406

Rev	By	Chkd	Apprvd	Date	Description
A	FG	AP	RB	13/02/2018	FIRST ISSUE



CH2M HILL
1 The Square Temple Quay Bristol BS1 6DG
Tel +44 (0)117 910 2580 Fax +44 (0)117 910 2581




Project
TEMPLE GATE MULTI STOREY CAR PARK STUDY

Drawing
TEMPLE GATE LEVEL 4 DEFECTS


Drawn by: FG	Date: 13/02/2018
Checked by: AP	Date: 13/02/2018
Approved by: RB	Date: 13/02/2018

Drawing No.	Revision
673846-TG-110	A


Drawing Scale: NTS

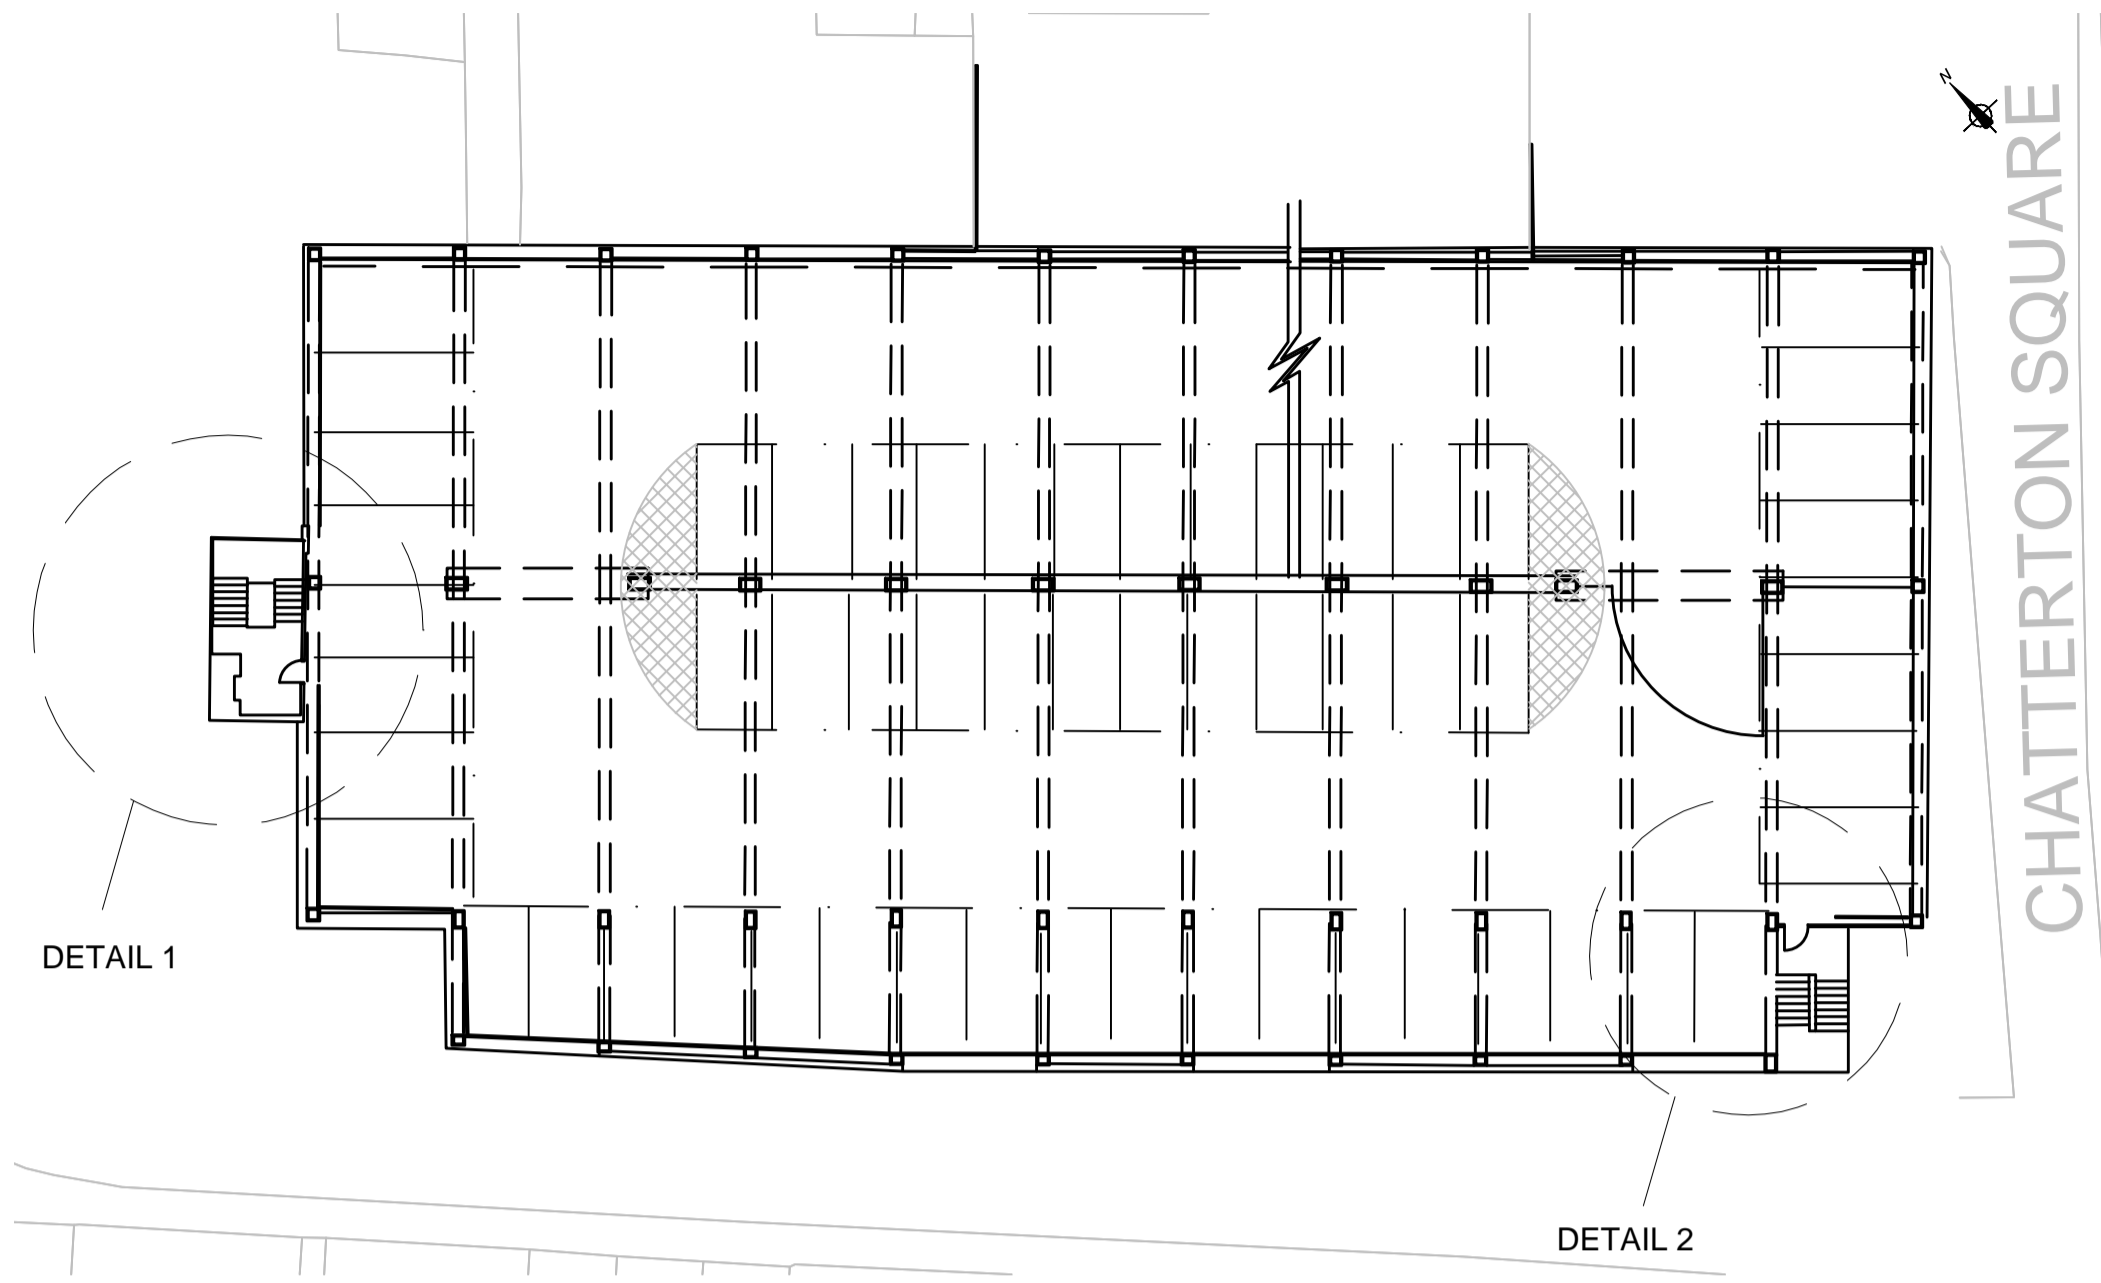

LEVEL 5 FLOOR PLAN
NOT TO SCALE

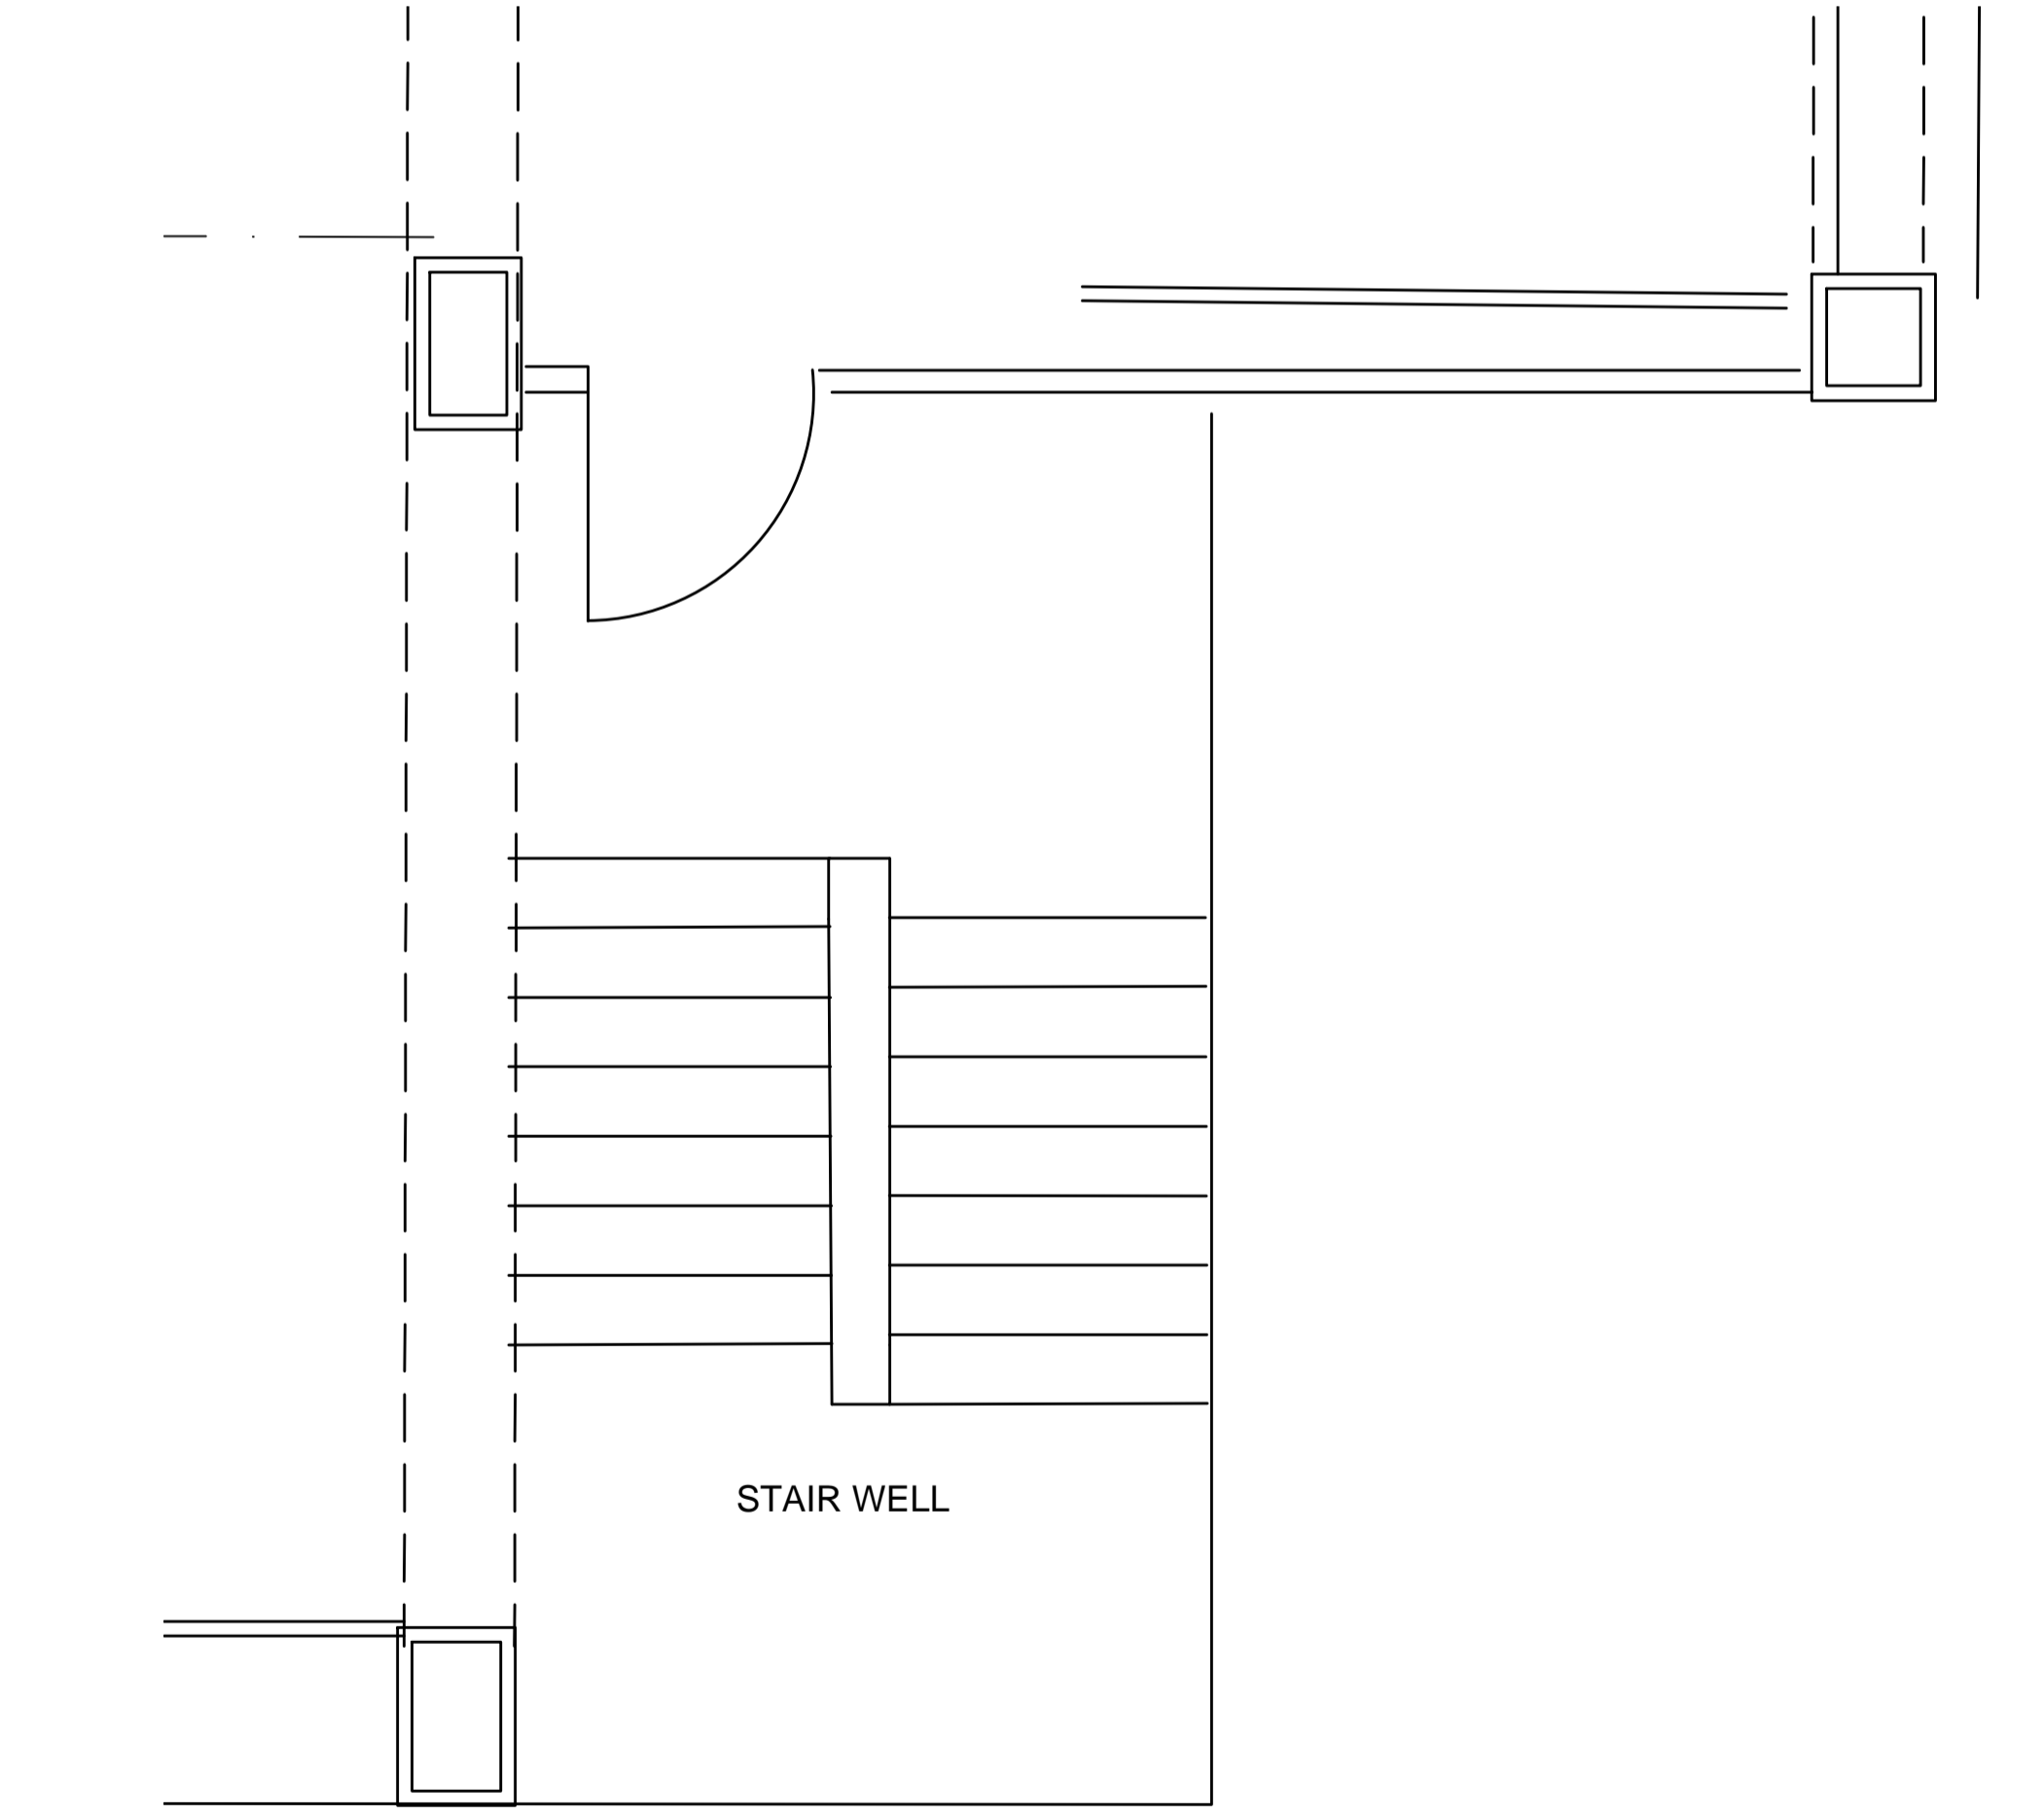

DETAIL 2
NOT TO SCALE

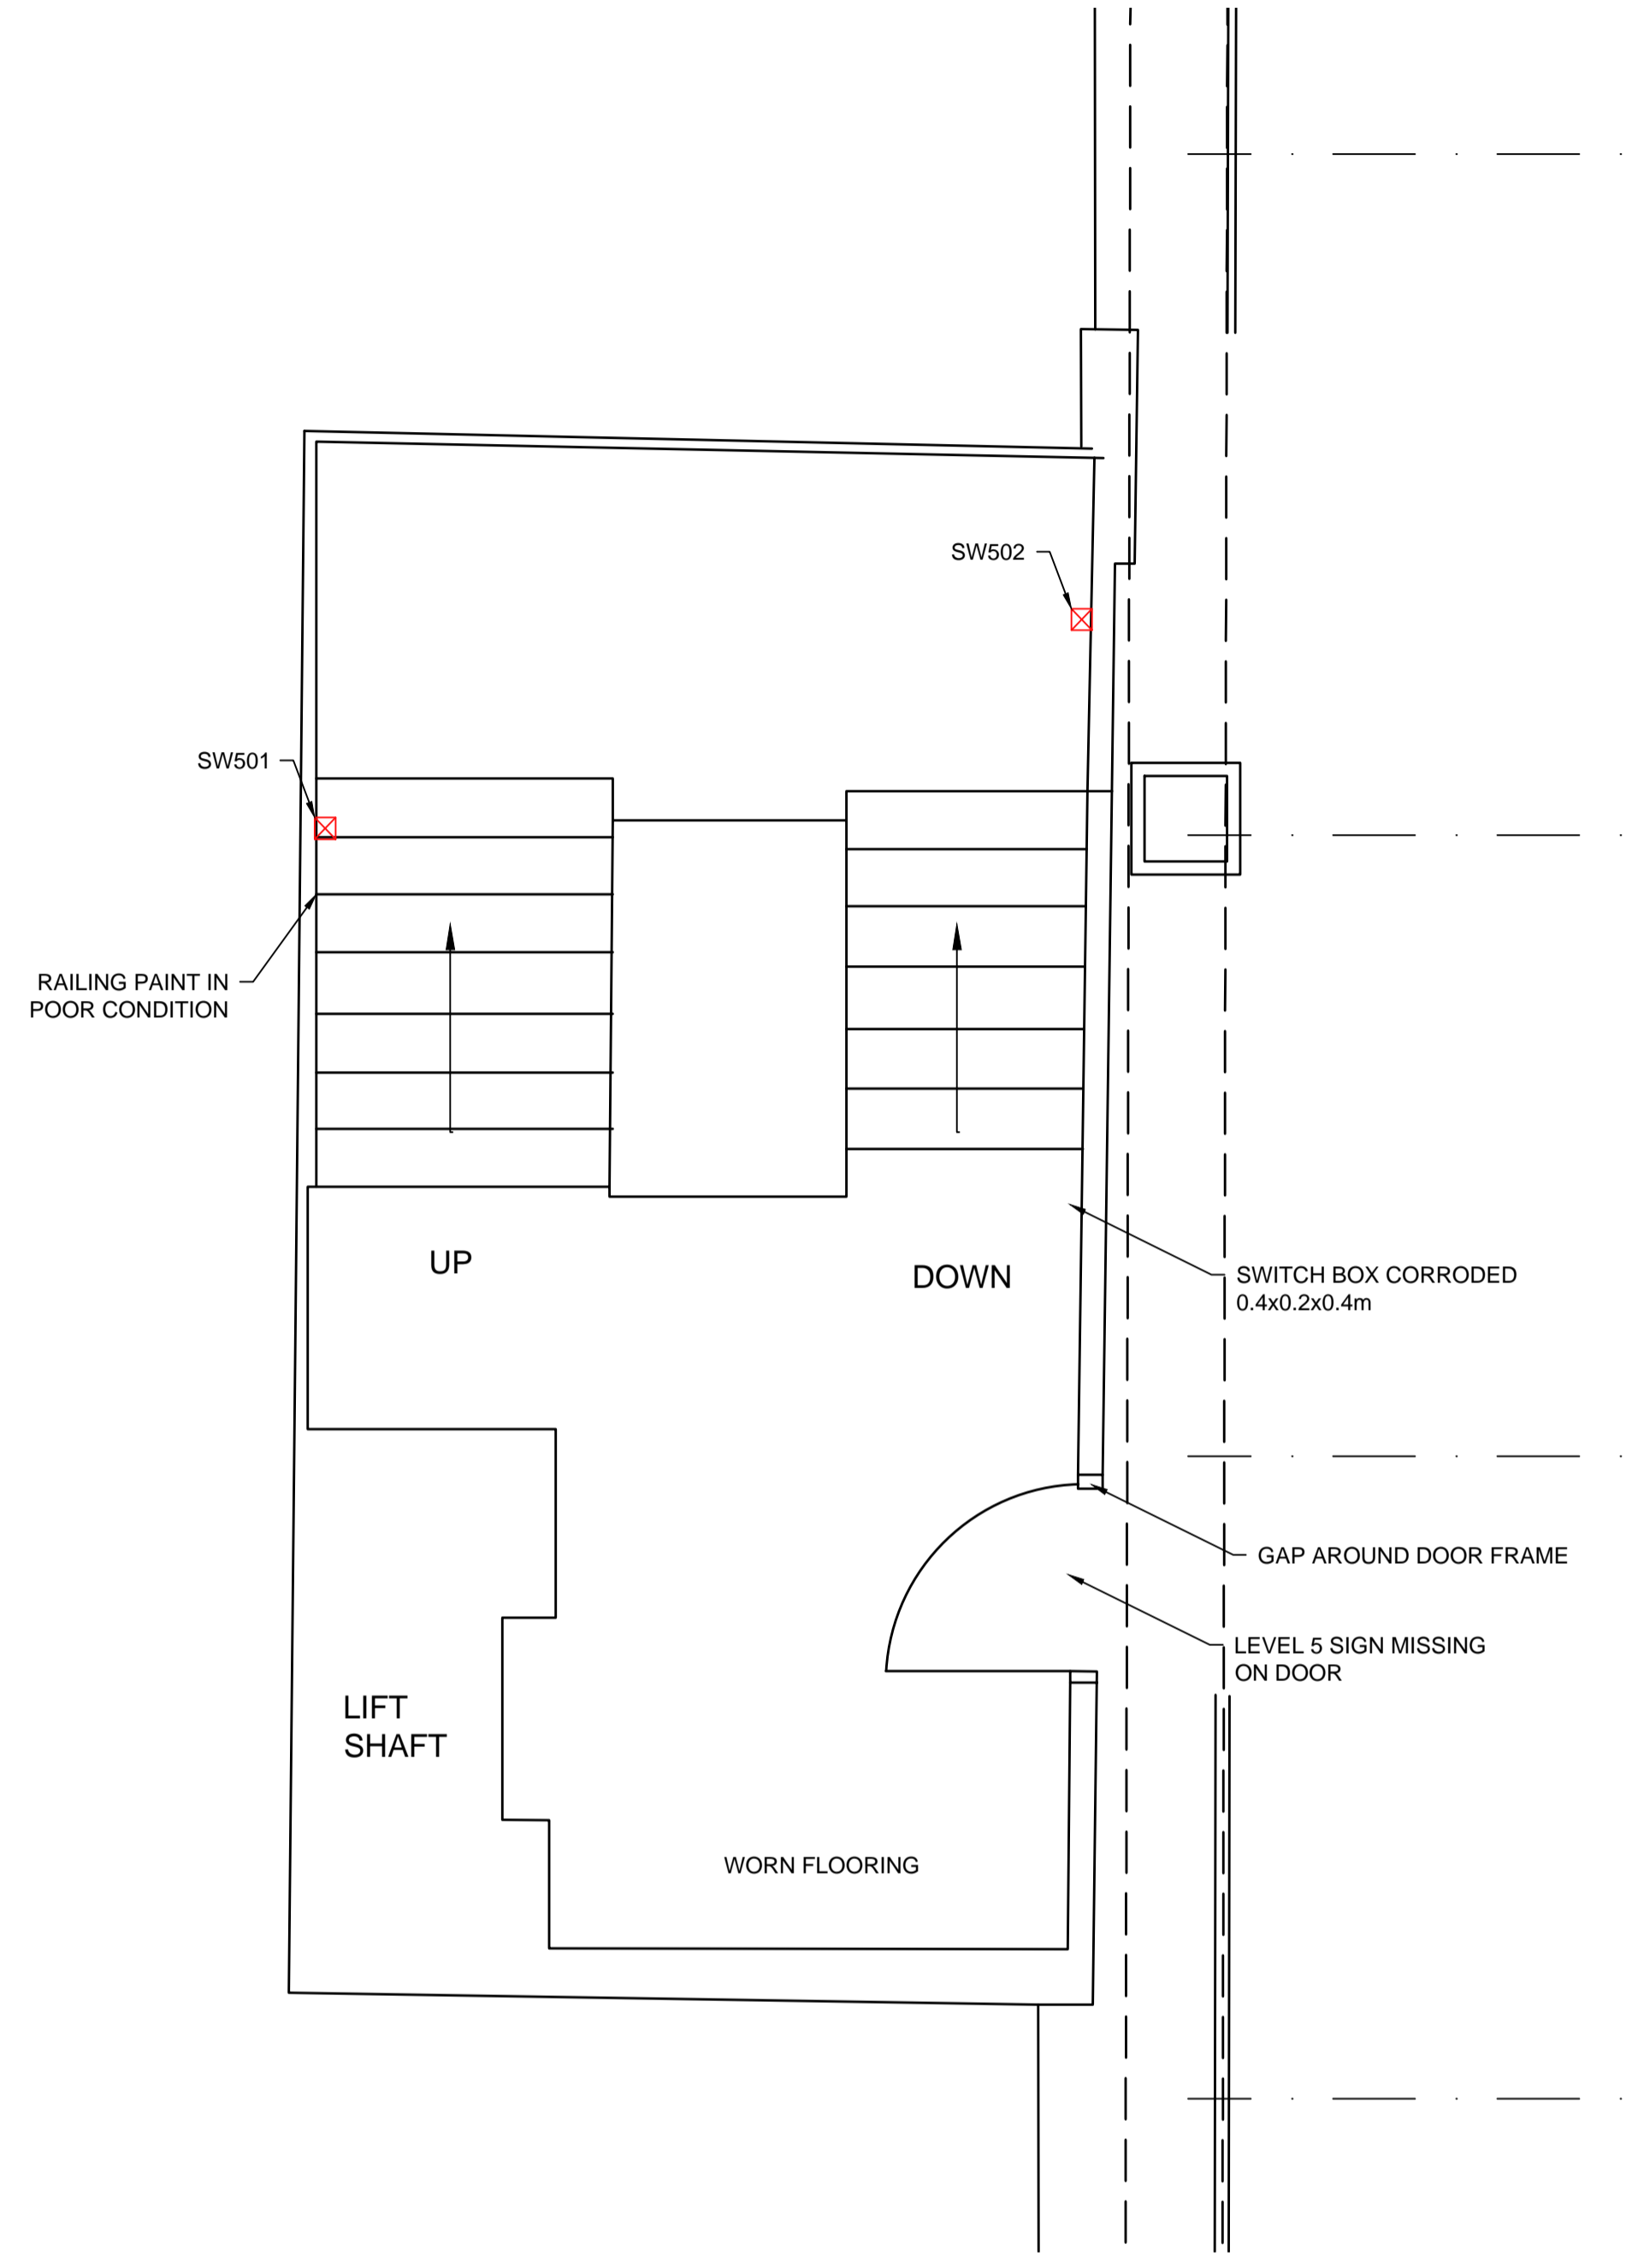

DETAIL 1
NOT TO SCALE

CONCRETE REPAIR SCHEDULE - STAIR WELLS			
REPAIR REFERENCE	HEIGHT (mm)	LENGTH (mm)	WIDTH (mm)
SW501	100	100	100
SW502	-	100	100

KEY
 STAIR WELL DEFECT

Rev	By	Chkd	Apprvd	Date	Description
A	FG	AP	RB	13/02/2018	FIRST ISSUE



CH2M HILL
 1 The Square Temple Quay Bristol BS1 6DG
 Tel +44 (0)117 910 2580 Fax +44 (0)117 910 2581



Project
**TEMPLE GATE MULTI STOREY
 CAR PARK STUDY**

Drawing
**TEMPLE GATE
 LEVEL 5
 STAIRCASE DEFECTS**

Drawn by: FG Date: 13/02/2018
 Checked by: AP Date: 13/02/2018
 Approved by: RB Date: 13/02/2018

Drawing No.	Revision
673846-TG-111	A


Drawing Scale: NTS

This map is reproduced from Ordnance Survey® material by Halcrow on behalf of Bristol City Council with the permission of the Controller of Her Majesty's Stationery Office. © Crown copyright. Unauthorised reproduction infringes Crown copyright and may lead to prosecution or civil proceedings. Licence Number : 100023406

CONCRETE REPAIR SCHEDULE - DECK		
REPAIR REFERENCE	LENGTH (mm)	WIDTH (mm)
D501	100	100
D502	100	100
D503	100	100
D504	500	200
D505	300	400
D506	900	200
D507	150	100
D508		
D509		
D510	200	500
D511	150	150
D512	150	250
D513	100	100
D514	500	200

CONCRETE REPAIR SCHEDULE - UPSTAND				
REPAIR REFERENCE	HEIGHT (mm)	LENGTH (mm)	WIDTH (mm)	
U501	100	100	300	

KEY
 PPS: PEELING PAINT SOFFIT
 ☒ DECK DEFECT
 ☒ UPSTAND DEFECT

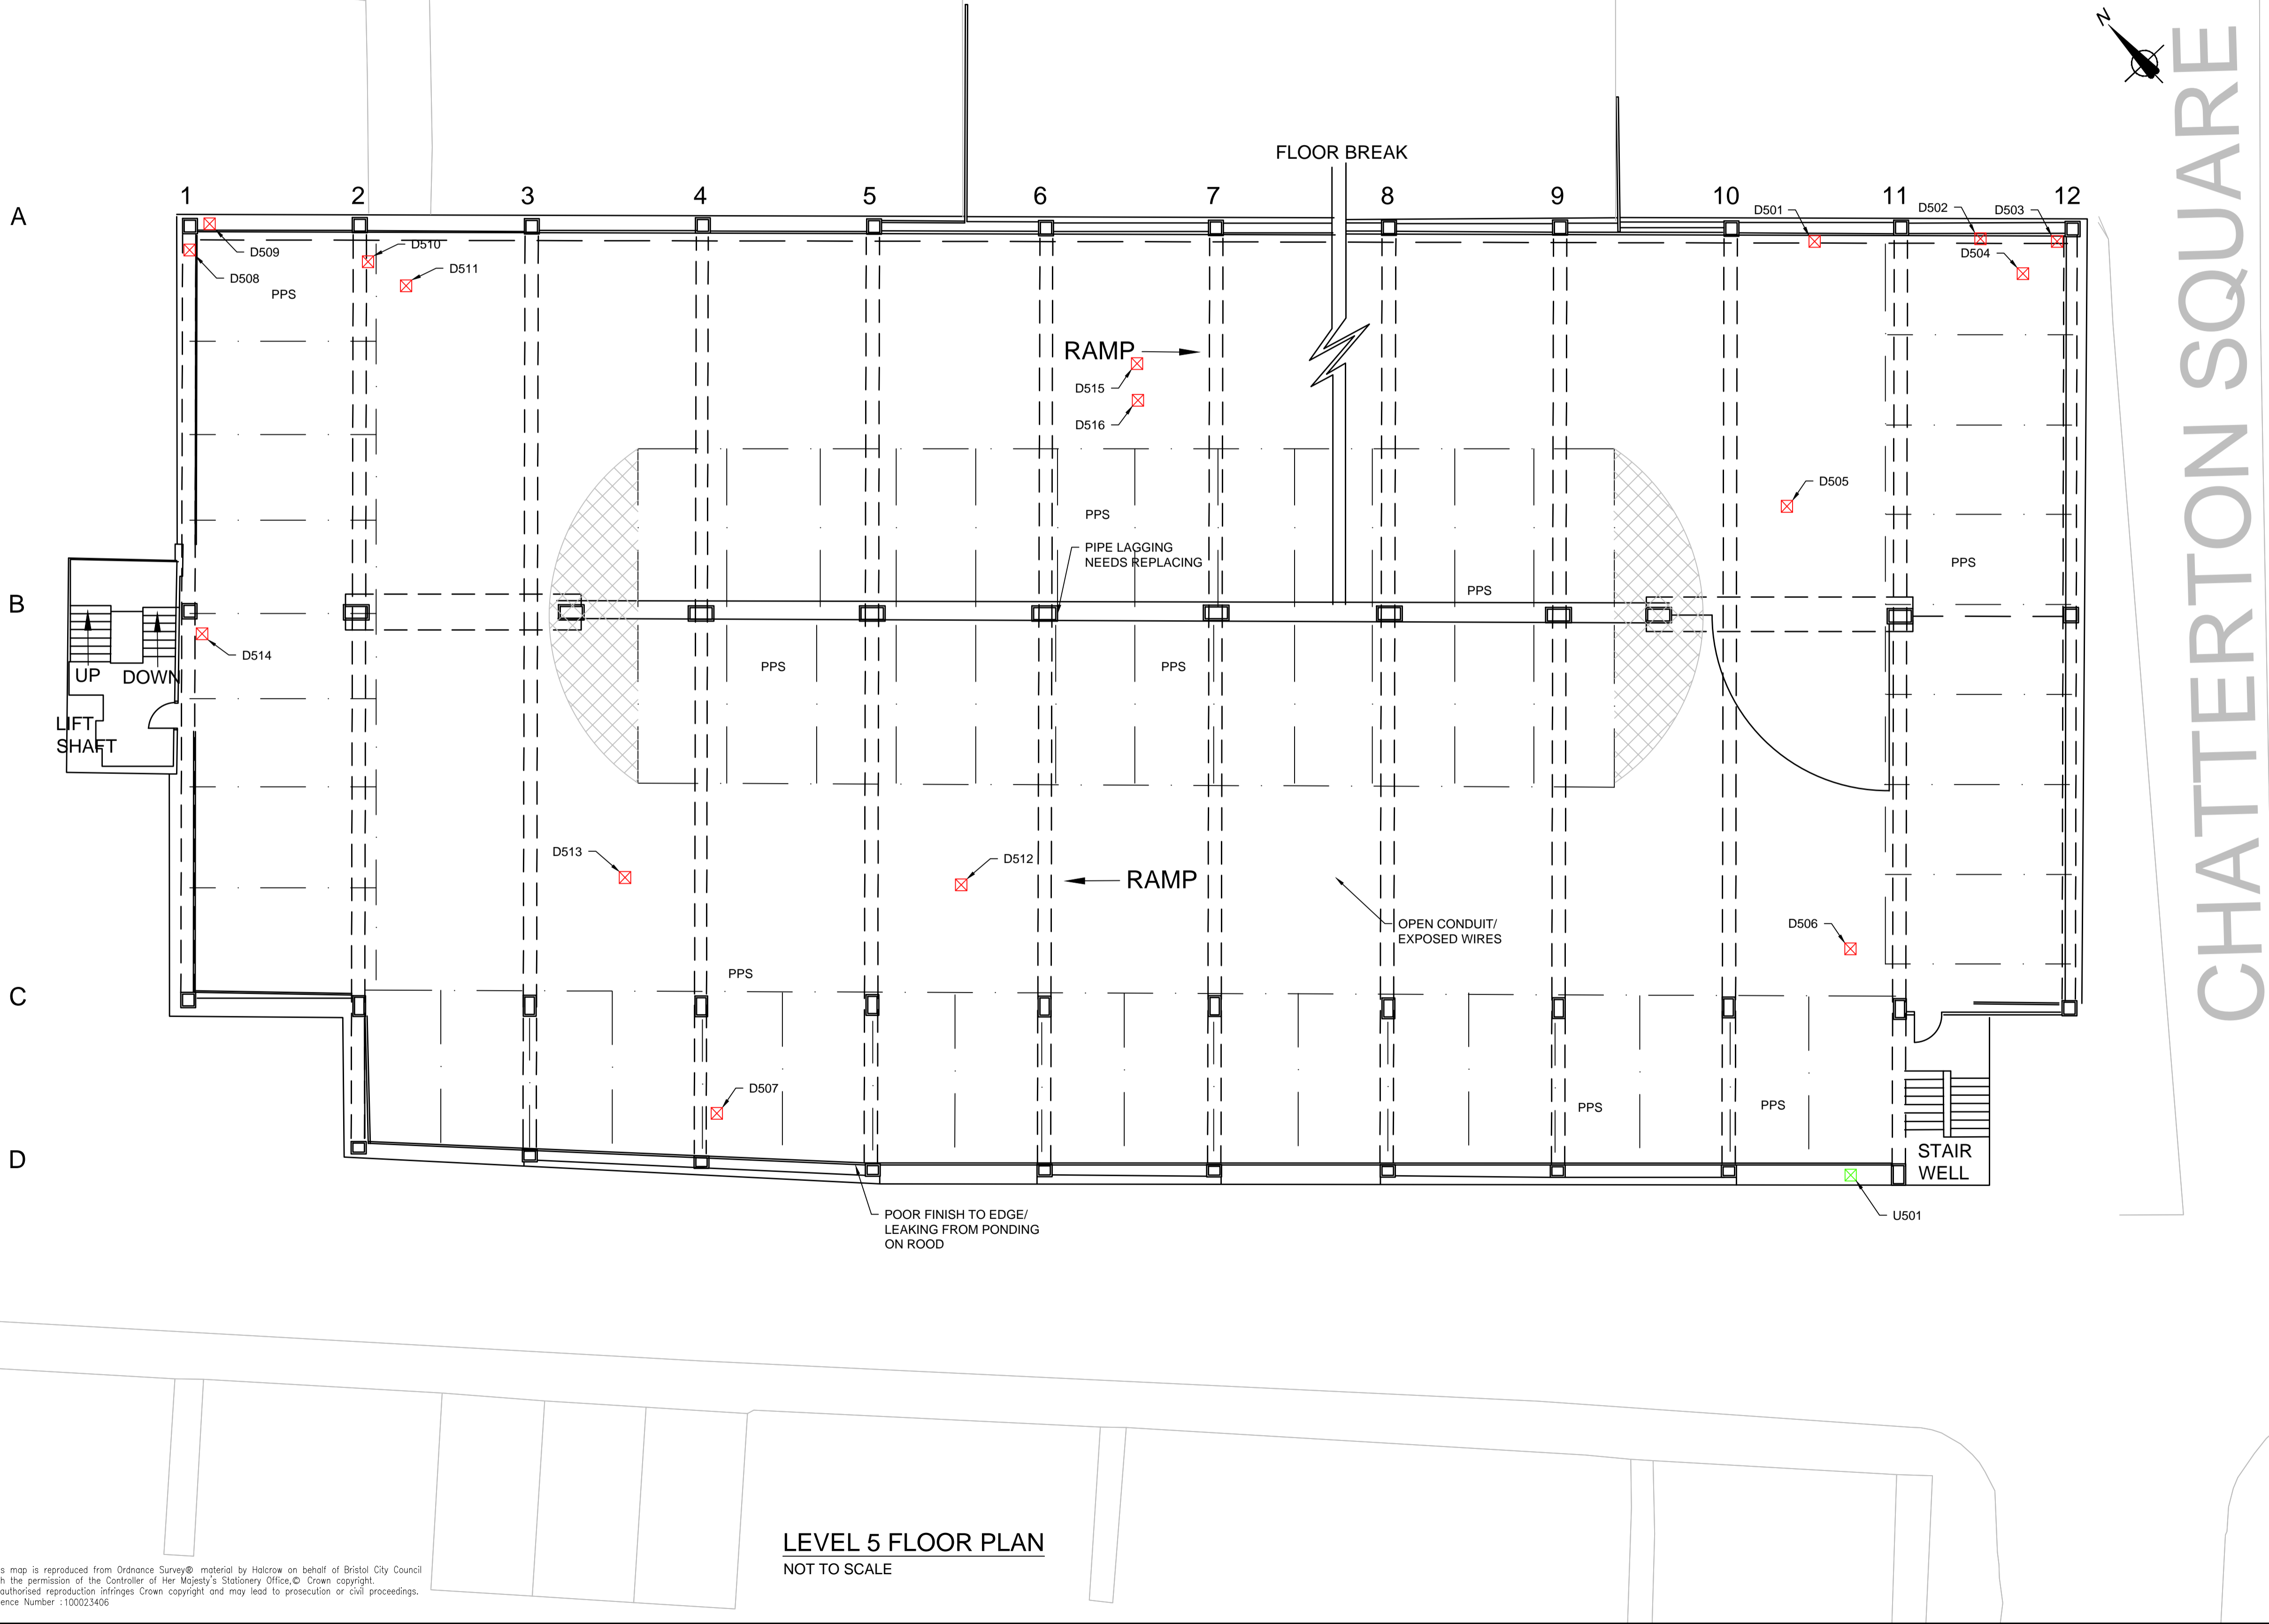

CHATTERTON SQUARE

LEVEL 5 FLOOR PLAN
 NOT TO SCALE

This map is reproduced from Ordnance Survey® material by Halcrow on behalf of Bristol City Council with the permission of the Controller of Her Majesty's Stationery Office. © Crown copyright. Unauthorised reproduction infringes Crown copyright and may lead to prosecution or civil proceedings. Licence Number :100023406

Rev	By	Chkd	Apprvd	Date	Description
A	FG	AP	RB	13/02/2018	FIRST ISSUE



CH2M HILL
 1 The Square Temple Quay Bristol BS1 6DG
 Tel +44 (0)117 910 2580 Fax +44 (0)117 910 2581




Project
TEMPLE GATE MULTI STOREY CAR PARK STUDY

Drawing
TEMPLE GATE LEVEL 5 DEFECTS


Drawn by: FG	Date: 13/02/2018
Checked by: AP	Date: 13/02/2018
Approved by: RB	Date: 13/02/2018

Drawing No.	Revision
673846-TG-112	A


Drawing Scale: NTS

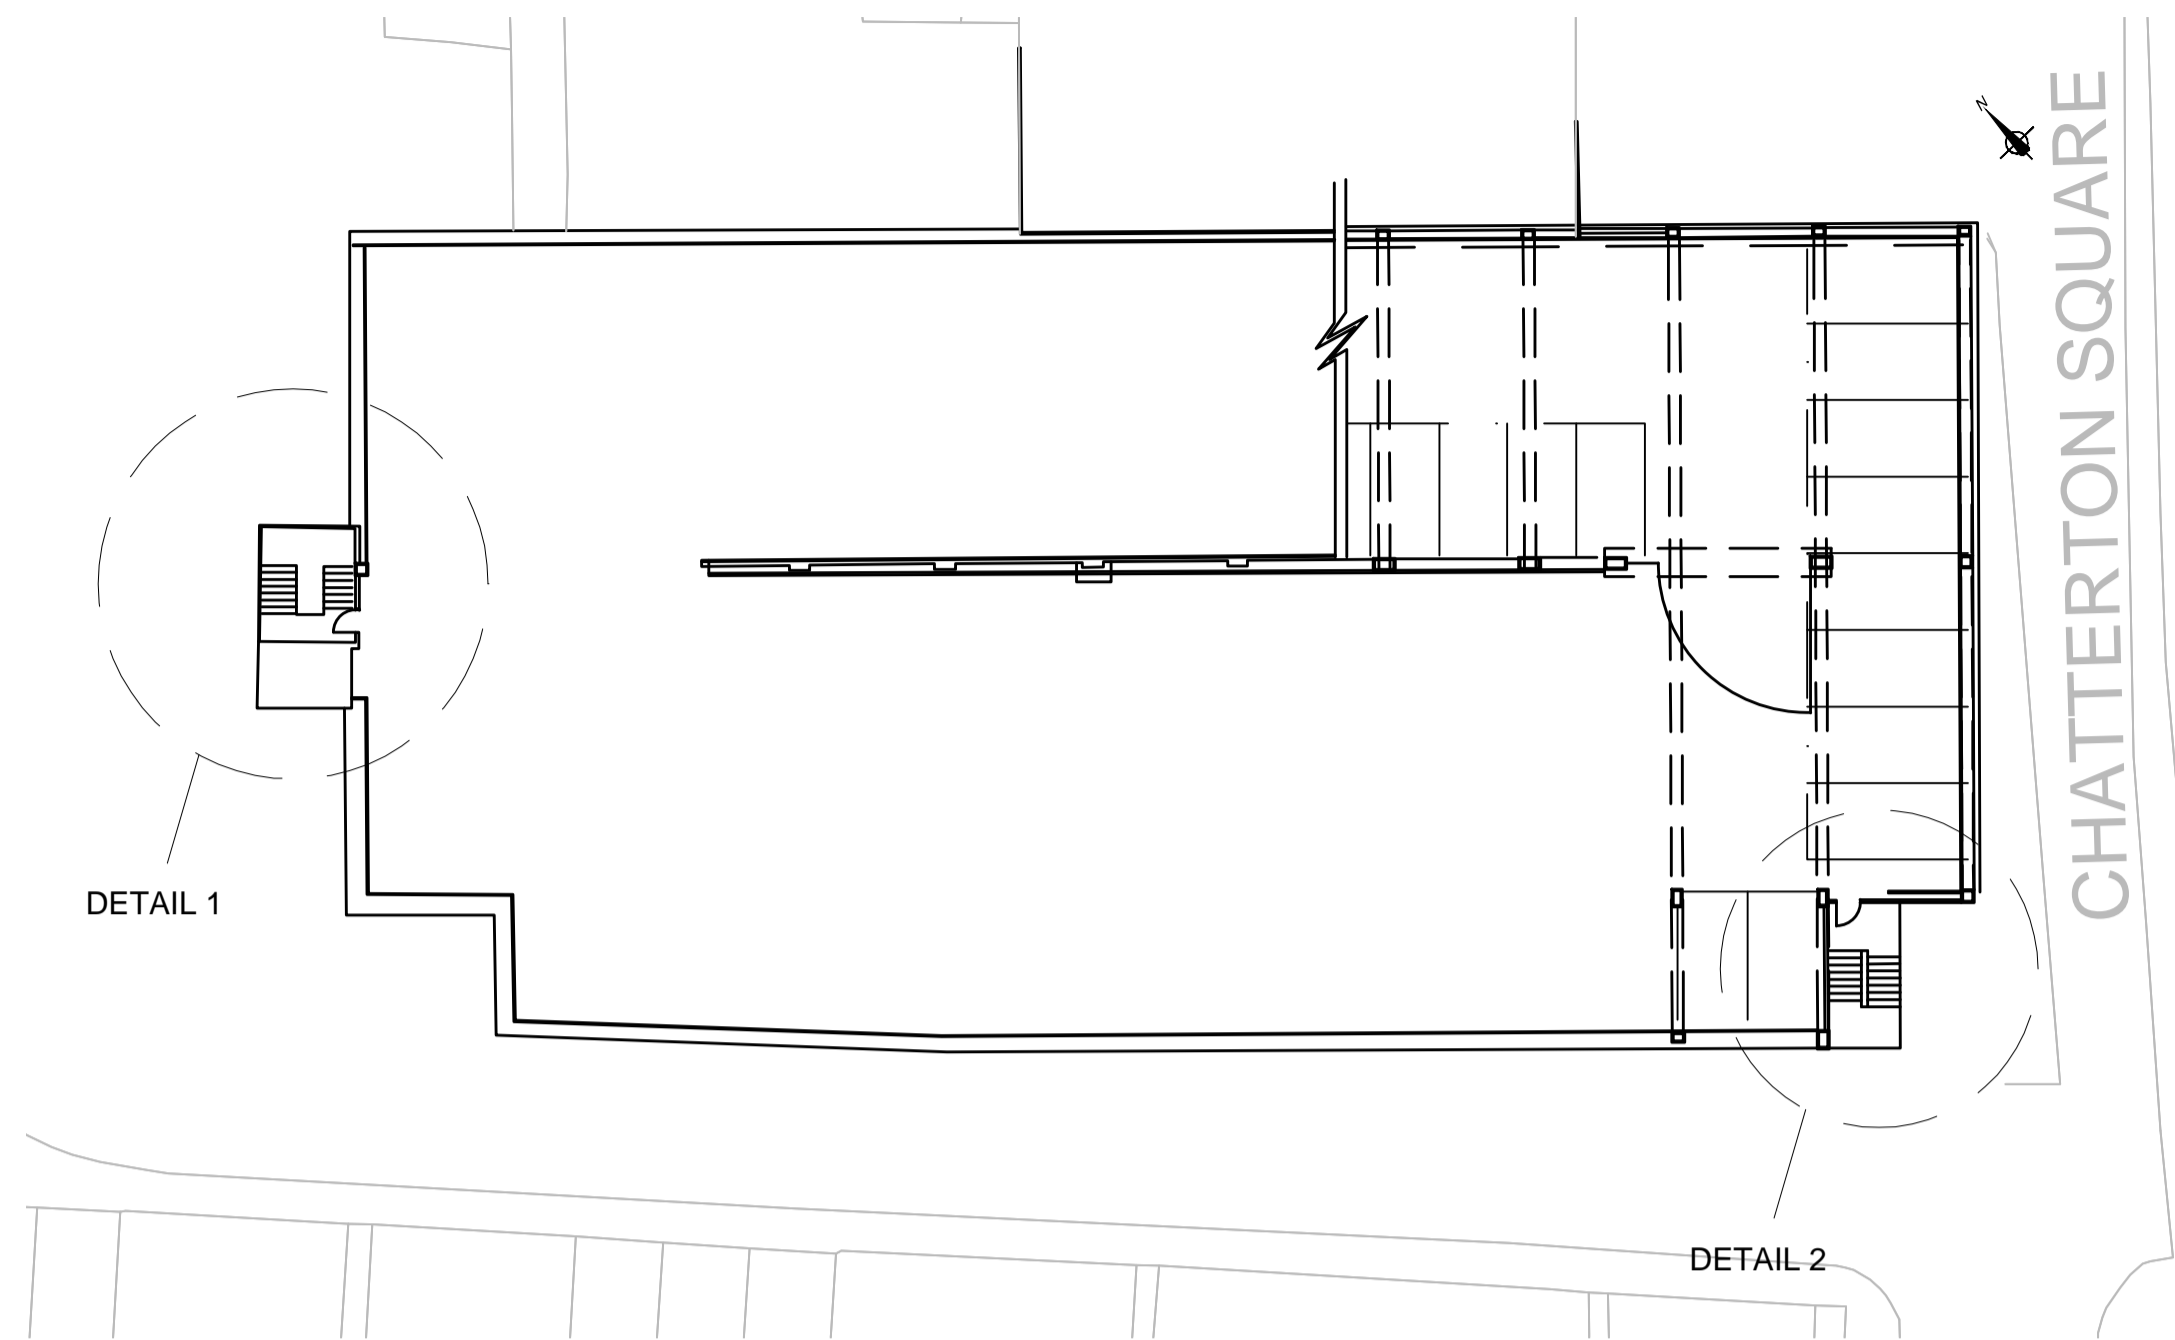

LEVEL 6 FLOOR PLAN
NOT TO SCALE

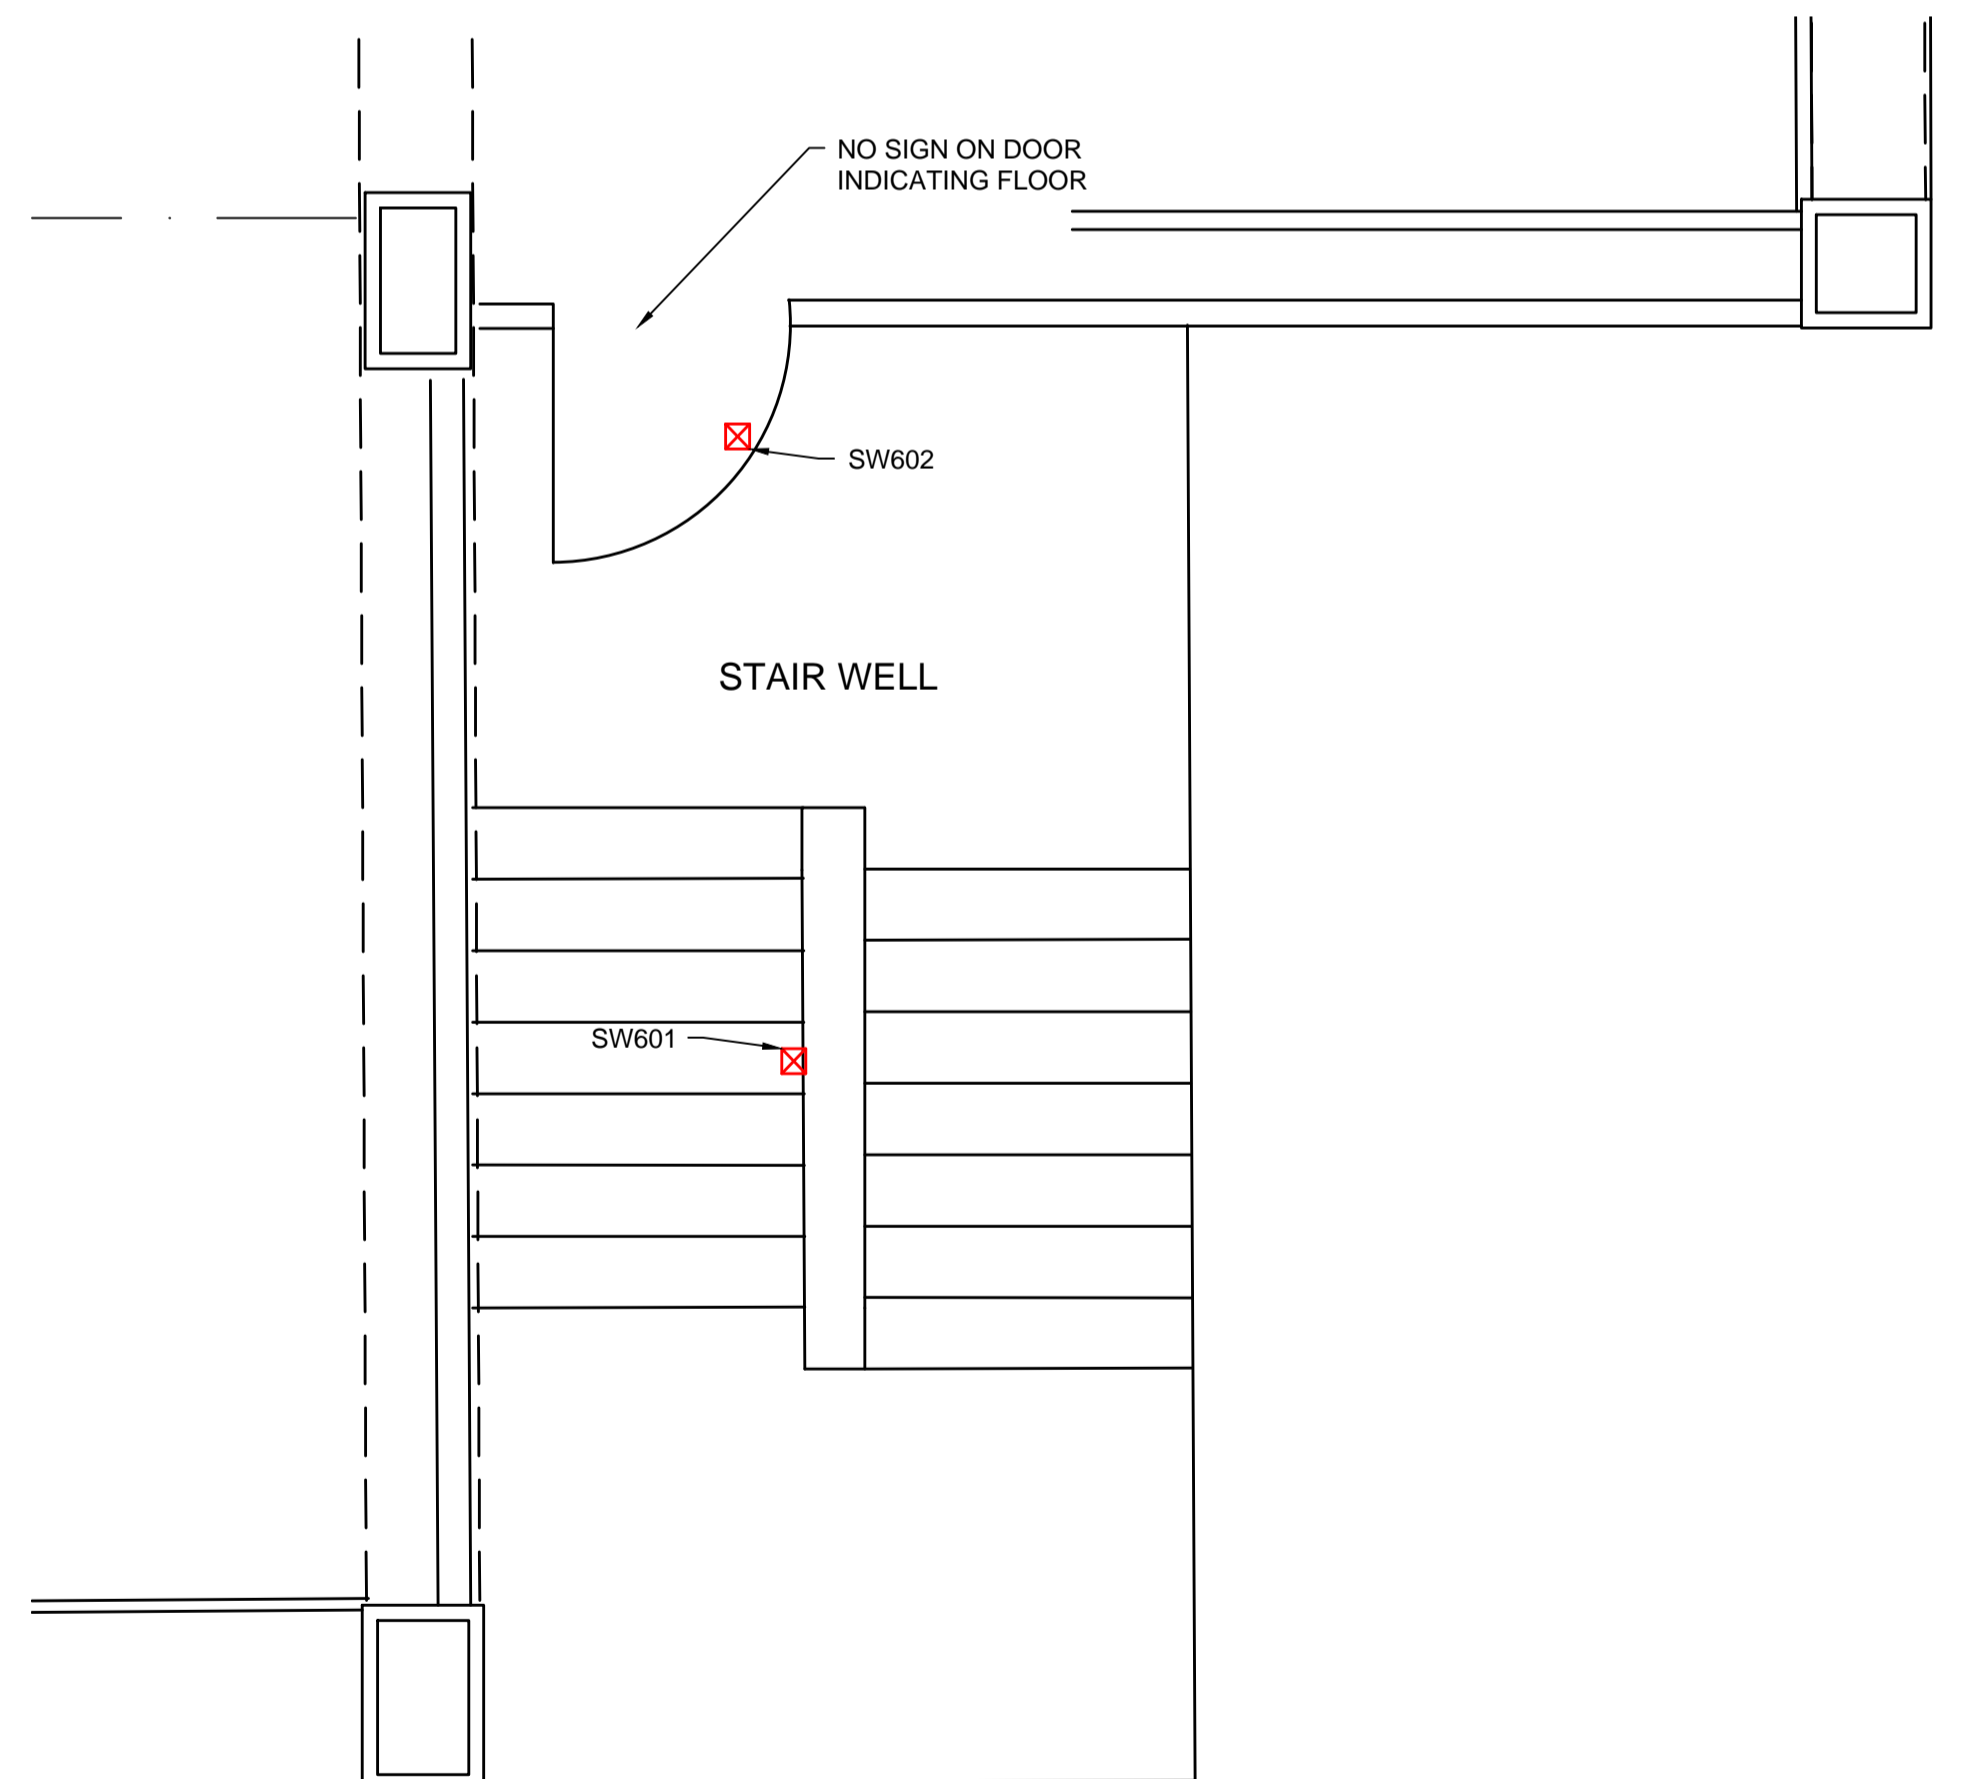

DETAIL 2
NOT TO SCALE

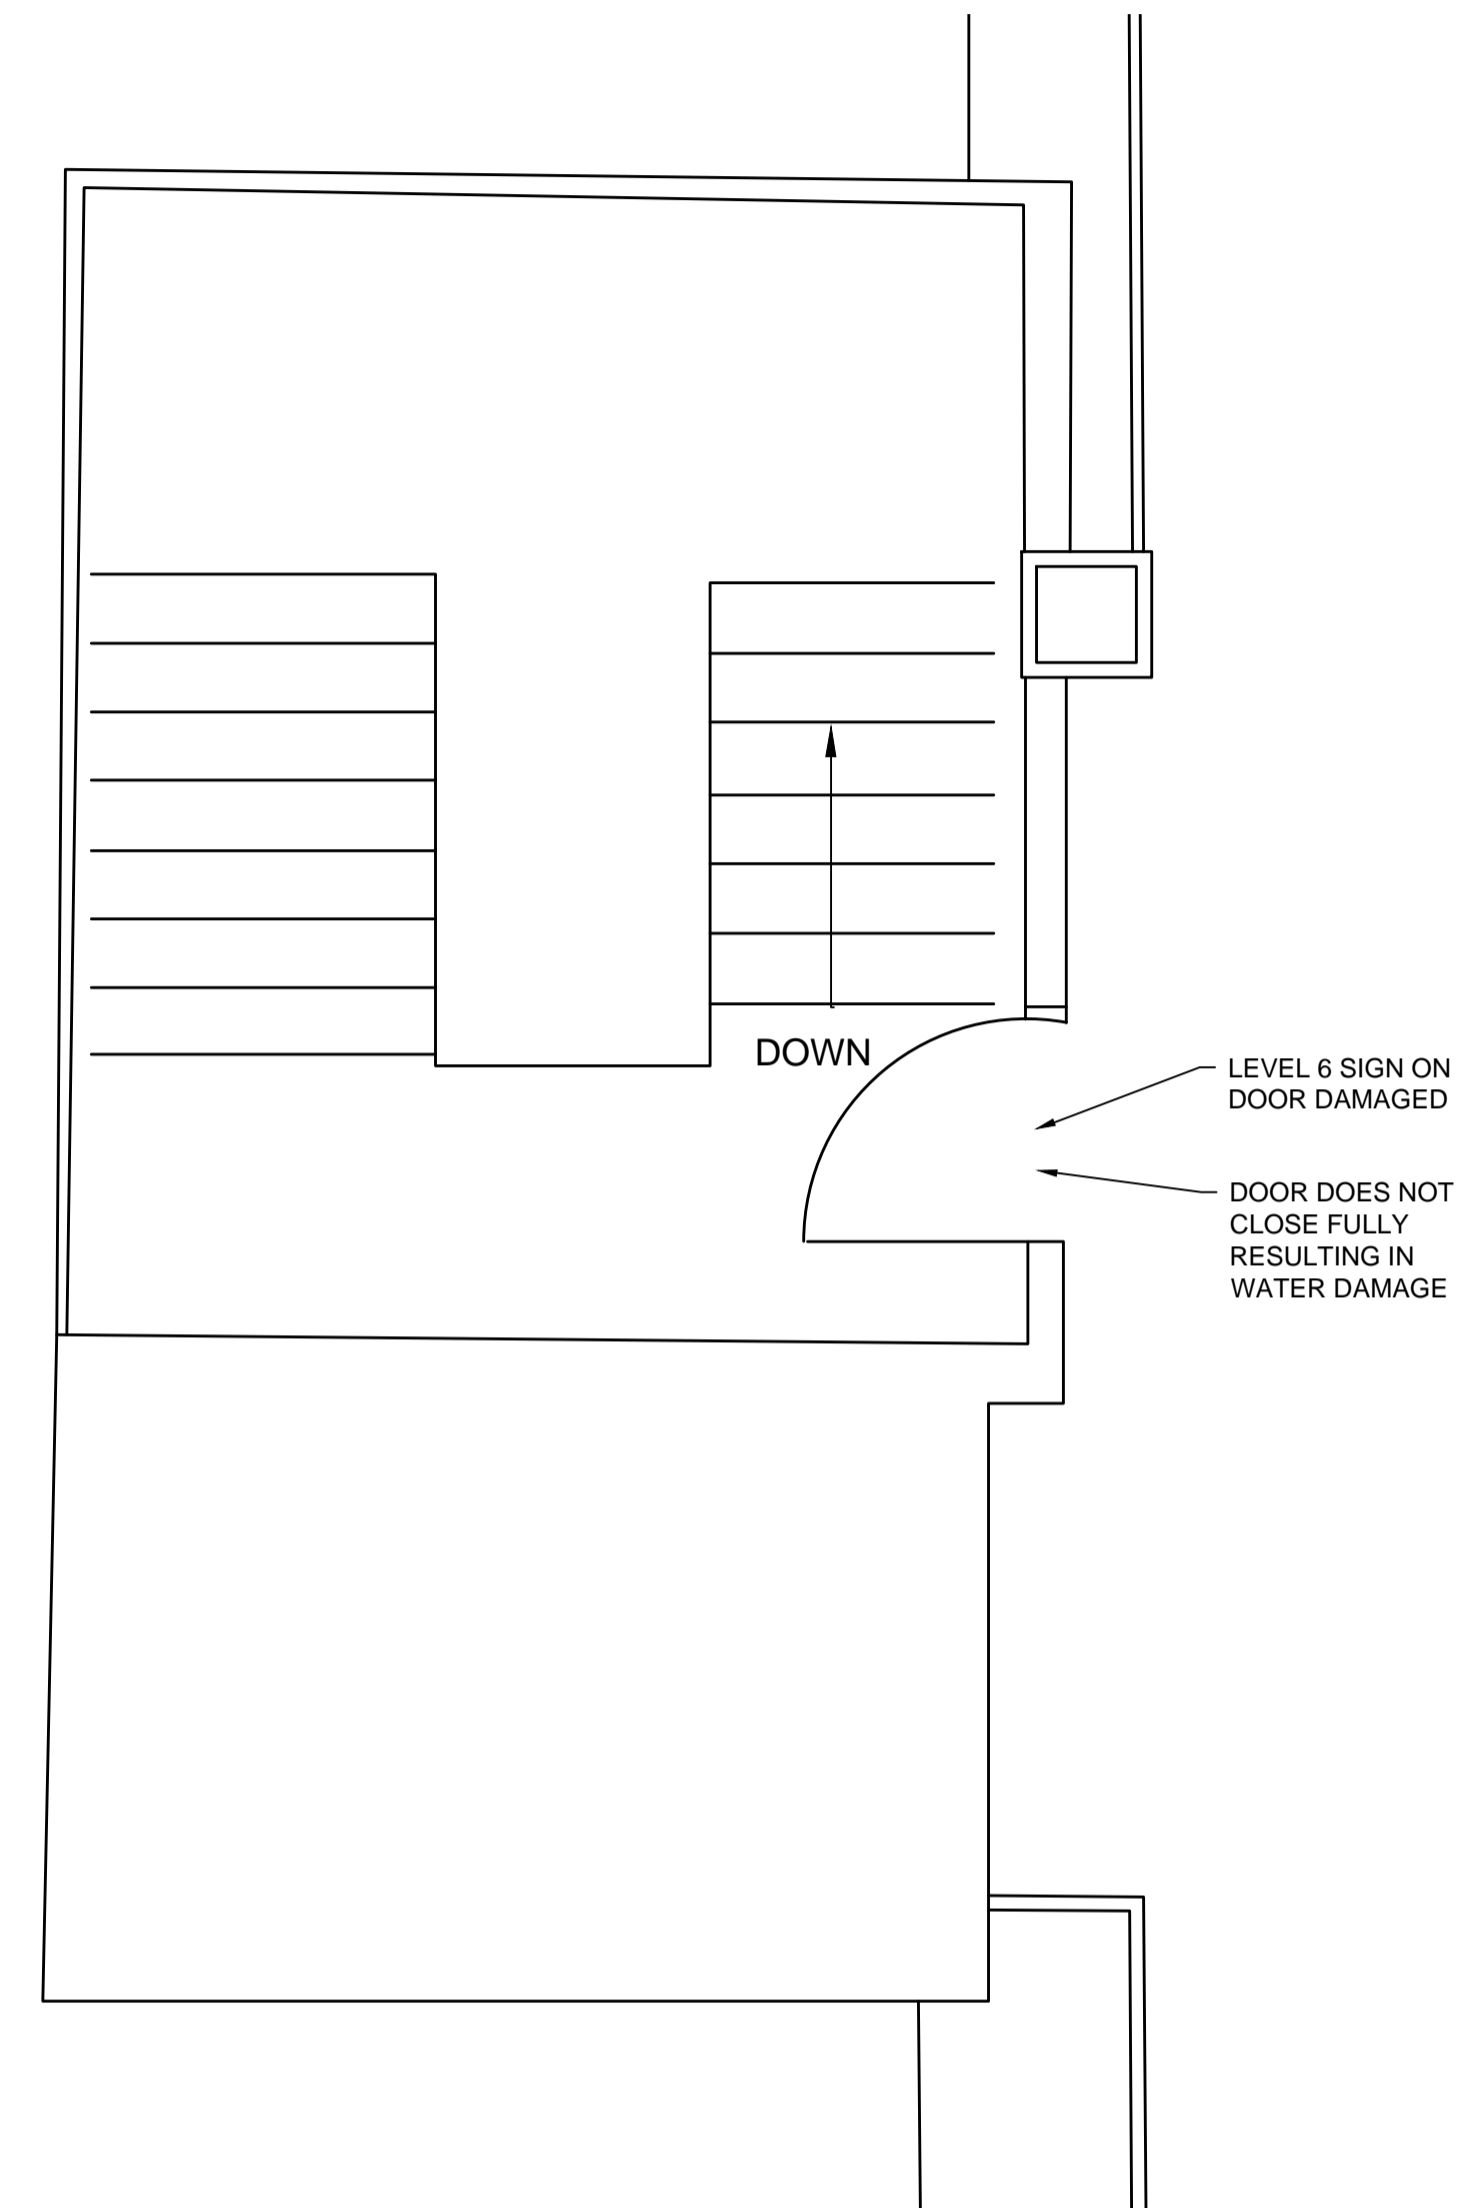

DETAIL 1
NOT TO SCALE

CONCRETE REPAIR SCHEDULE
- STAIR WELLS

REPAIR REFERENCE	LENGTH (mm)	WIDTH (mm)
SW601	100	250
SW602	100	250

KEY

☒ STAIR WELL DEFECT

Rev	By	Chkd	Apprvd	Date	DESCRIPTION
A	FG	AP	RB	13/02/2018	FIRST ISSUE

Client



CH2M HILL
1 The Square Temple Quay Bristol BS1 6DG
Tel +44 (0)117 910 2580 Fax +44 (0)117 910 2581



Project

TEMPLE GATE MULTI STOREY
CAR PARK STUDY

Drawing

TEMPLE GATE
LEVEL 6
STAIRCASE DEFECTS

Drawn by: FG Date: 13/02/2018

Checked by: AP Date: 13/02/2018

Approved by: RB Date: 13/02/2018

Drawing No.

673846-TG-113

Revision

A

Drawing Scale: NTS

CONCRETE REPAIR SCHEDULE - DECK		
REPAIR REFERENCE	LENGTH (mm)	WIDTH (mm)
D515	100	100
D516	100	150
D601	150	100
D602	500	200
D603	100	100


FAILED SURFACING SCHEDULE		
REPAIR REFERENCE	LENGTH (mm)	WIDTH (mm)
FC601.1	3400	400
FC601.2	1000	350
FC601.3	400	250
FC601.4	600	650
FC602	7250	1550
FC603	2600	650
FC604.1	350	100
FC604.2	250	100
FC605	100	100
FC606	550	750
FC607.1	400	250
FC607.2	850	100
FC607.3	100	100
FC608	250	100
FC609.1	400	200
FC609.2	100	200
FC610	2500	600

KEY

PPS: PEELING PAINT SOFFIT

☒ DECK DEFECT

☒ FAILED SURFACING

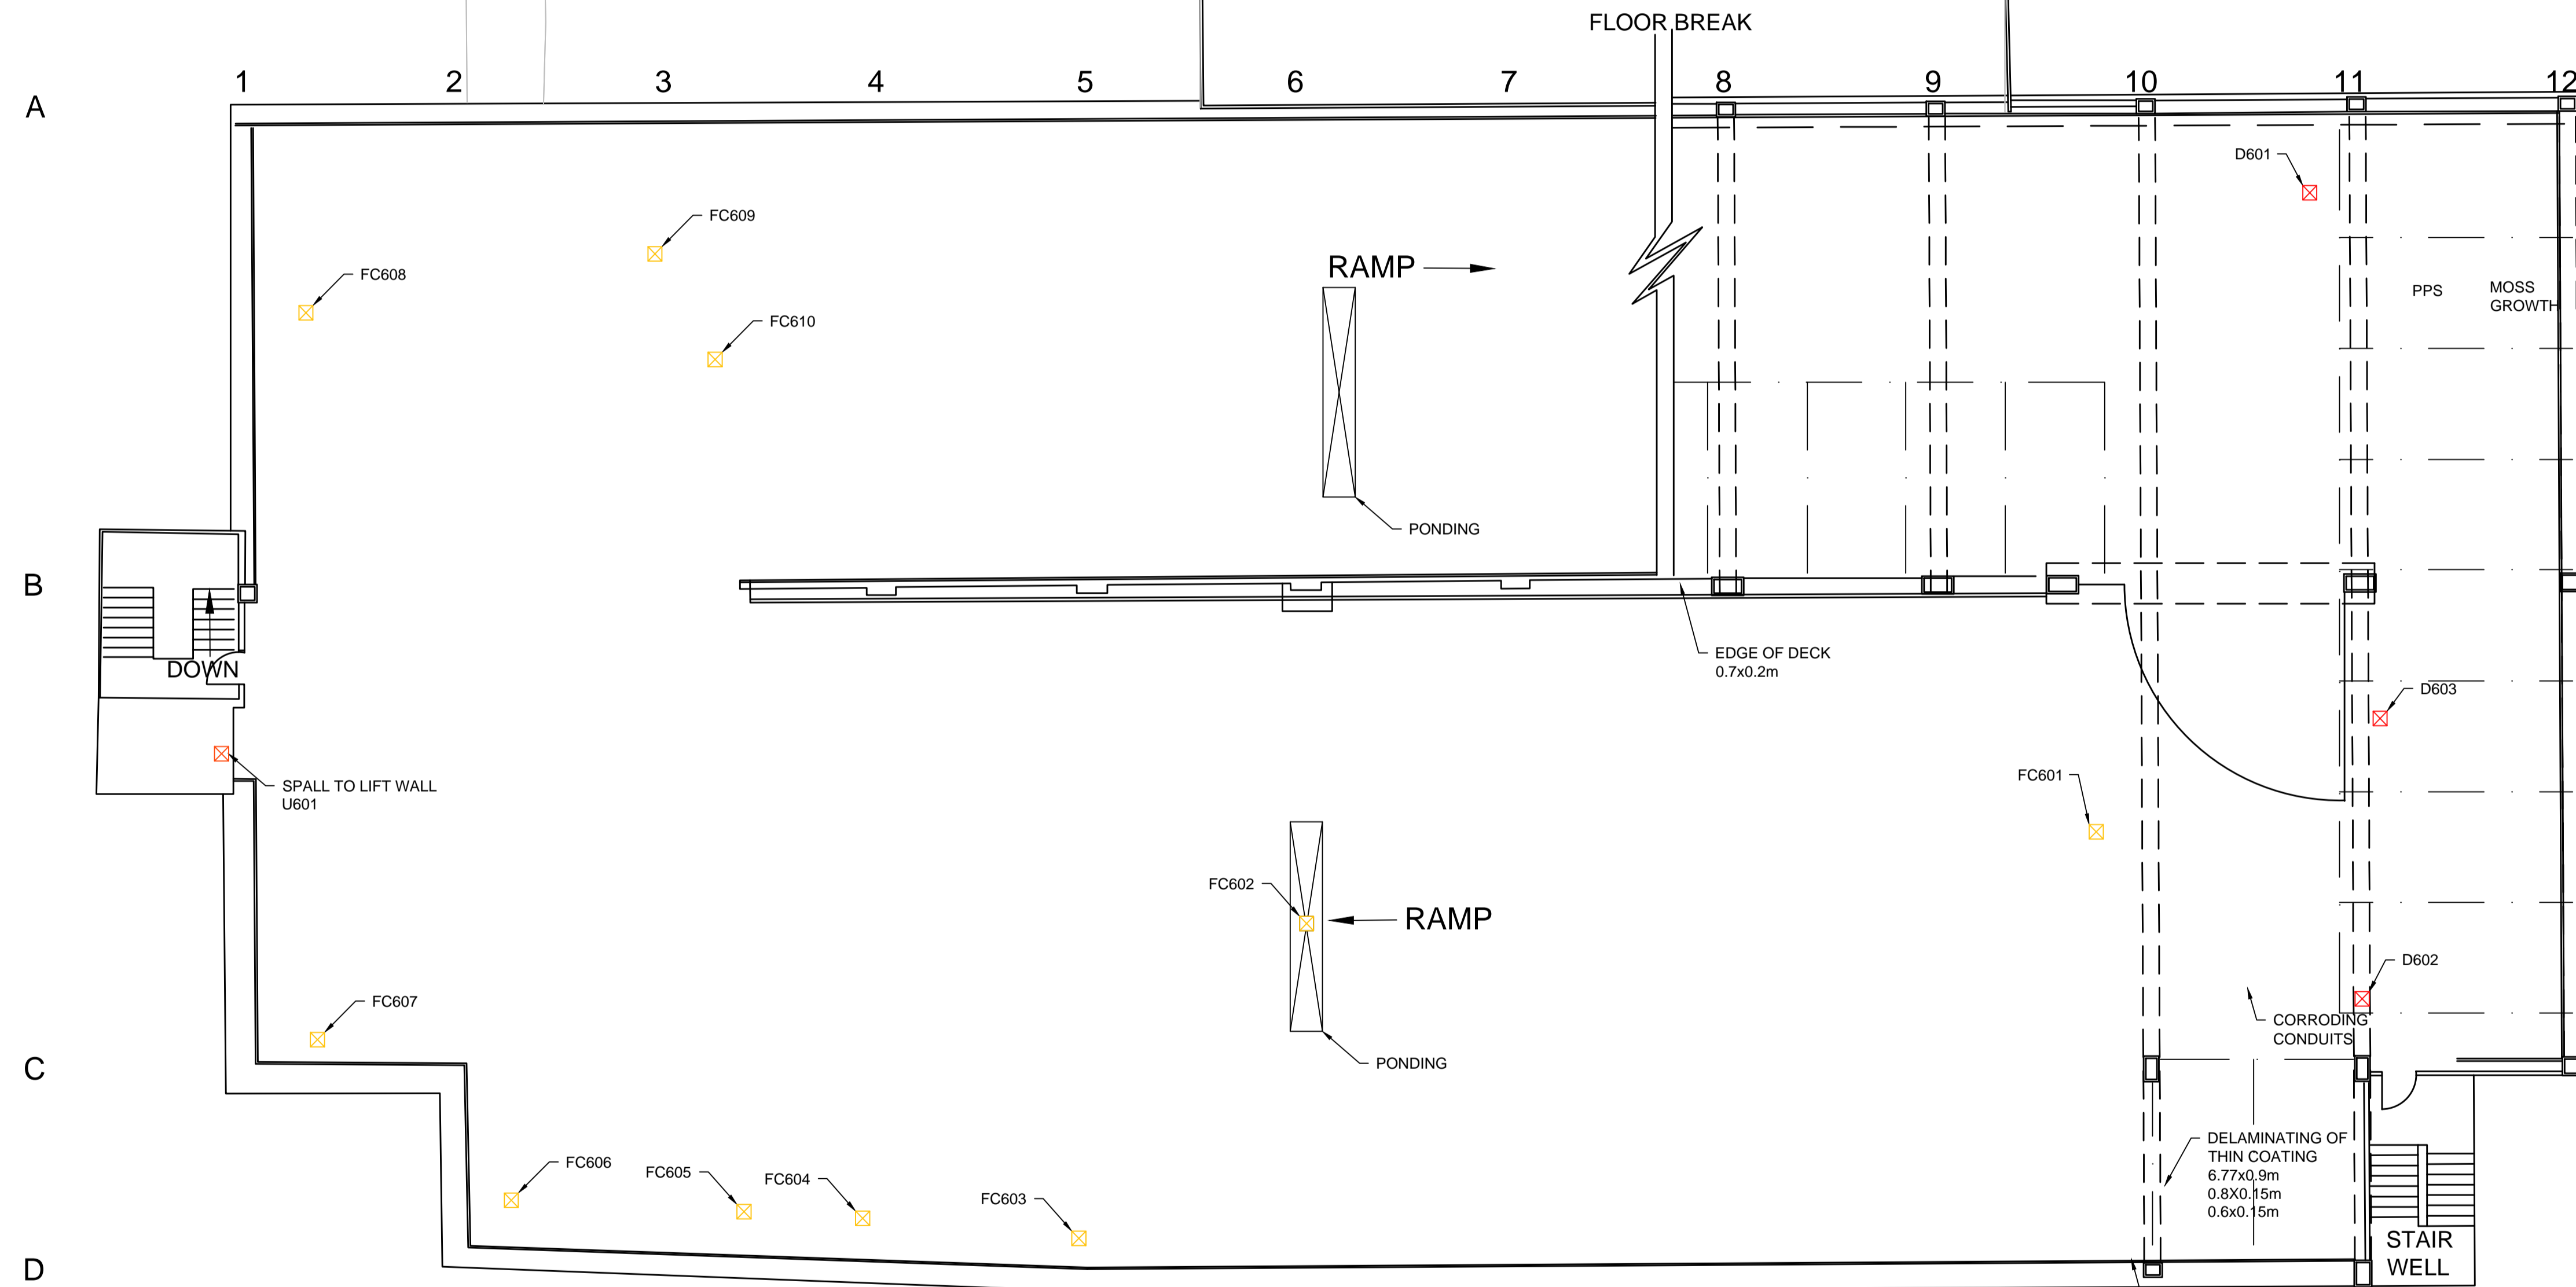

CHATTERTON SQUARE

LEVEL 6 FLOOR PLAN
NOT TO SCALE

This map is reproduced from Ordnance Survey® material by Halcrow on behalf of Bristol City Council with the permission of the Controller of Her Majesty's Stationery Office. © Crown copyright. Unauthorised reproduction infringes Crown copyright and may lead to prosecution or civil proceedings. Licence Number :100023406

Rev	By	Chkd	Apprvd	Date	Description
A	FG	AP	RB	13/02/2018	FIRST ISSUE



CH2M HILL
1 The Square Temple Quay Bristol BS1 6DG
Tel +44 (0)117 910 2580 Fax +44 (0)117 910 2581



Project
TEMPLE GATE MULTI STOREY CAR PARK STUDY

Drawing
TEMPLE GATE LEVEL 6 DEFECTS


Drawn by: FG Date: 13/02/2018

Checked by: AP Date: 13/02/2018


Approved by: RB Date: 13/02/2018

Drawing No. **673846-TG-114** Revision **A**

Drawing Scale: NTS

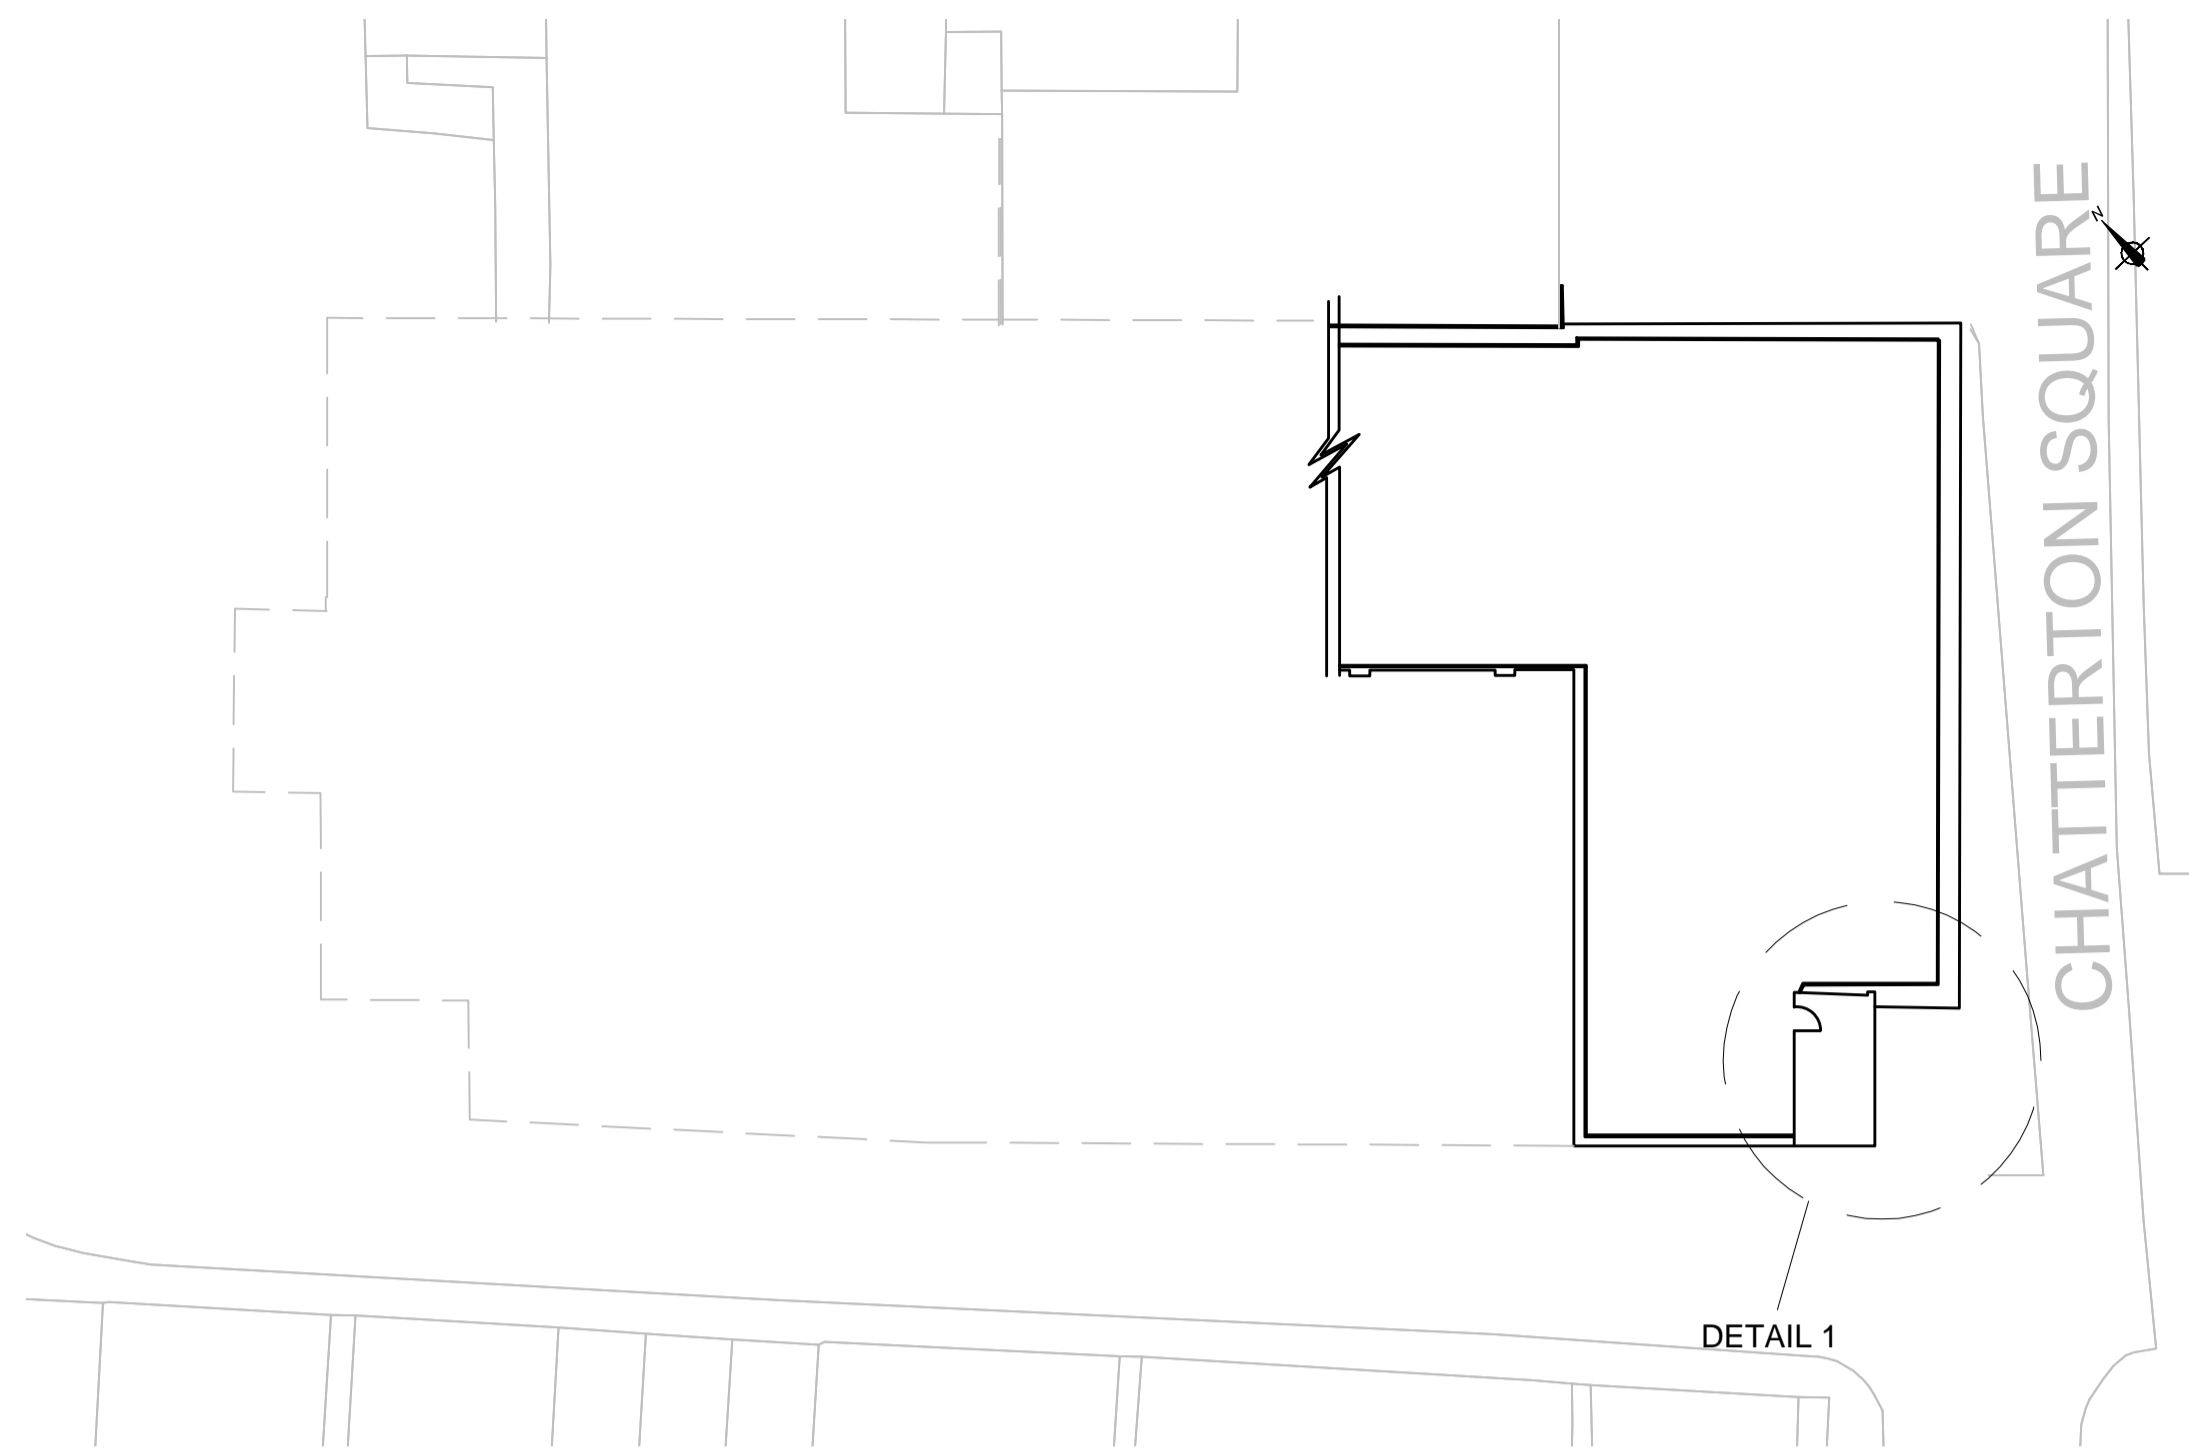

LEVEL 7 FLOOR PLAN
NOT TO SCALE

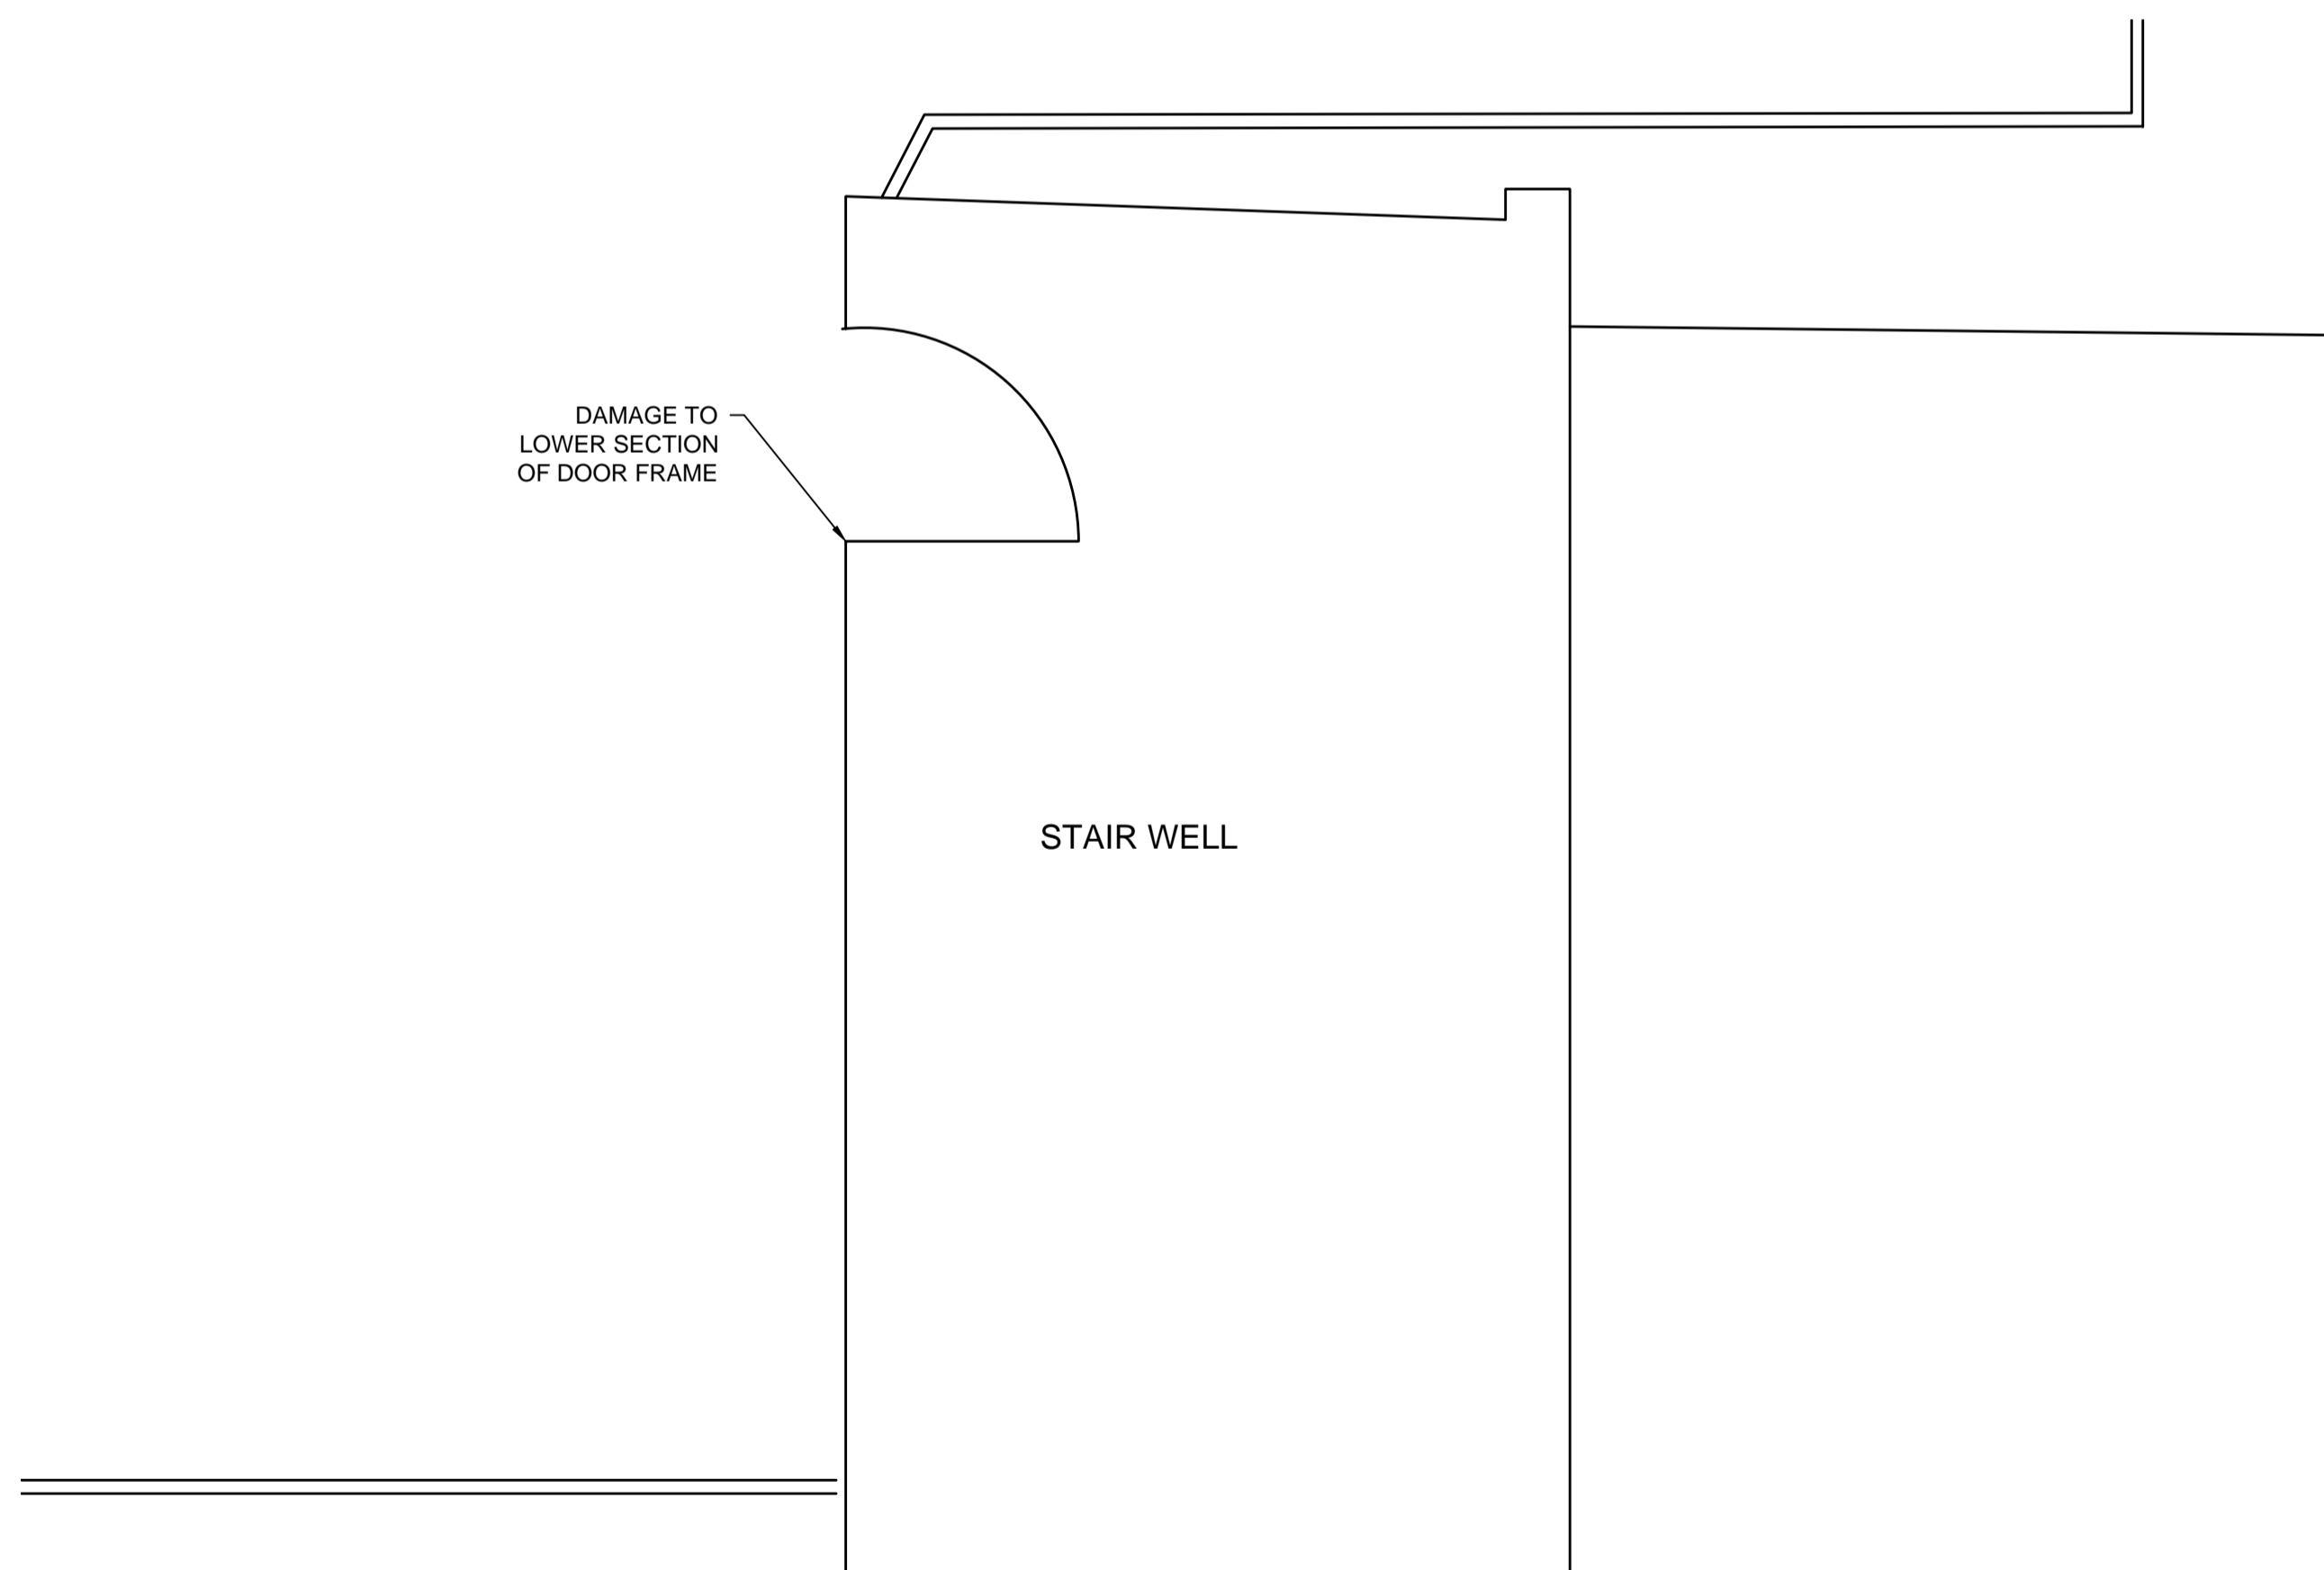

DETAIL 1
NOT TO SCALE

This map is reproduced from Ordnance Survey® material by Halcrow on behalf of Bristol City Council with the permission of the Controller of Her Majesty's Stationery Office. © Crown copyright. Unauthorised reproduction infringes Crown copyright and may lead to prosecution or civil proceedings. Licence Number : 100023406

Rev	By	Chkd	Apprvd	Date	Description
A	FG	AP	RB	13/02/2018	FIRST ISSUE

Client



CH2M HILL
1 The Square Temple Quay Bristol BS1 6DG
Tel +44 (0)117 910 2580 Fax +44 (0)117 910 2581



Project

**TEMPLE GATE MULTI STOREY
CAR PARK STUDY**

Drawing

**TEMPLE GATE
LEVEL 7
STAIRCASE DEFECTS**

Drawn by: FG Date: 13/02/2018

Checked by: AP Date: 13/02/2018

Approved by: RB Date: 13/02/2018

Drawing No. Revision

673846-TG-115

A

Drawing Scale: NTS

REPAIR REFERENCE	LENGTH (mm)	WIDTH (mm)
FC701	100	100
FC702	100	100
FC703	300	100
FC704	3700	5100
FC705	10200	6500


REPAIR REFERENCE	HEIGHT (mm)	LENGTH (mm)	WIDTH (mm)
U701	150	100	400

KEY

PPS: PEELING PAINT SOFFIT

☒ UPSTAND DEFECT

☒ FAILED SURFACING

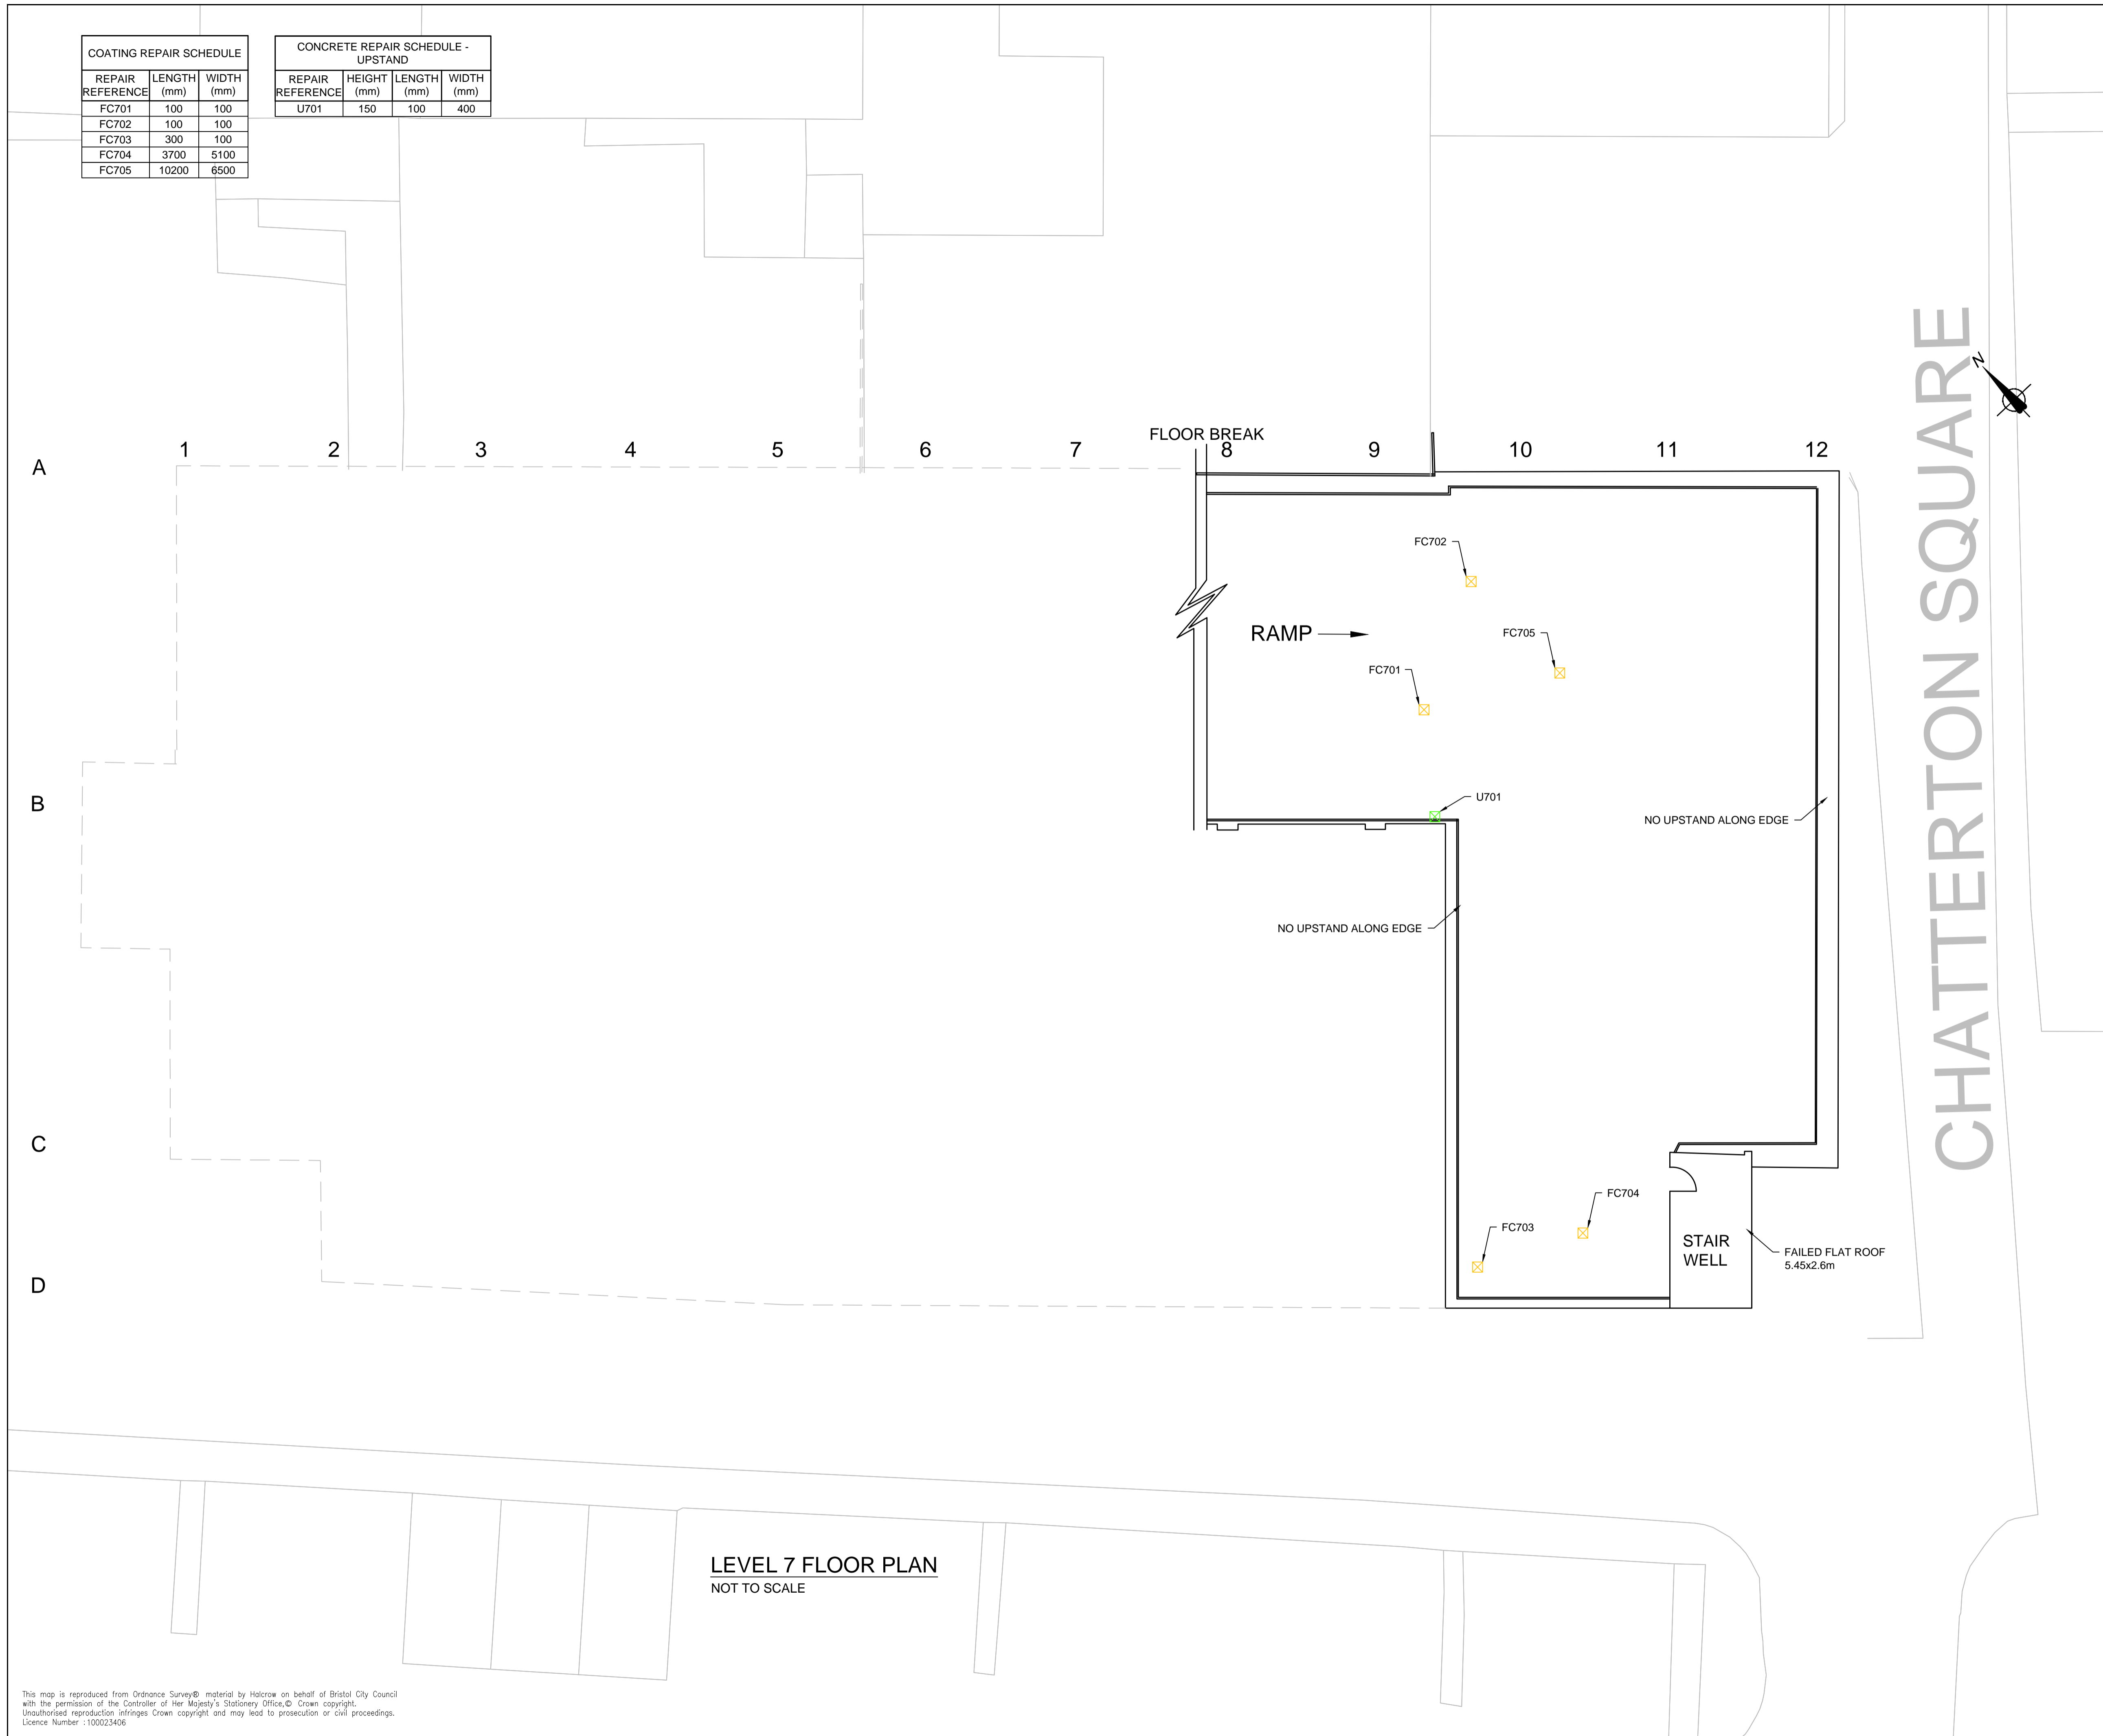

LEVEL 7 FLOOR PLAN
NOT TO SCALE

CHATTERTON SQUARE

Rev	By	Chkd	Apprvd	Date	DESCRIPTION
A	FG	AP	RB	13/02/2018	FIRST ISSUE



CH2M HILL
1 The Square Temple Quay Bristol BS1 6DG
Tel +44 (0)117 910 2580 Fax +44 (0)117 910 2581



Project
**TEMPLE GATE MULTI STOREY
CAR PARK STUDY**

Drawing
**TEMPLE GATE
LEVEL 7
DEFECTS**

Drawn by: FG Date: 13/02/2018

Checked by: AP Date: 13/02/2018

Approved by: RB Date: 13/02/2018


Drawing No.	Revision
673846-TG-116	A

Drawing Scale: NTS


This map is reproduced from Ordnance Survey® material by Halcrow on behalf of Bristol City Council with the permission of the Controller of Her Majesty's Stationery Office. © Crown copyright. Unauthorised reproduction infringes Crown copyright and may lead to prosecution or civil proceedings. Licence Number : 100023406

KEY

☒ ELEVATION DEFECT

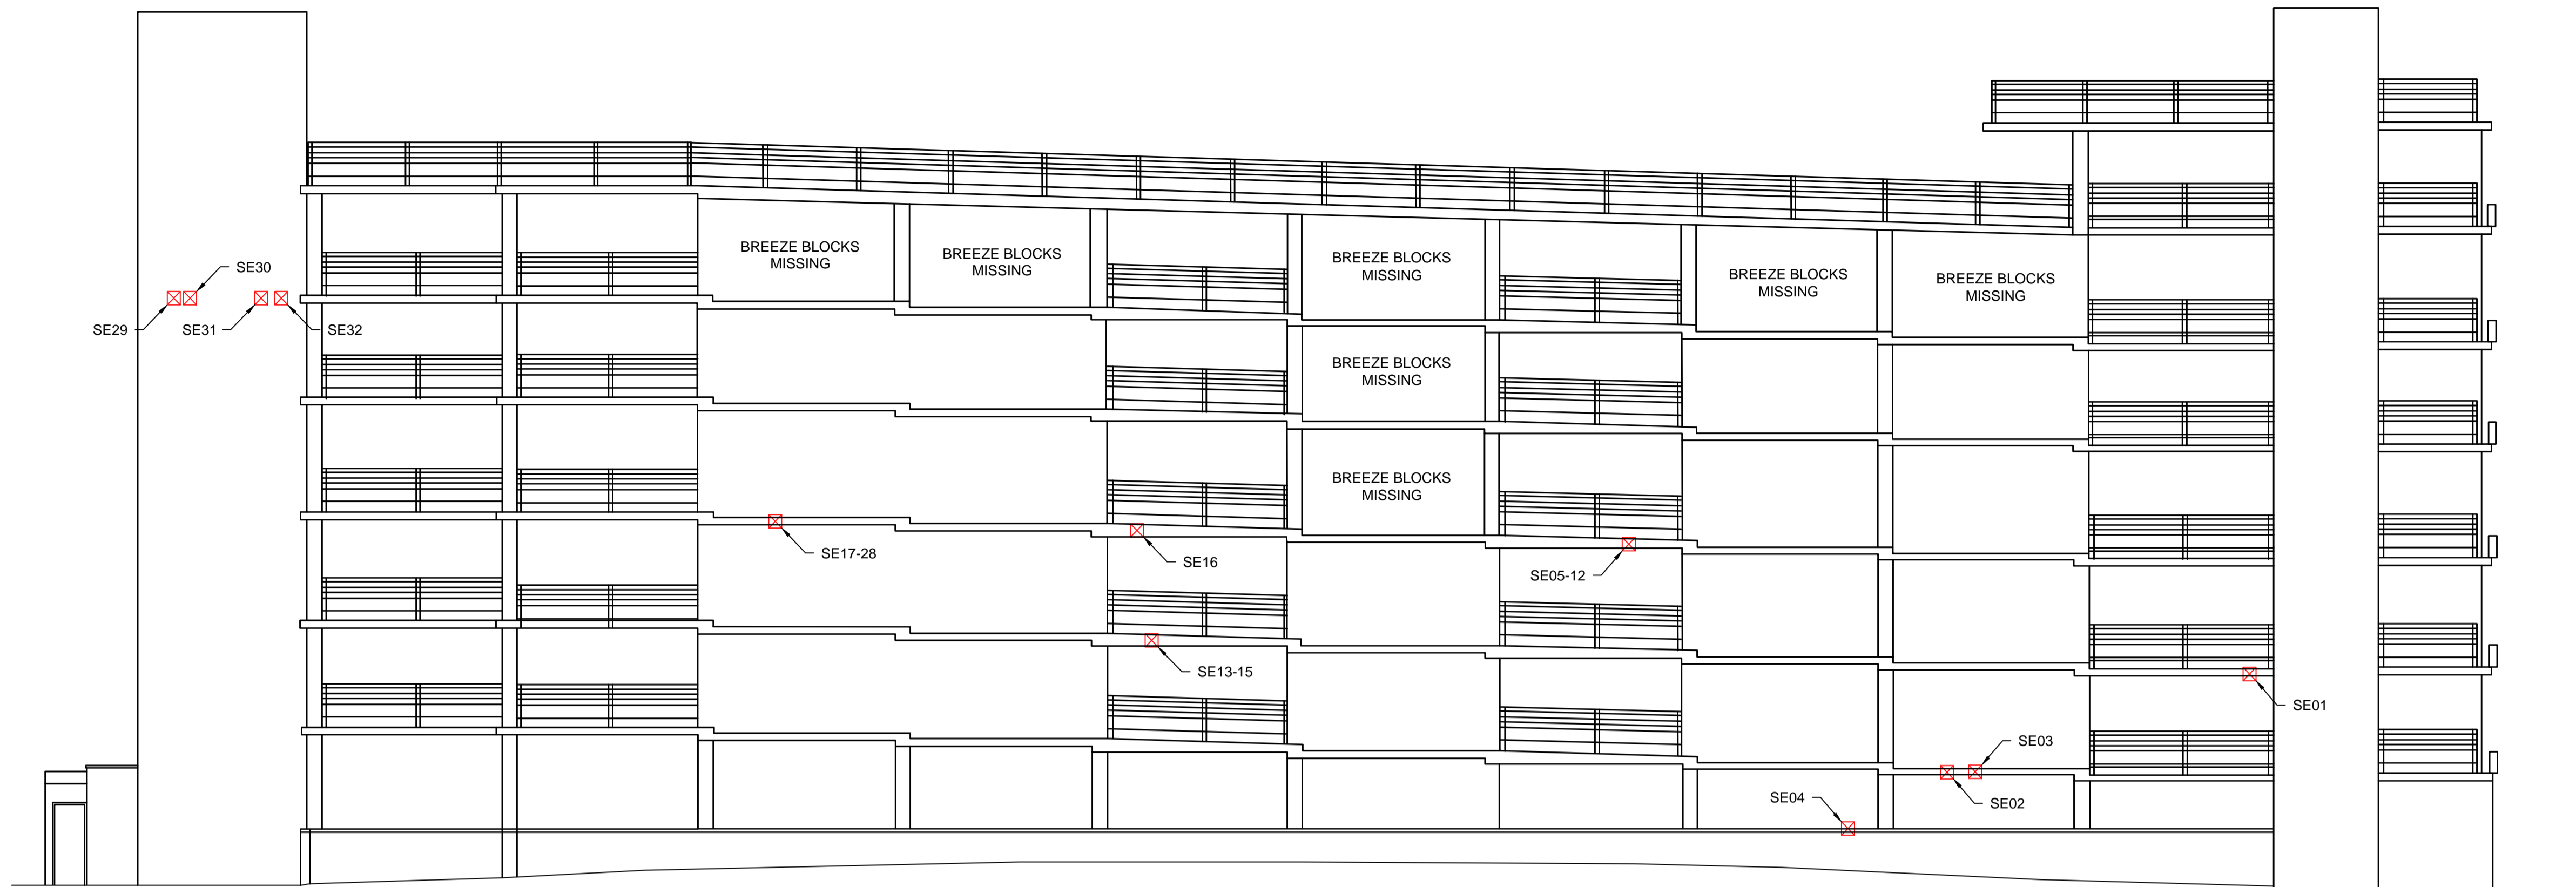

SOUTH ELEVATION
NOT TO SCALE

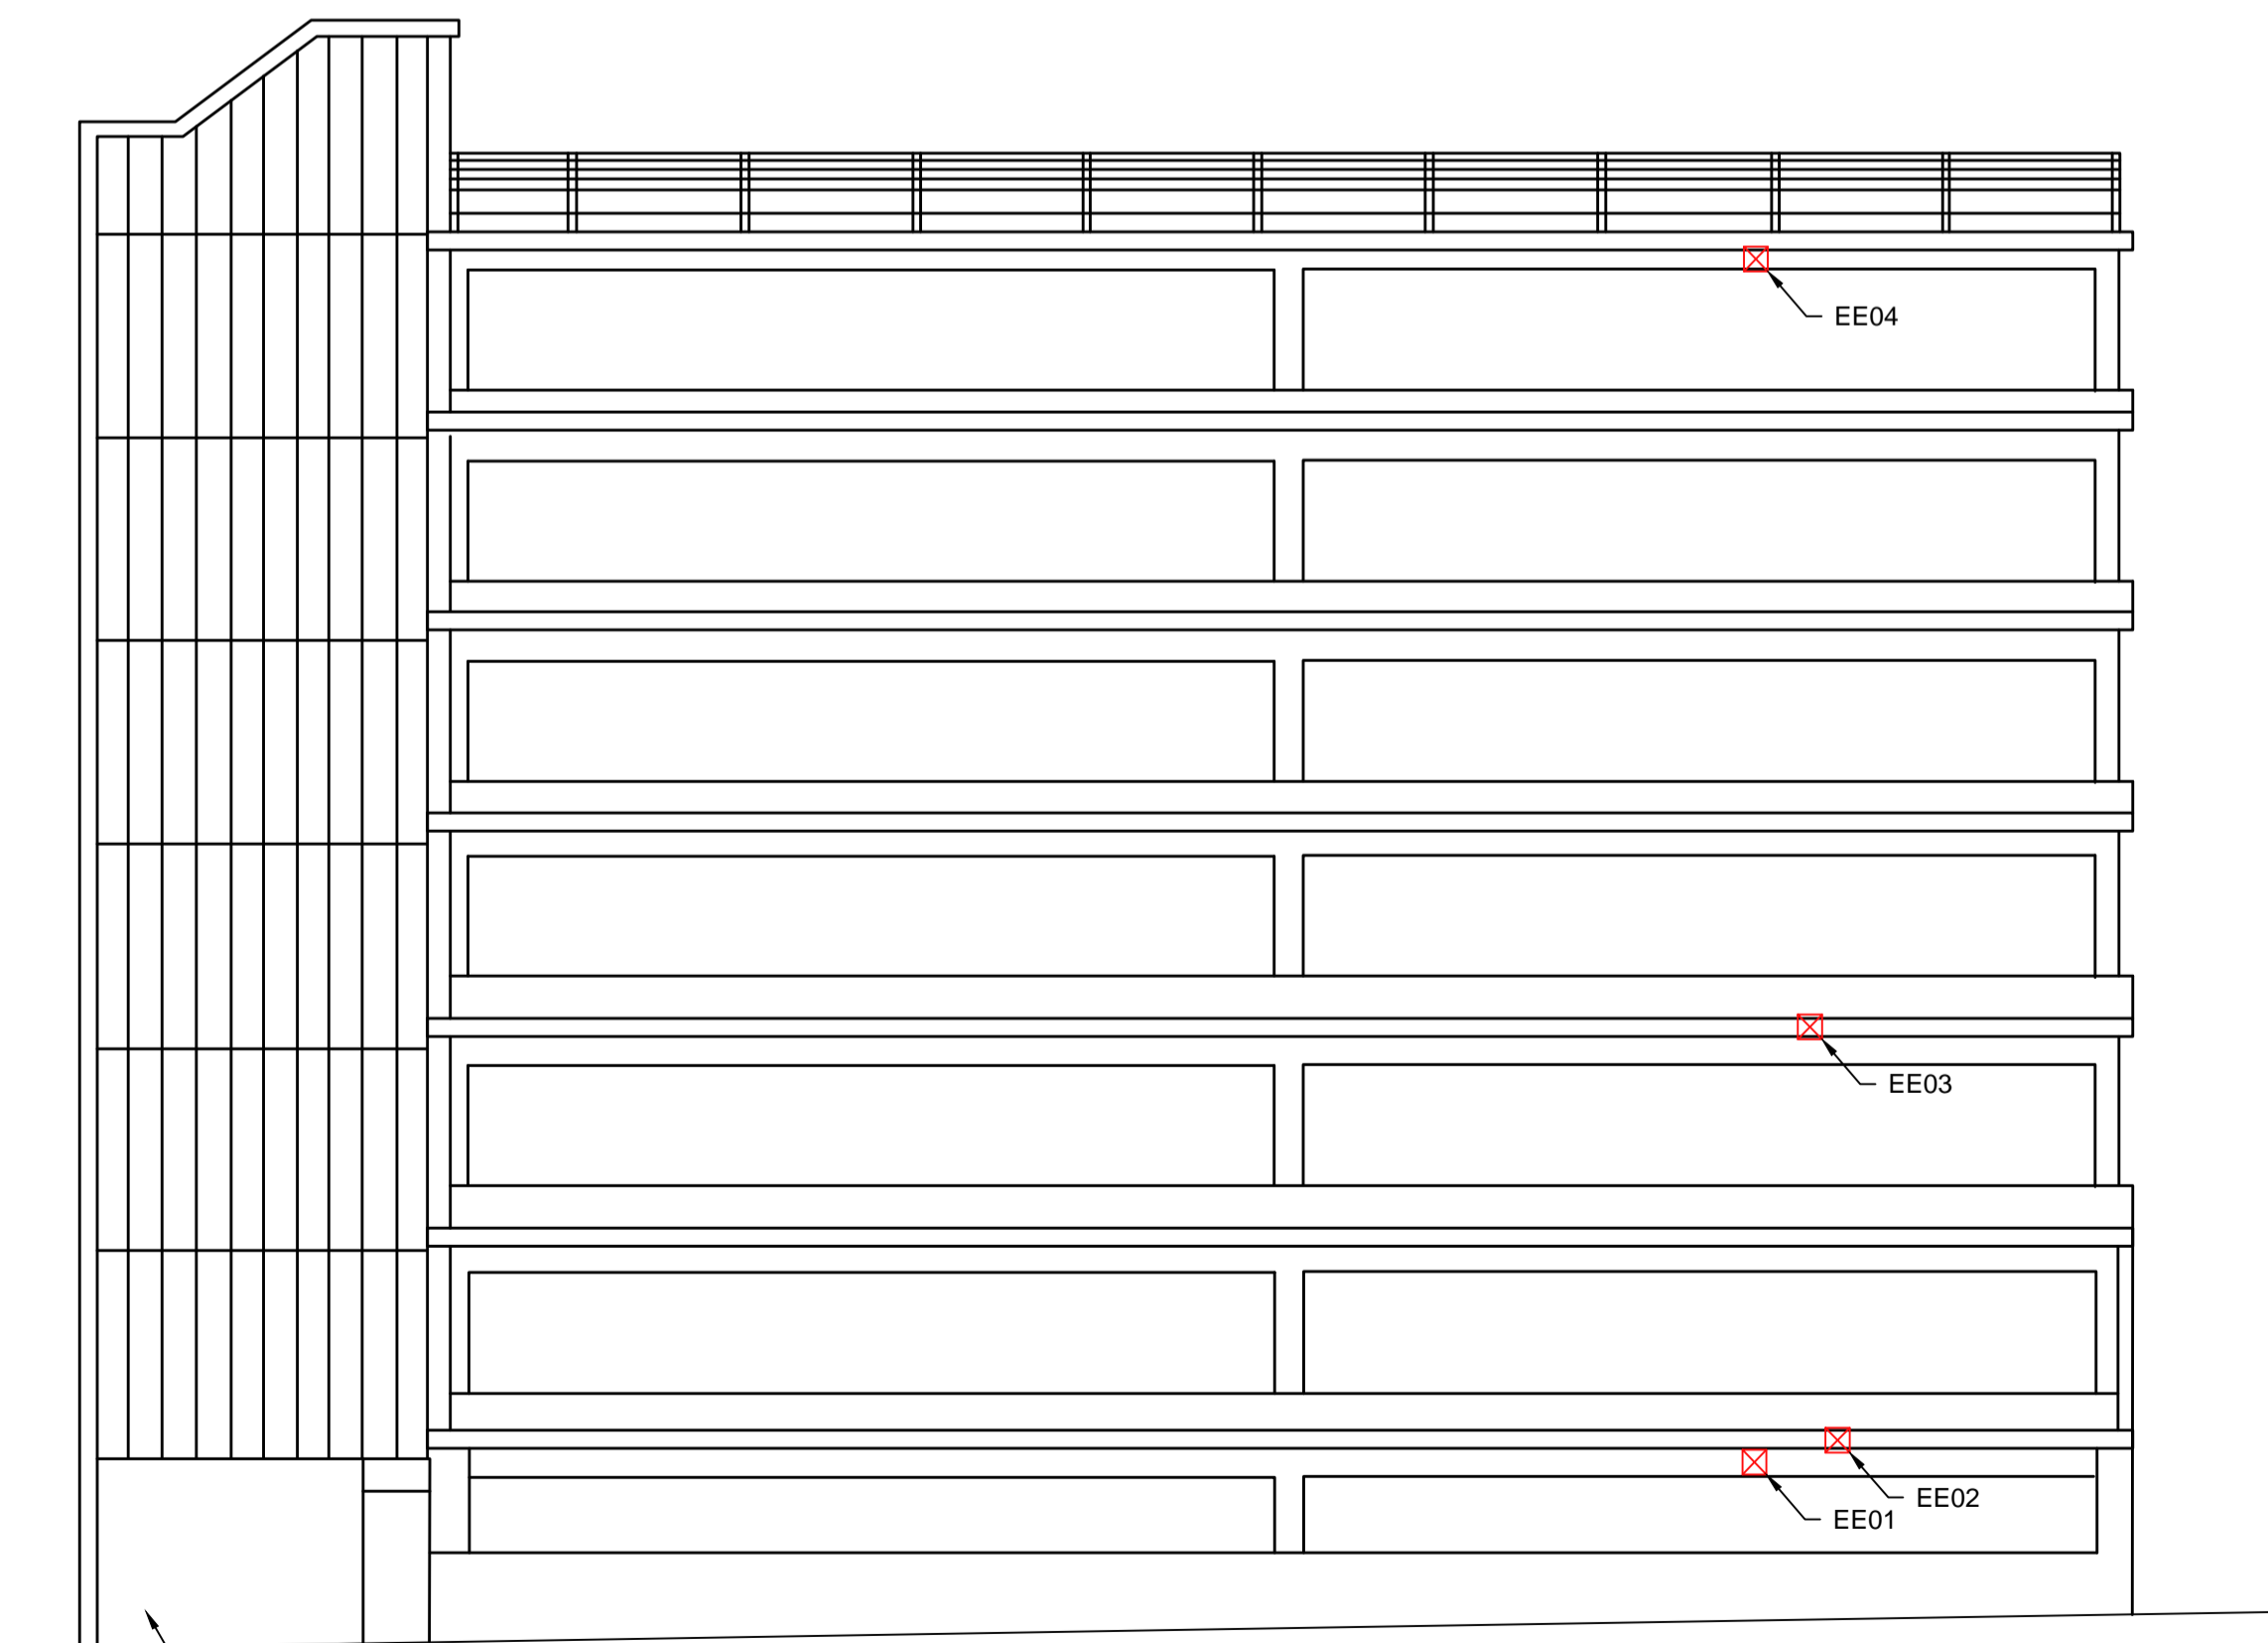

EAST ELEVATION
NOT TO SCALE

CONCRETE REPAIR SCHEDULE - SOUTH ELEVATION

REPAIR REFERENCE	LENGTH (mm)	WIDTH (mm)
SE01	100	100
SE02	100	100
SE03	100	100
SE04	50	350
SE05	100	100
SE06	100	100
SE07	100	100
SE08	100	100
SE09	100	100
SE10	100	100
SE11	100	100
SE12	100	100
SE13	100	100
SE14	100	100
SE15	100	100
SE16	500	300
SE17	100	100
SE18	100	100
SE19	100	100
SE20	100	100
SE21	100	100
SE22	100	100
SE23	100	100
SE24	100	100
SE25	100	100
SE26	100	100
SE27	100	100
SE28	100	100
SE29	100	100
SE30	100	100
SE31	100	100
SE32	200	200

CONCRETE REPAIR SCHEDULE - EAST ELEVATION

REPAIR REFERENCE	LENGTH (mm)	WIDTH (mm)
EE01	1200	400
EE02	?	?
EE03	200	200
EE04	200	200

Rev	By	Chkd	Apprvd	Date	Description
A	FG	AP	RB	13/02/2018	FIRST ISSUE



CH2M HILL
1 The Square Temple Quay Bristol BS1 6DG
Tel +44 (0)117 910 2580 Fax +44 (0)117 910 2581



Project
TEMPLE GATE MULTI STOREY CAR PARK STUDY

Drawing
TEMPLE GATE SOUTH AND EAST ELEVATIONS

Drawn by: FG	Date: 13/02/2018
Checked by: AP	Date: 13/02/2018
Approved by: RB	Date: 13/02/2018


Drawing No.	Revision
673846-TG-117	A

Drawing Scale: NTS


This map is reproduced from Ordnance Survey material by Helcrow on behalf of Bristol City Council with the permission of the Controller of Her Majesty's Stationery Office. Crown copyright. Unauthorised reproduction infringes Crown copyright and may lead to prosecution or civil proceedings. Licence Number: 100023406

KEY


☒ ELEVATION DEFECT

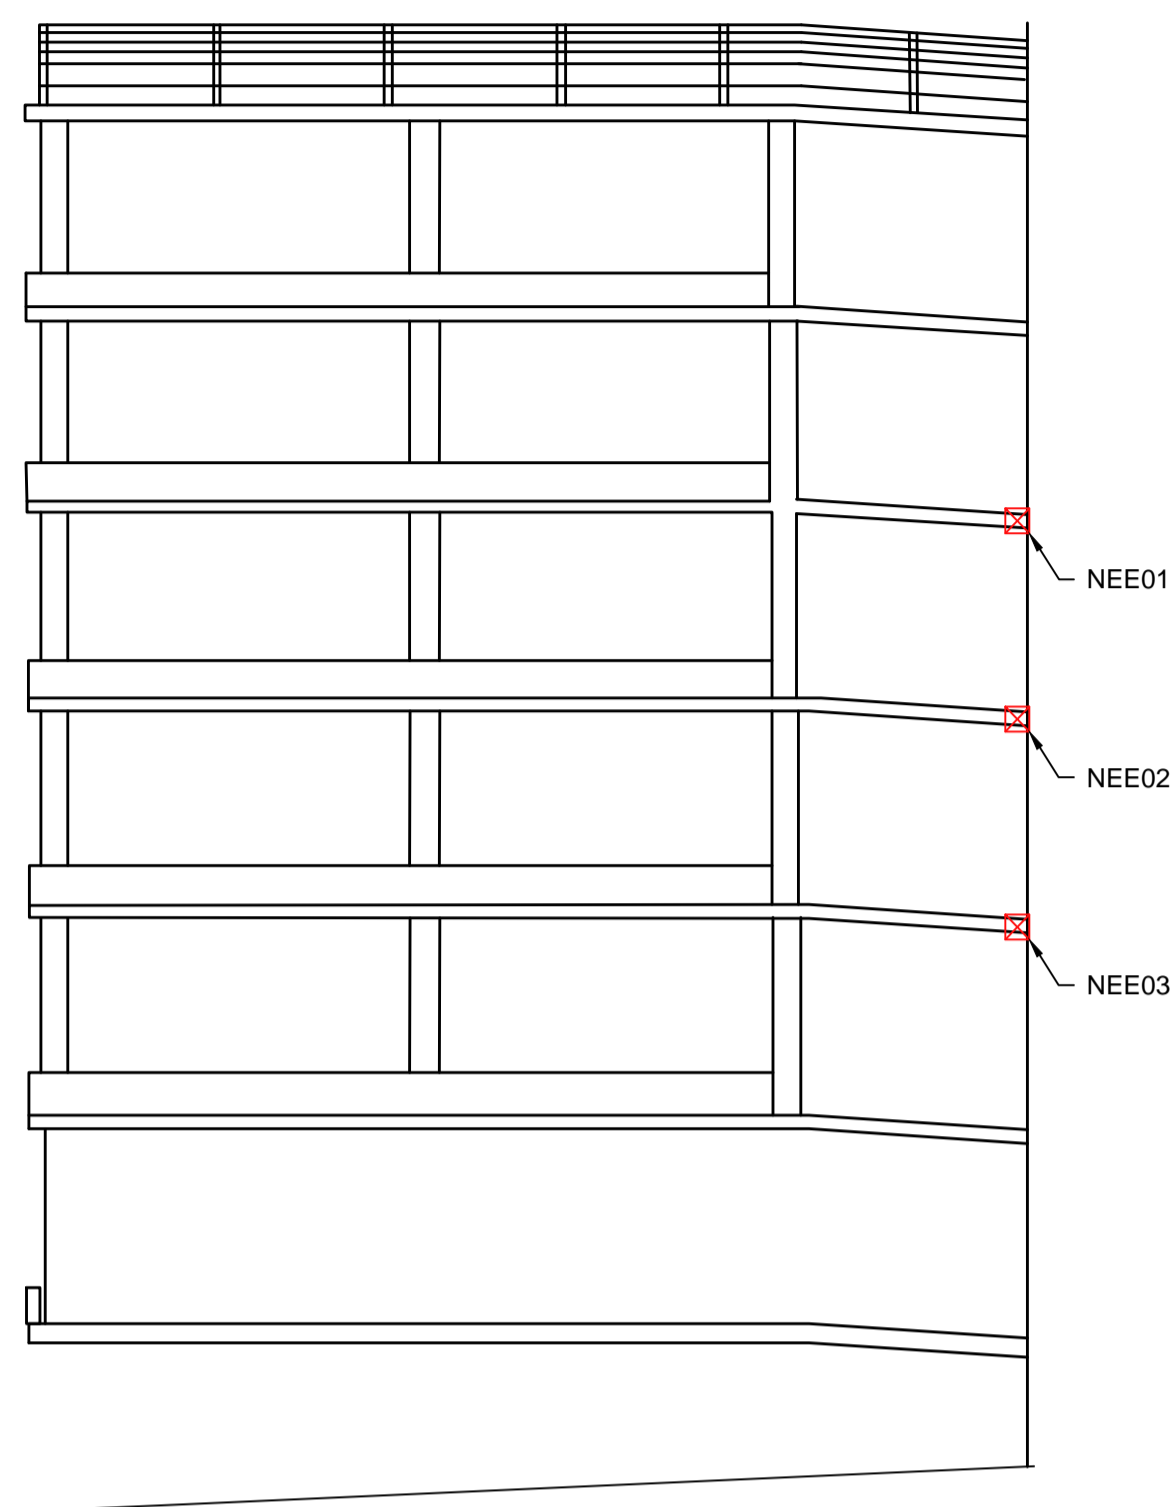

NORTH EAST ELEVATION
NOT TO SCALE

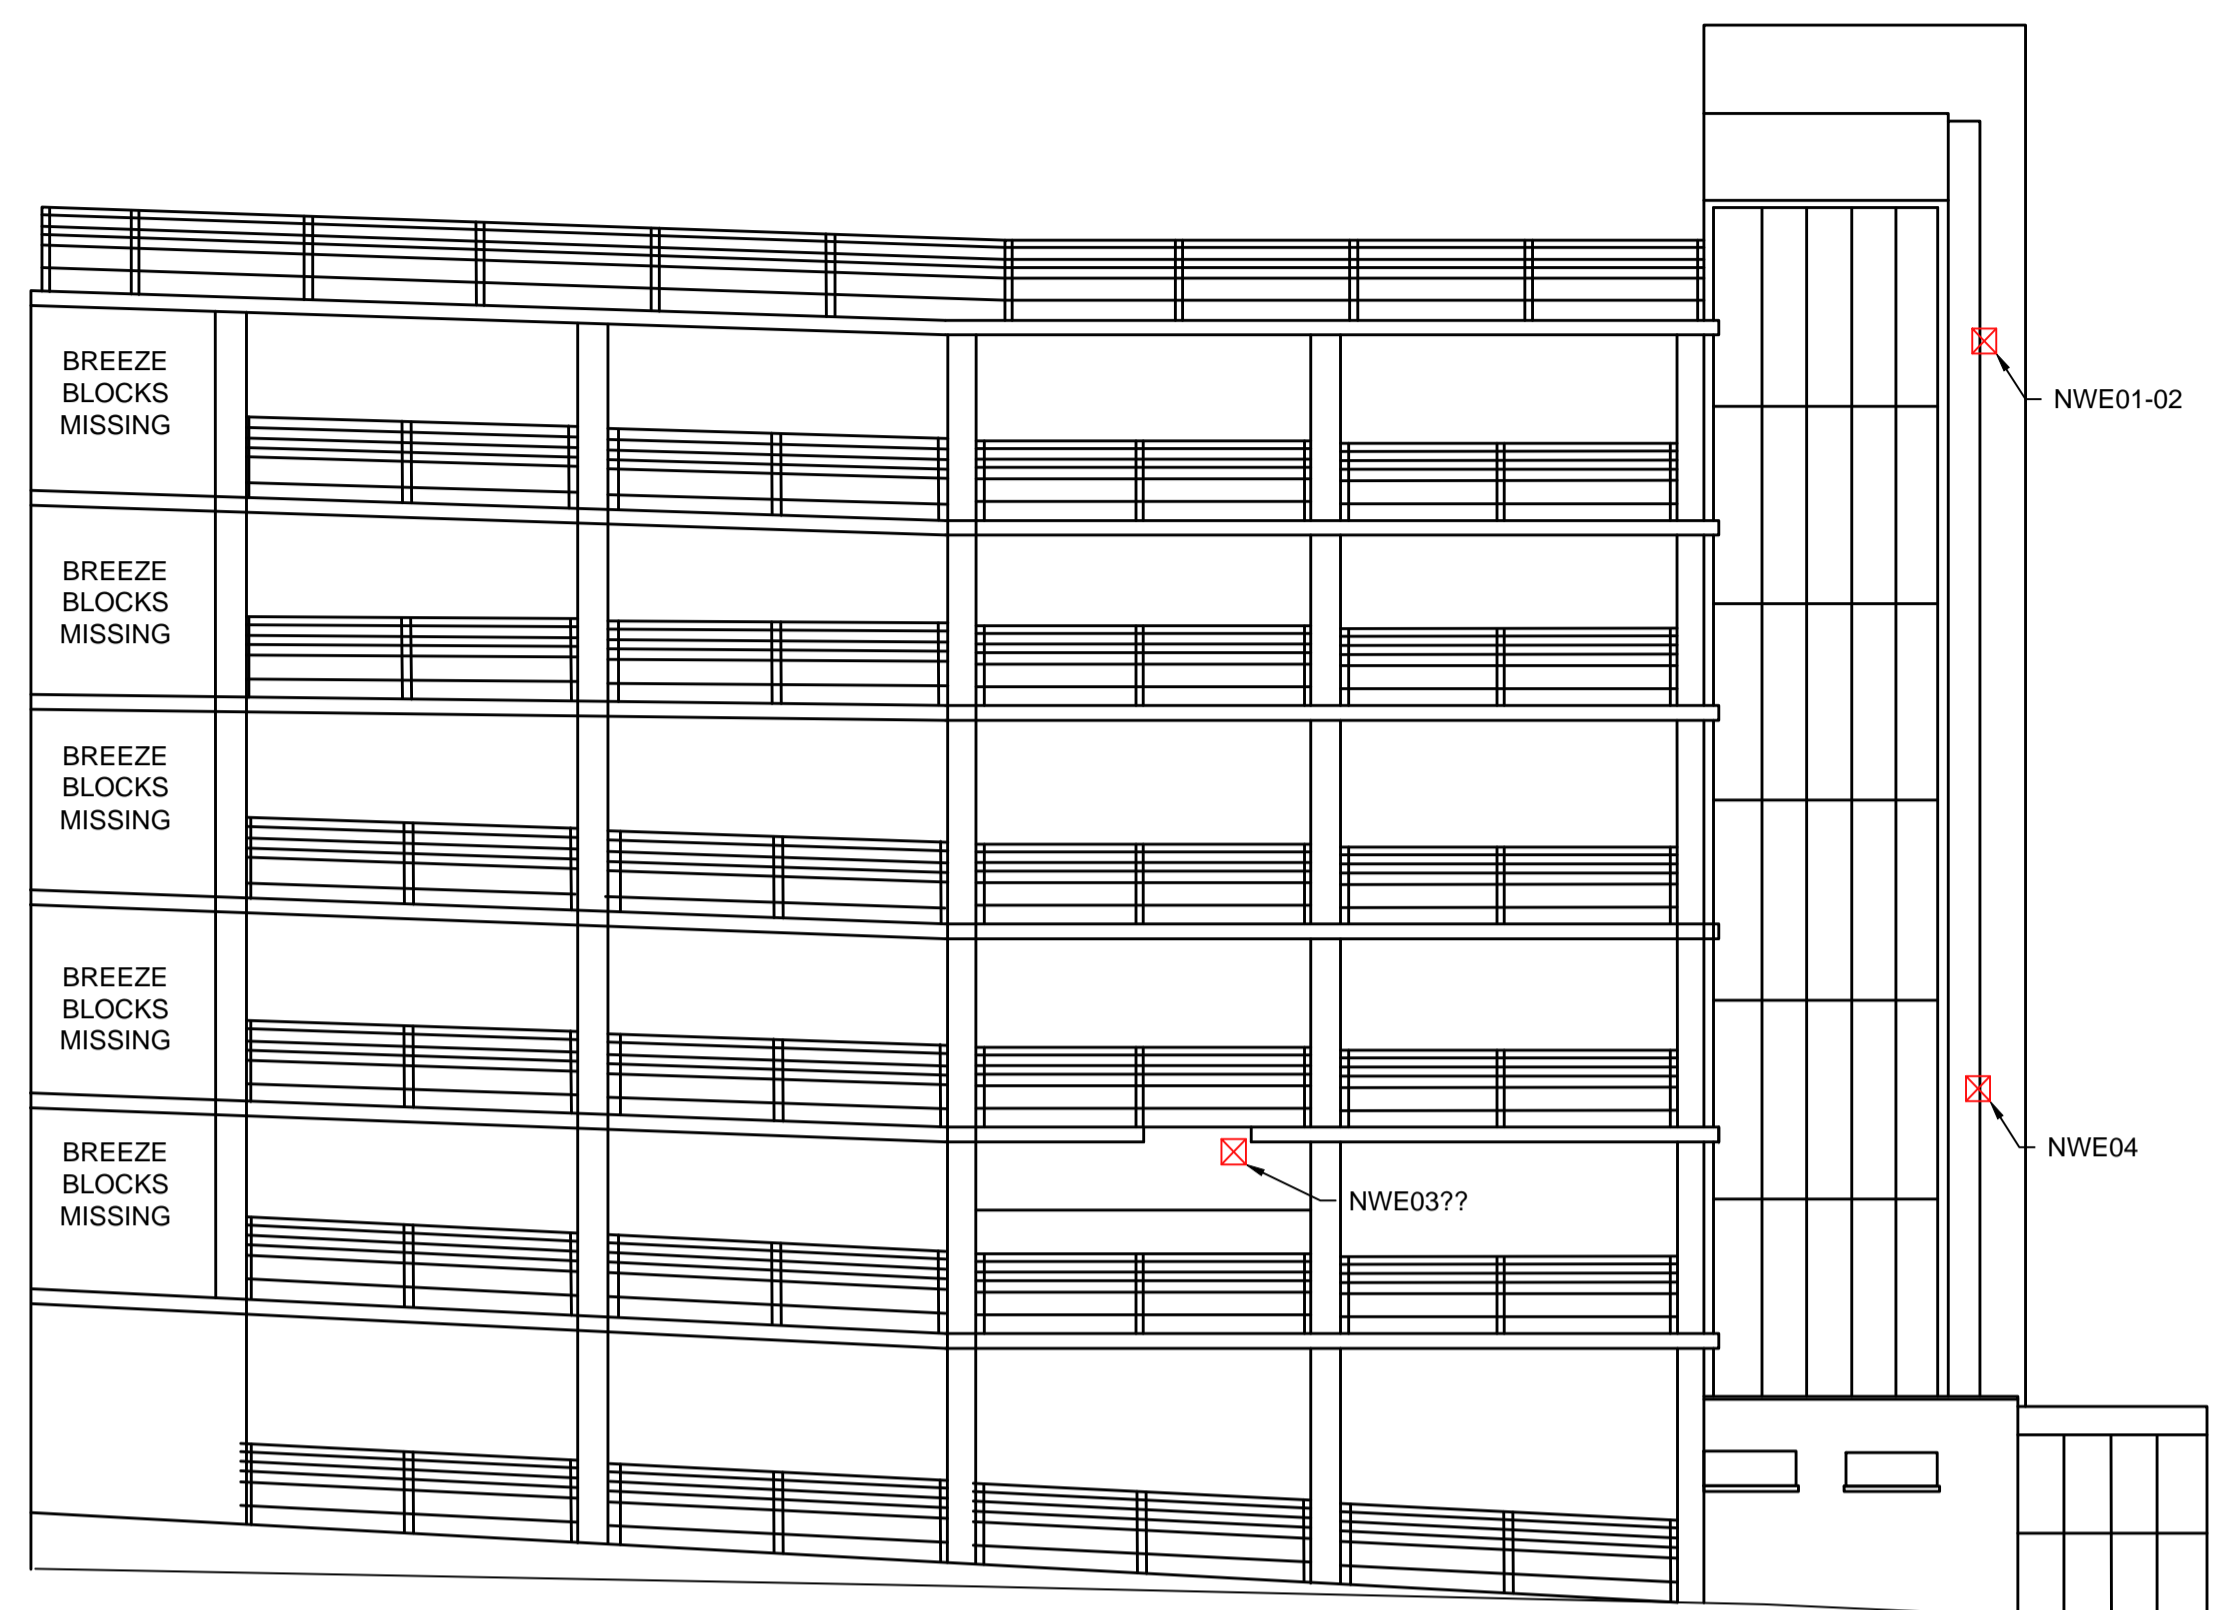

NORTH WEST ELEVATION
NOT TO SCALE

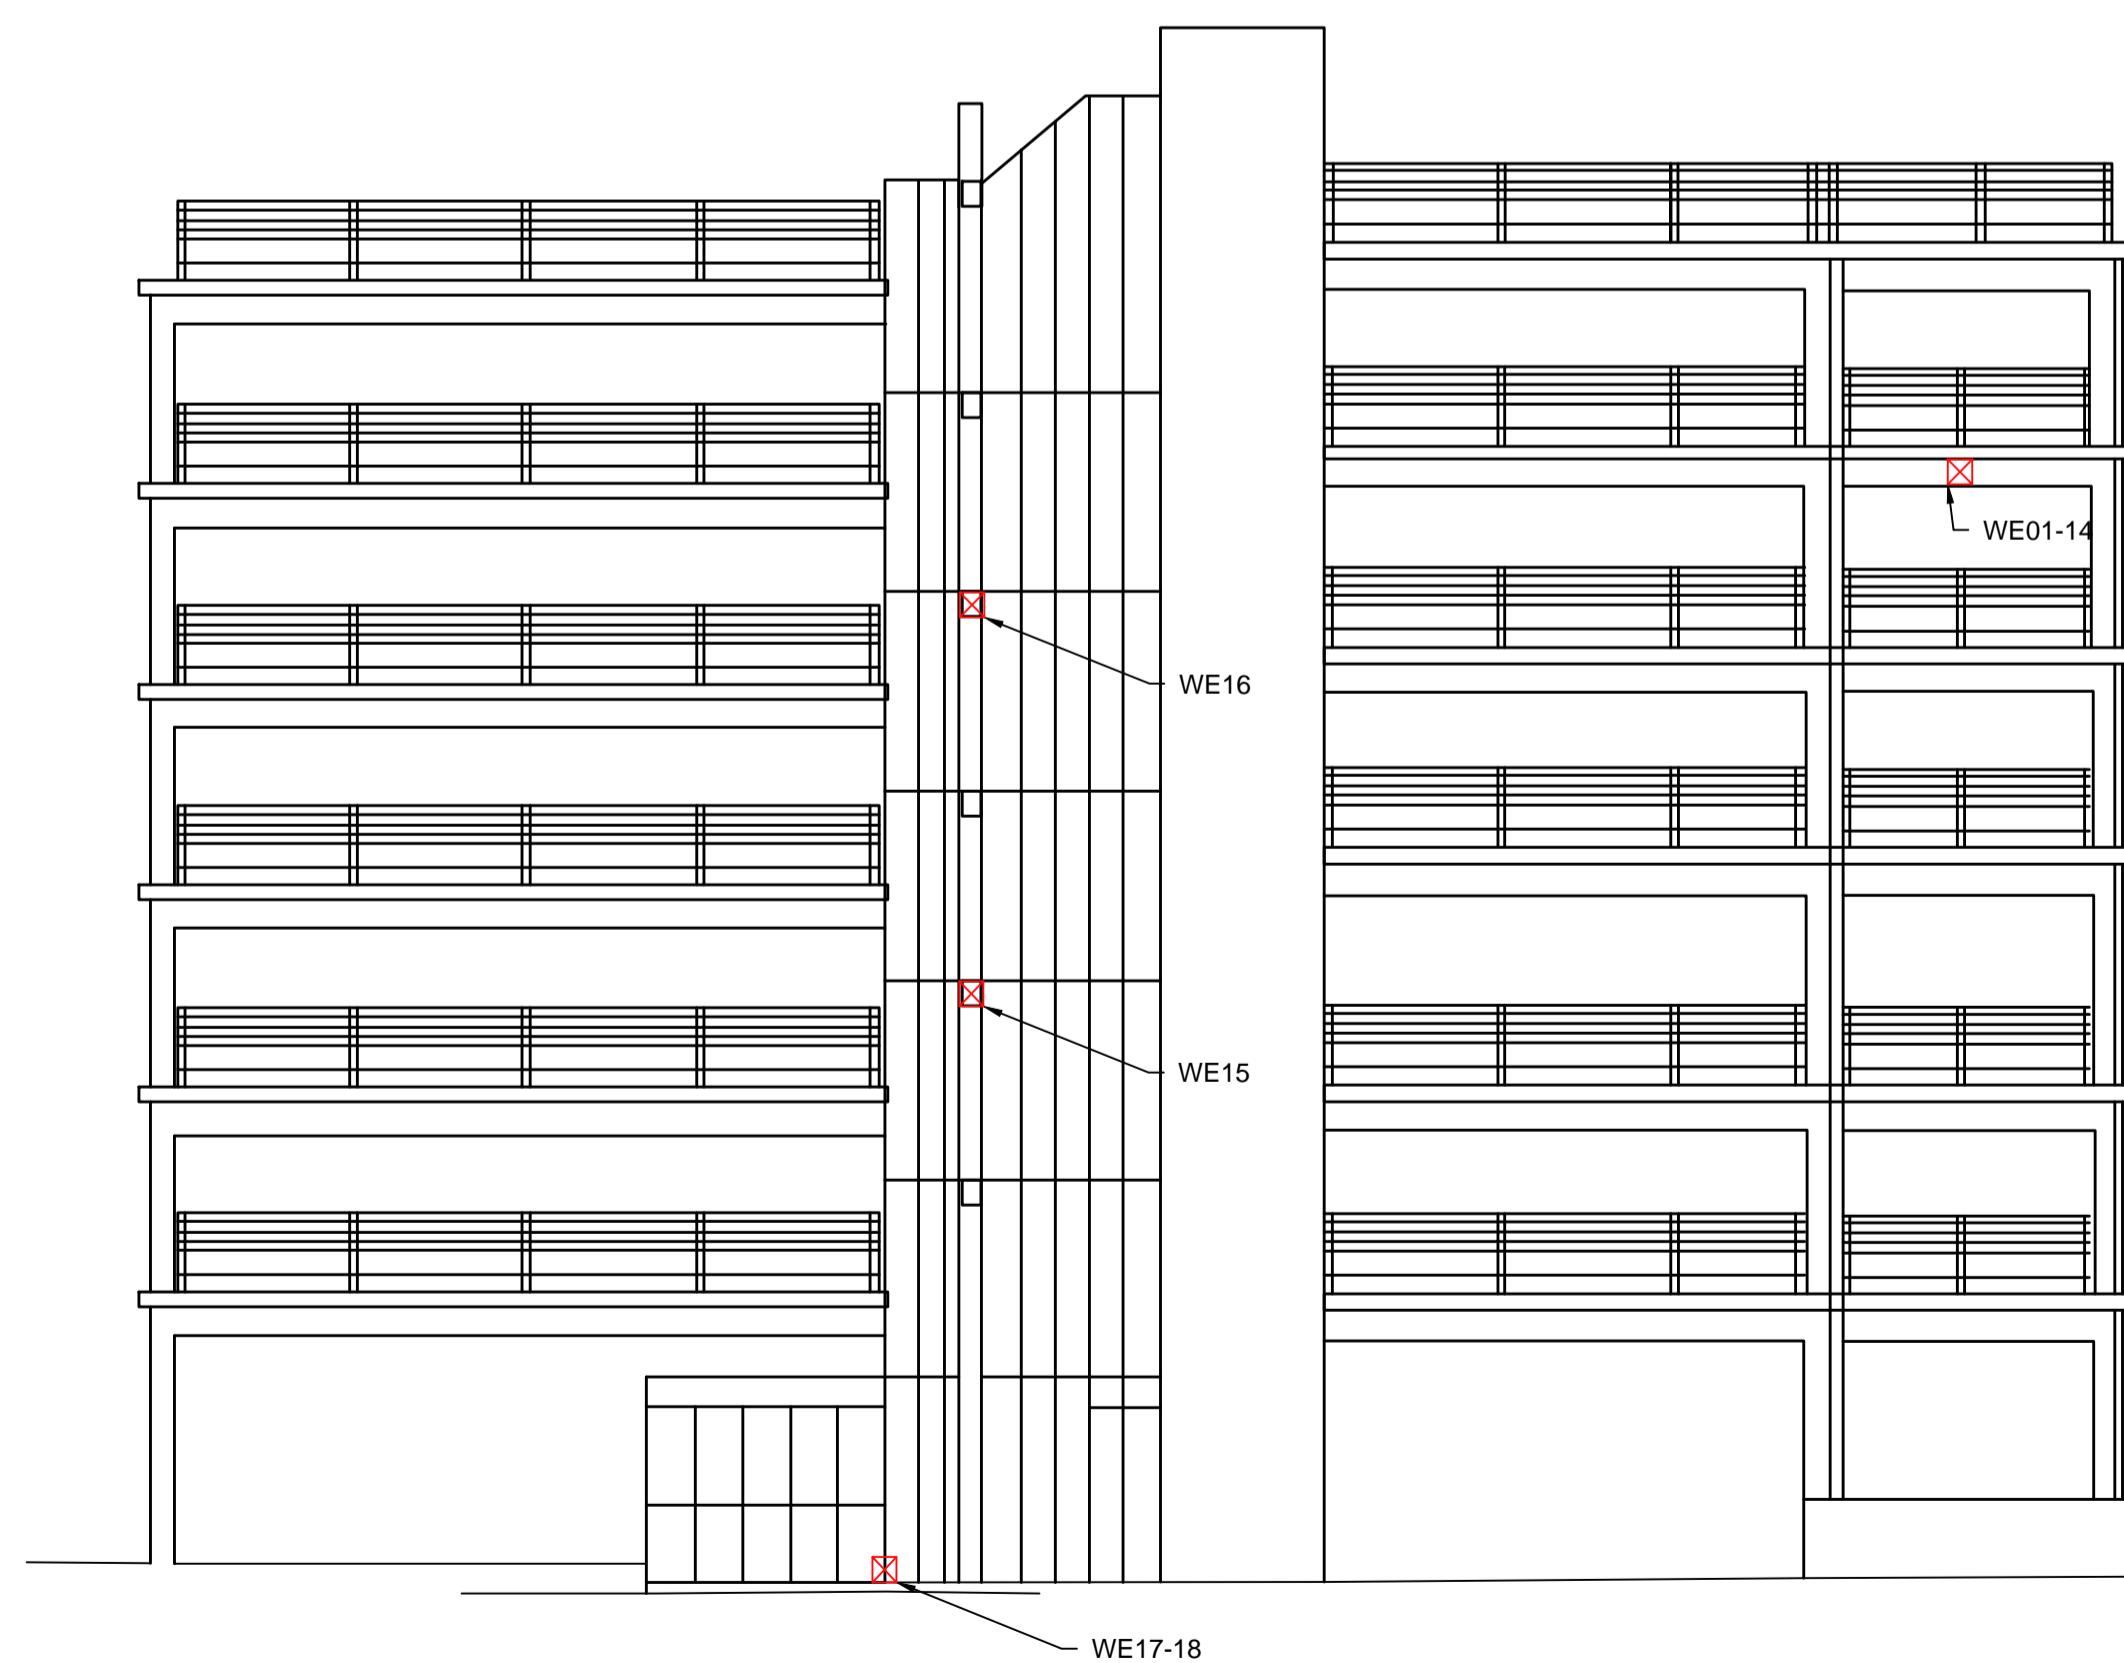

WEST ELEVATION
NOT TO SCALE

CONCRETE REPAIR SCHEDULE - WEST ELEVATION

REPAIR REFERENCE	LENGTH (mm)	WIDTH (mm)
WE01	100	100
WE02	100	100
WE03	100	100
WE04	100	100
WE05	100	100
WE06	100	100
WE07	100	100
WE08	100	100
WE09	100	100
WE10	100	100
WE11	100	100
WE12	100	100
WE13	100	100
WE14	100	100
WE15	200	100
WE16	300	200
WE17	200	200
WE18	450	200

CONCRETE REPAIR SCHEDULE - NORTH WEST ELEVATION

REPAIR REFERENCE	LENGTH (mm)	WIDTH (mm)
NWE01	500	400
NWE02	200	200
NWE03	100	100
NWE04	300	300


CONCRETE REPAIR SCHEDULE - NORTH EAST ELEVATION

REPAIR REFERENCE	LENGTH (mm)	WIDTH (mm)	DEPTH (mm)
NEE01	500	175	150
NEE02	750	175	150
NEE03	1000	175	150

This map is reproduced from Ordnance Survey® material by Halcrow on behalf of Bristol City Council with the permission of the Controller of Her Majesty's Stationery Office. Crown copyright. Unauthorised reproduction infringes Crown copyright and may lead to prosecution or civil proceedings. Licence Number : 100023406

Rev	By	Chkd	Apprvd	Date	Description
A	FG	AP	RB	13/02/2018	FIRST ISSUE

Client

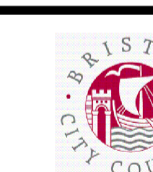

CH2M HILL
1 The Square Temple Quay Bristol BS1 6DG
Tel +44 (0)117 910 2580 Fax +44 (0)117 910 2581



Project

TEMPLE GATE MULTI STOREY
CAR PARK STUDY

Drawing

TEMPLE GATE
NORTH (EAST & WEST) AND WEST
ELEVATIONS

Drawn by: FG Date: 13/02/2018

Checked by: AP Date: 13/02/2018

Approved by: RB Date: 13/02/2018

Drawing No. Revision

673846-TG-118

A

Drawing Scale: NTS

Appendix B – Test certificates



E.D.S
Marine & Civil Engineering Contractors
Dragon House, 17 Sir Alfred Owen Way
Pontygwindy Industrial Estate
Caerphilly CF83 3HU

27 November 2017
EDS/14314/isj
Page 1 of 3

CERTIFICATE of ANALYSIS

A7125

Chloride content of concrete samples

Date received : 22 November 2017
Mass received : 3 to 12 g
Type of sample : concrete dust
Date of analysis : 24 and 27 November 2017
Method of testing : B.S.1881:Part 124:2015.

Sample ref.	Client's ref.	mm	Chloride content	
			% by mass of sample	cement
16900	TA1	5-20	0.10	0.68
16901		20-35	0.11	0.78
16902		35-50	0.05	0.33
16903	TA2	5-20	0.08	0.56
16904		20-35	0.10	0.75
16905		35-50	0.08	0.55
16906	TA3	5-20	0.06	0.42
16907		20-35	0.08	0.56
16908		35-50	0.05	0.35
16909	TA4	5-20	0.08	0.59
16910		20-35	0.16	1.14
16911		35-50	0.13	0.89
16912	TA5	5-20	0.06	0.45
16913		20-35	0.17	1.24
16914		35-50	0.11	0.78
16915	TA6	5-20	0.08	0.60
16916		20-35	0.13	0.92
16917		35-50	0.08	0.54
16918	TA7	5-20	0.05	0.39
16919		20-35	0.06	0.42
16920		35-50	0.04	0.30

Sample ref.	Client's ref.		Chloride content	
		<i>mm</i>	<i>% by mass of</i>	
			sample	cement
16921	TA8	5-20	0.11	0.76
16922		20-35	0.11	0.76
16923		35-50	0.30	2.15
16924	TA9	5-20	0.09	0.62
16925		20-35	0.16	1.13
16926		35-50	0.08	0.55
16927	TA10	5-20	0.30	2.13
16928		20-35	0.43	3.06
16929		35-50	0.30	2.16
16930	TA11	5-20	0.18	1.29
16931		20-35	0.16	1.13
16932		35-50	0.11	0.76
16933	TA12	5-20	0.08	0.58
16934		20-35	0.14	0.96
16935		35-50	0.14	1.02
16936	WE1	5-20	0.02	0.15
16937		20-35	0.01	0.11
16938		35-50	0.13	0.94
16939	WE2	5-20	0.10	0.68
16940		20-35	0.22	1.57
16941		35-50	0.18	1.29
16942	WE3	5-20	0.03	0.20
16943		20-35	0.06	0.43
16944		35-50	0.07	0.50
16945	WE4	5-20	0.04	0.31
16946		20-35	0.16	1.17
16947		35-50	0.16	1.15
16948	WE5	5-20	0.15	1.09
16949		20-35	0.10	0.68
16950		35-50	0.23	1.64
16951	WE6	5-20	0.03	0.19
16952		20-35	0.13	0.91
16953		35-50	0.11	0.78
16954	WE7	5-20	0.15	1.07
16955		20-35	0.19	1.38
16956		35-50	0.37	2.63
16957	WE8	5-20	0.17	1.22
16958		20-35	0.14	1.03
16959		35-50	0.34	2.42

Sample ref.	Client's ref.	mm	Chloride content	
			% by mass of	
			sample	cement
16960	WE9	5-20	0.06	0.45
16961		20-35	0.27	1.95
16962		35-50	0.64	4.60
16963	WE10	5-20	0.01	0.09
16964		20-35	0.02	0.13
16965		35-50	0.06	0.46

Note: 14 % cement content was assumed for the calculations.

End of results



Iren S. Jasko MSc EurChem CSci CChem FRSC
Technical Manager



61209/F
Certificate No 1
Date of Test 14/11/2017

CONCRETE TEST RESULTS
COMPRESSIVE STRENGTH AND DENSITY OF CORES
 BS EN 12504-1:2009, BS EN 12390-3:2009 and BS EN 12390-7:2009

Sandberg Reference	F91942	F91943	F91944
Site Mark/Client Reference	Beam	Deck	Column
Details: - Location - Date of coring	Beam NA	Deck NA	Column NA
Date Received	7/11/2017	7/11/2017	7/11/2017
Presence of abnormalities	None	None	None
Reinforcement, (diameter/distance) ¹ mm	None	None	None
Aggregate, maximum nominal size mm	16	12	14
Age at Test days	NA	NA	NA
Method of end preparation	HAC	HAC	HAC
Surface Moisture Condition at test	Damp	Damp	Damp
Actual Core Lengths			
- Minimum length, as received mm	68	85	80
- Maximum length, as received mm	85	90	85
- Prepared length mm	52	54	53
- Relation to length, as-received mm	20-65	25-70	25-70
Mean Core Diameter (d) ^m mm	44	44	44
Length/Diameter Ratio, λ	1.18	1.23	1.20
Density ² - Saturated condition kg/m ³	2450	2430	2450
Saturation before Test days	7	7	7
Maximum Load at Failure kN	91.5	84.4	96.7
Mode of Failure ⁴	Normal	Normal	Normal
Compressive Strength ³ (Measured Core Strength) MPa (N/mm ²)	60.2	55.5	63.6
Reinforcement Correction ⁵	-	-	-
Compressive Strength³ Corrected In-Situ Strength⁵ MPa (N/mm ²)	64.0	60.1	68.2

- 1 Centre of bar to core end, before and after end preparation (e.g. 20/100/40 = 20mm diameter bar, 100mm from the core end as-received and 40mm from the end after preparation).
- 2 Volume by water displacement, densities given to nearest 10kg/m³.
- 3 Compressive strength values given to nearest 0.1MPa (N/mm²).
- 4 'Normal' (symmetrical failure) or otherwise as described.
- 5 BS EN 12504-1, National Annex NA - equivalent in-situ cube (no adjustment for direction of drilling)
 ND = Not determined. NA = Not applicable

Client	Edwards Diving Services Ltd Dragon House Sir Alfred Owen Way Pontygwindy Industrial Estate Caerphilly CF83 3HU	Signed	For Sandberg LLP
	For the attention of Mr Steve Richings		Name
	Reference	Order No. P8092/SR dated 2/11/2017	Position
		Date	16 November 2017

Materials, samples and test specimens are retained for a period of 2 months from the issue of this test certificate